


GEORGE T. DUNHAM
SURVEYING & SUBDIVIDING
DELAVER, WISCONSIN

GENEVA

STREET

N

Scale - 1" = 20'
O = Iron Pipe

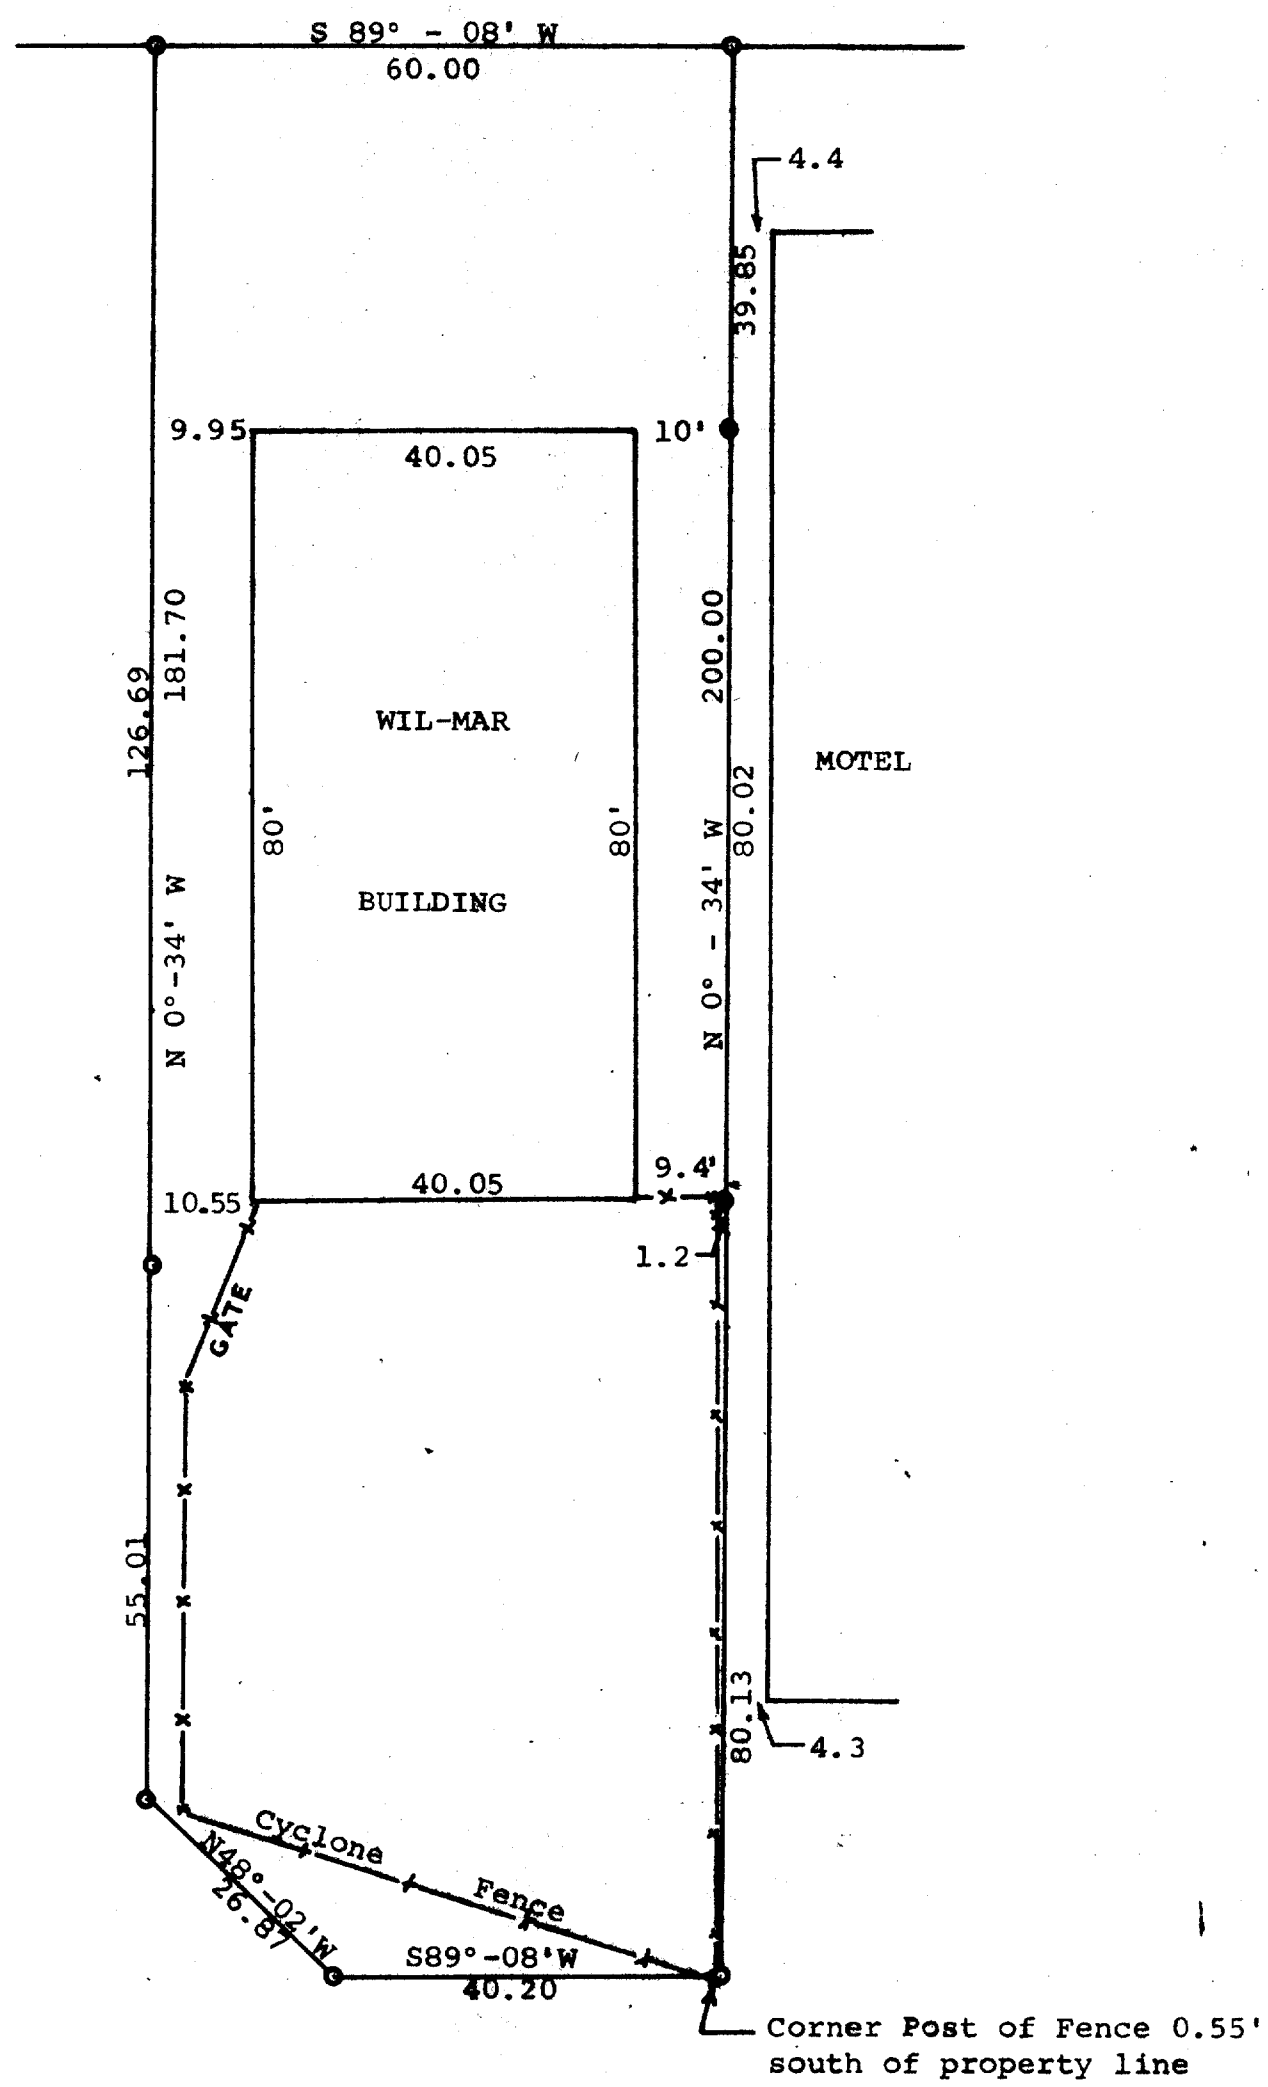

Plat of survey of Lot 3, Block 10, Allynhurst Subdivision
located in the City of Delavan, Walworth County, Wisconsin
August 20, 1965

George T. Dunham
George T. Dunham, Surveyor