


GEORGE T. DUNHAM
SURVEYING & SUBDIVIDING
DEHAVAN, WISCONSIN

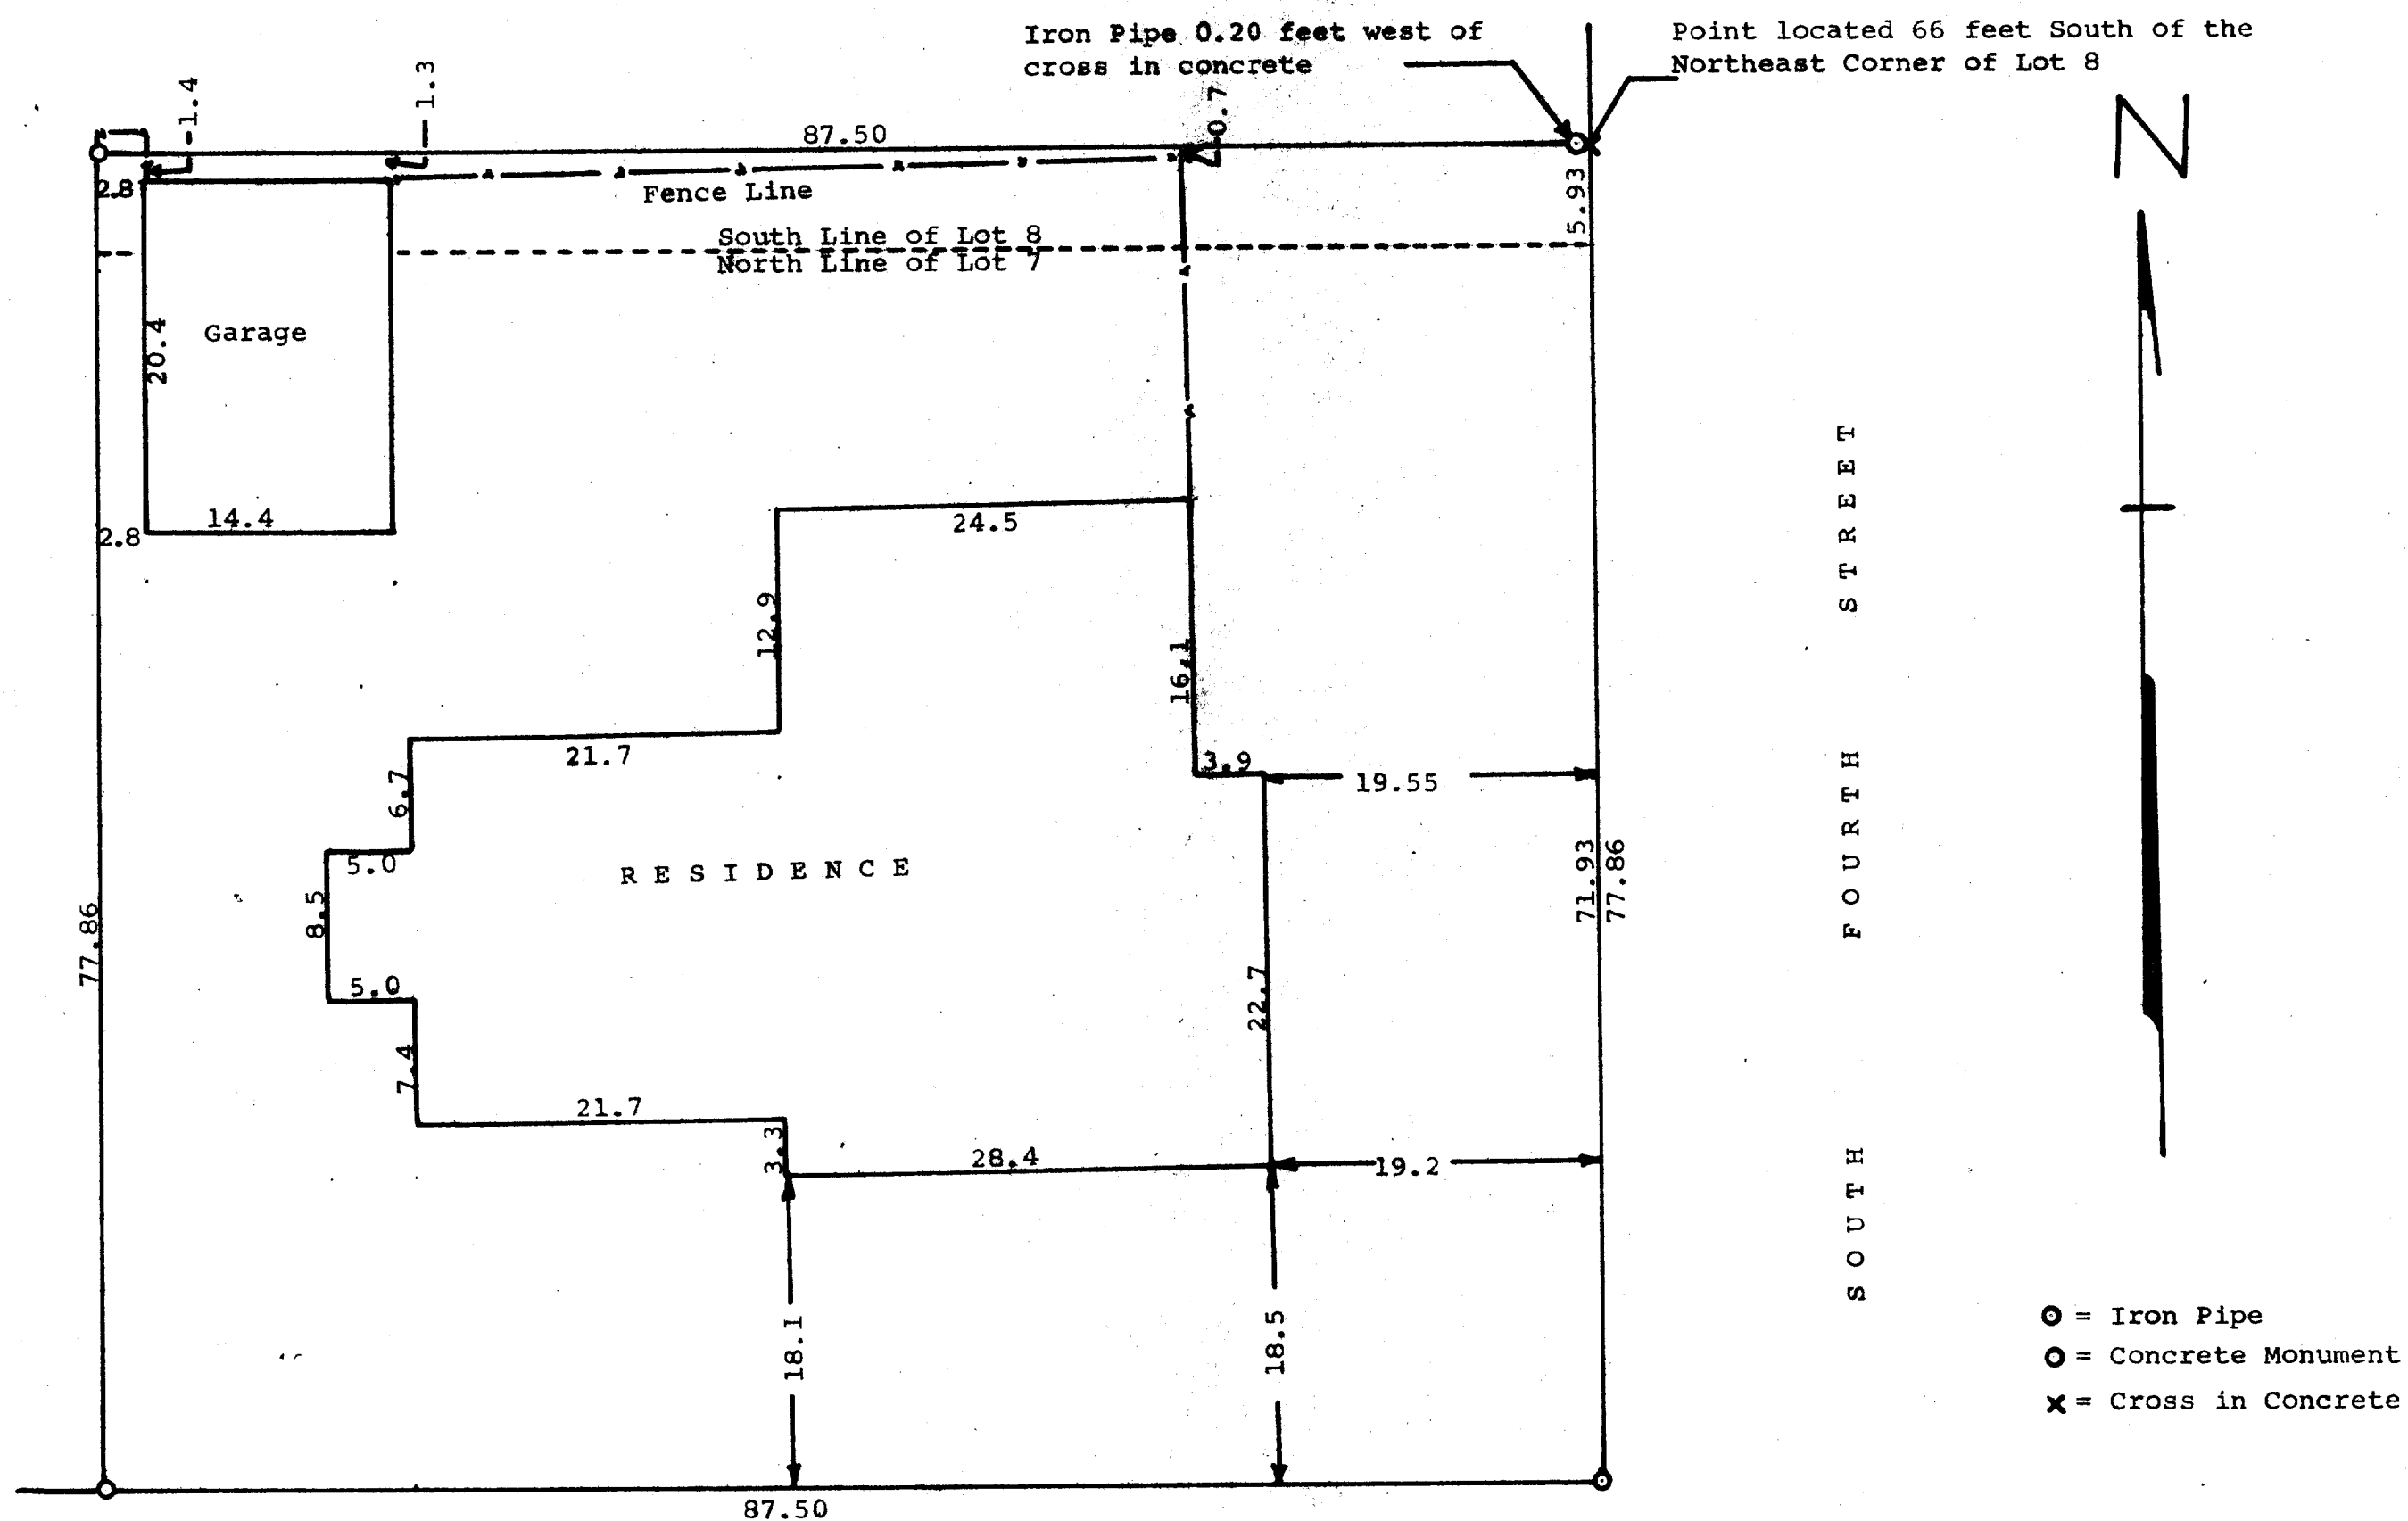

Plat of survey of a parcel of land described as follows:
All that part of Lots 7 and 8, in Block 18 of Ann Phoenix
Addition No. 1 to the Village, now City, of Delavan, described
as follows; Beginning at the Southeast corner of said Lot
7 and running thence North along the East line of said Lots
7 and 8, 77 feet more or less to a point 66 feet south of
the Northeast corner of said Lot 8; thence West parallel
with the south line of said Lots 87.50 feet; thence South
to the South line of said Lot 7; thence East along the
South line of said Lots 87.50 feet to the place of beginning.
September 10, 1965

George T. Dunham
George T. Dunham, Surveyor