


GEORGE T. DUNHAM
SURVEYING & SUBDIVIDING
DELAVER, WISCONSIN

WALWORTH AVENUE

Northwest Corner of Lot 2, Block 11
Original Plat of the Village, (Now City)
of Delavan

South Third Street

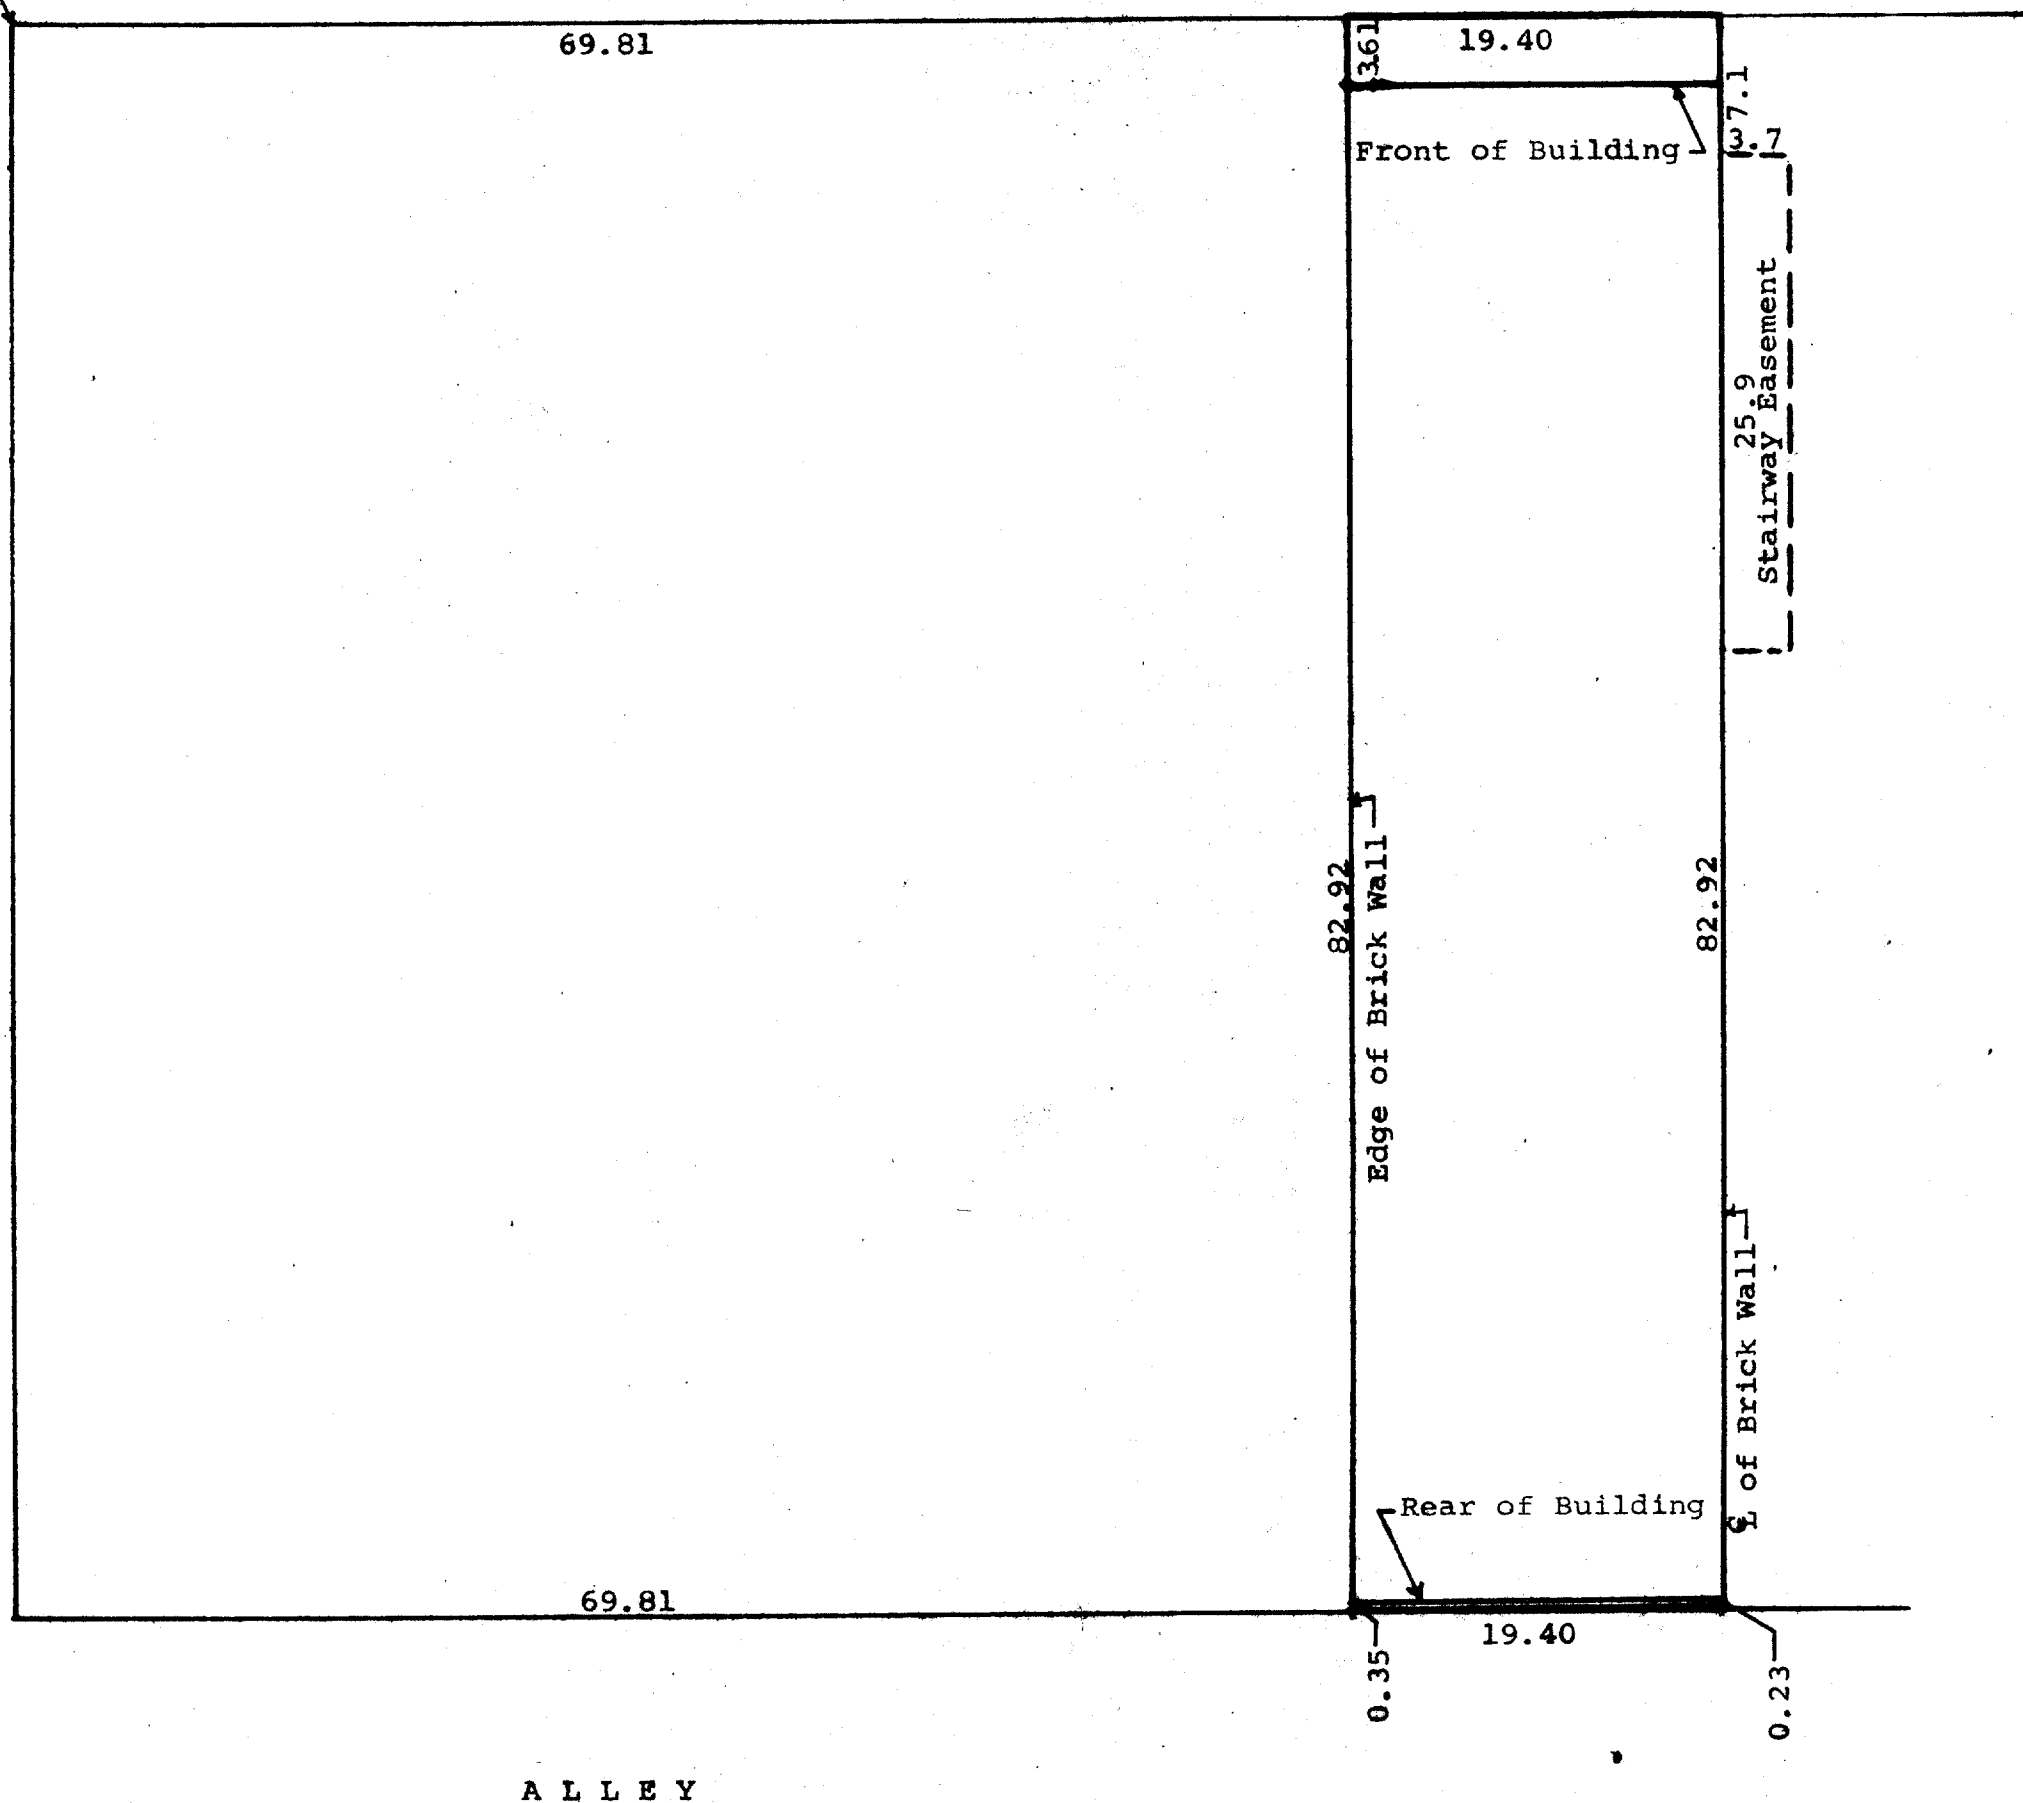

ALLEY



Scale - 1" = 10'

STATE OF WISCONSIN)
WALWORTH COUNTY) ss

I, George T. Dunham, Surveyor, do hereby certify that
I have surveyed the property described as follows,

A parcel of land located in Lots 1 and 2, Block 11 of
the Original Plat of the Village of Delavan, Walworth
County, Wisconsin described as follows, to-wit:
Beginning on the north line of said Lot 2 at a point
located 69.81 feet East of the northwest corner of
said Lot 2; thence South parallel with the west line
of said Block 82.92 feet to the north line of an alley;
thence East parallel with the north line of said Block
11, 19.40 feet to the centerline of a brick wall;
thence North along the centerline of said brick wall
82.92 feet; thence West along the north line of said
Block 11, 19.40 feet to the place of beginning. Subject
to a stairway easement reserved in W. Deed heretofore
and on May 1, 1920 given by Timothy Dows and Wife to
H. D. Lackey, said deed being recorded in the Office of
the Register of Deeds in and for Walworth County, Wis.
in Vol. 161 of Deeds on Page 152.

and that the above plat is an accurate survey and a true representation
thereof and correctly shows the exterior boundary lines and the
location of the building on said property.
July 13, 1965

George T. Dunham
George T. Dunham, Surveyor