


GEORGE T. DUNHAM
SURVEYING & SUBDIVIDING
DELAVER, WISCONSIN



Scale - 1" = 20'
○ = Iron Pipe
● = Concrete Monument

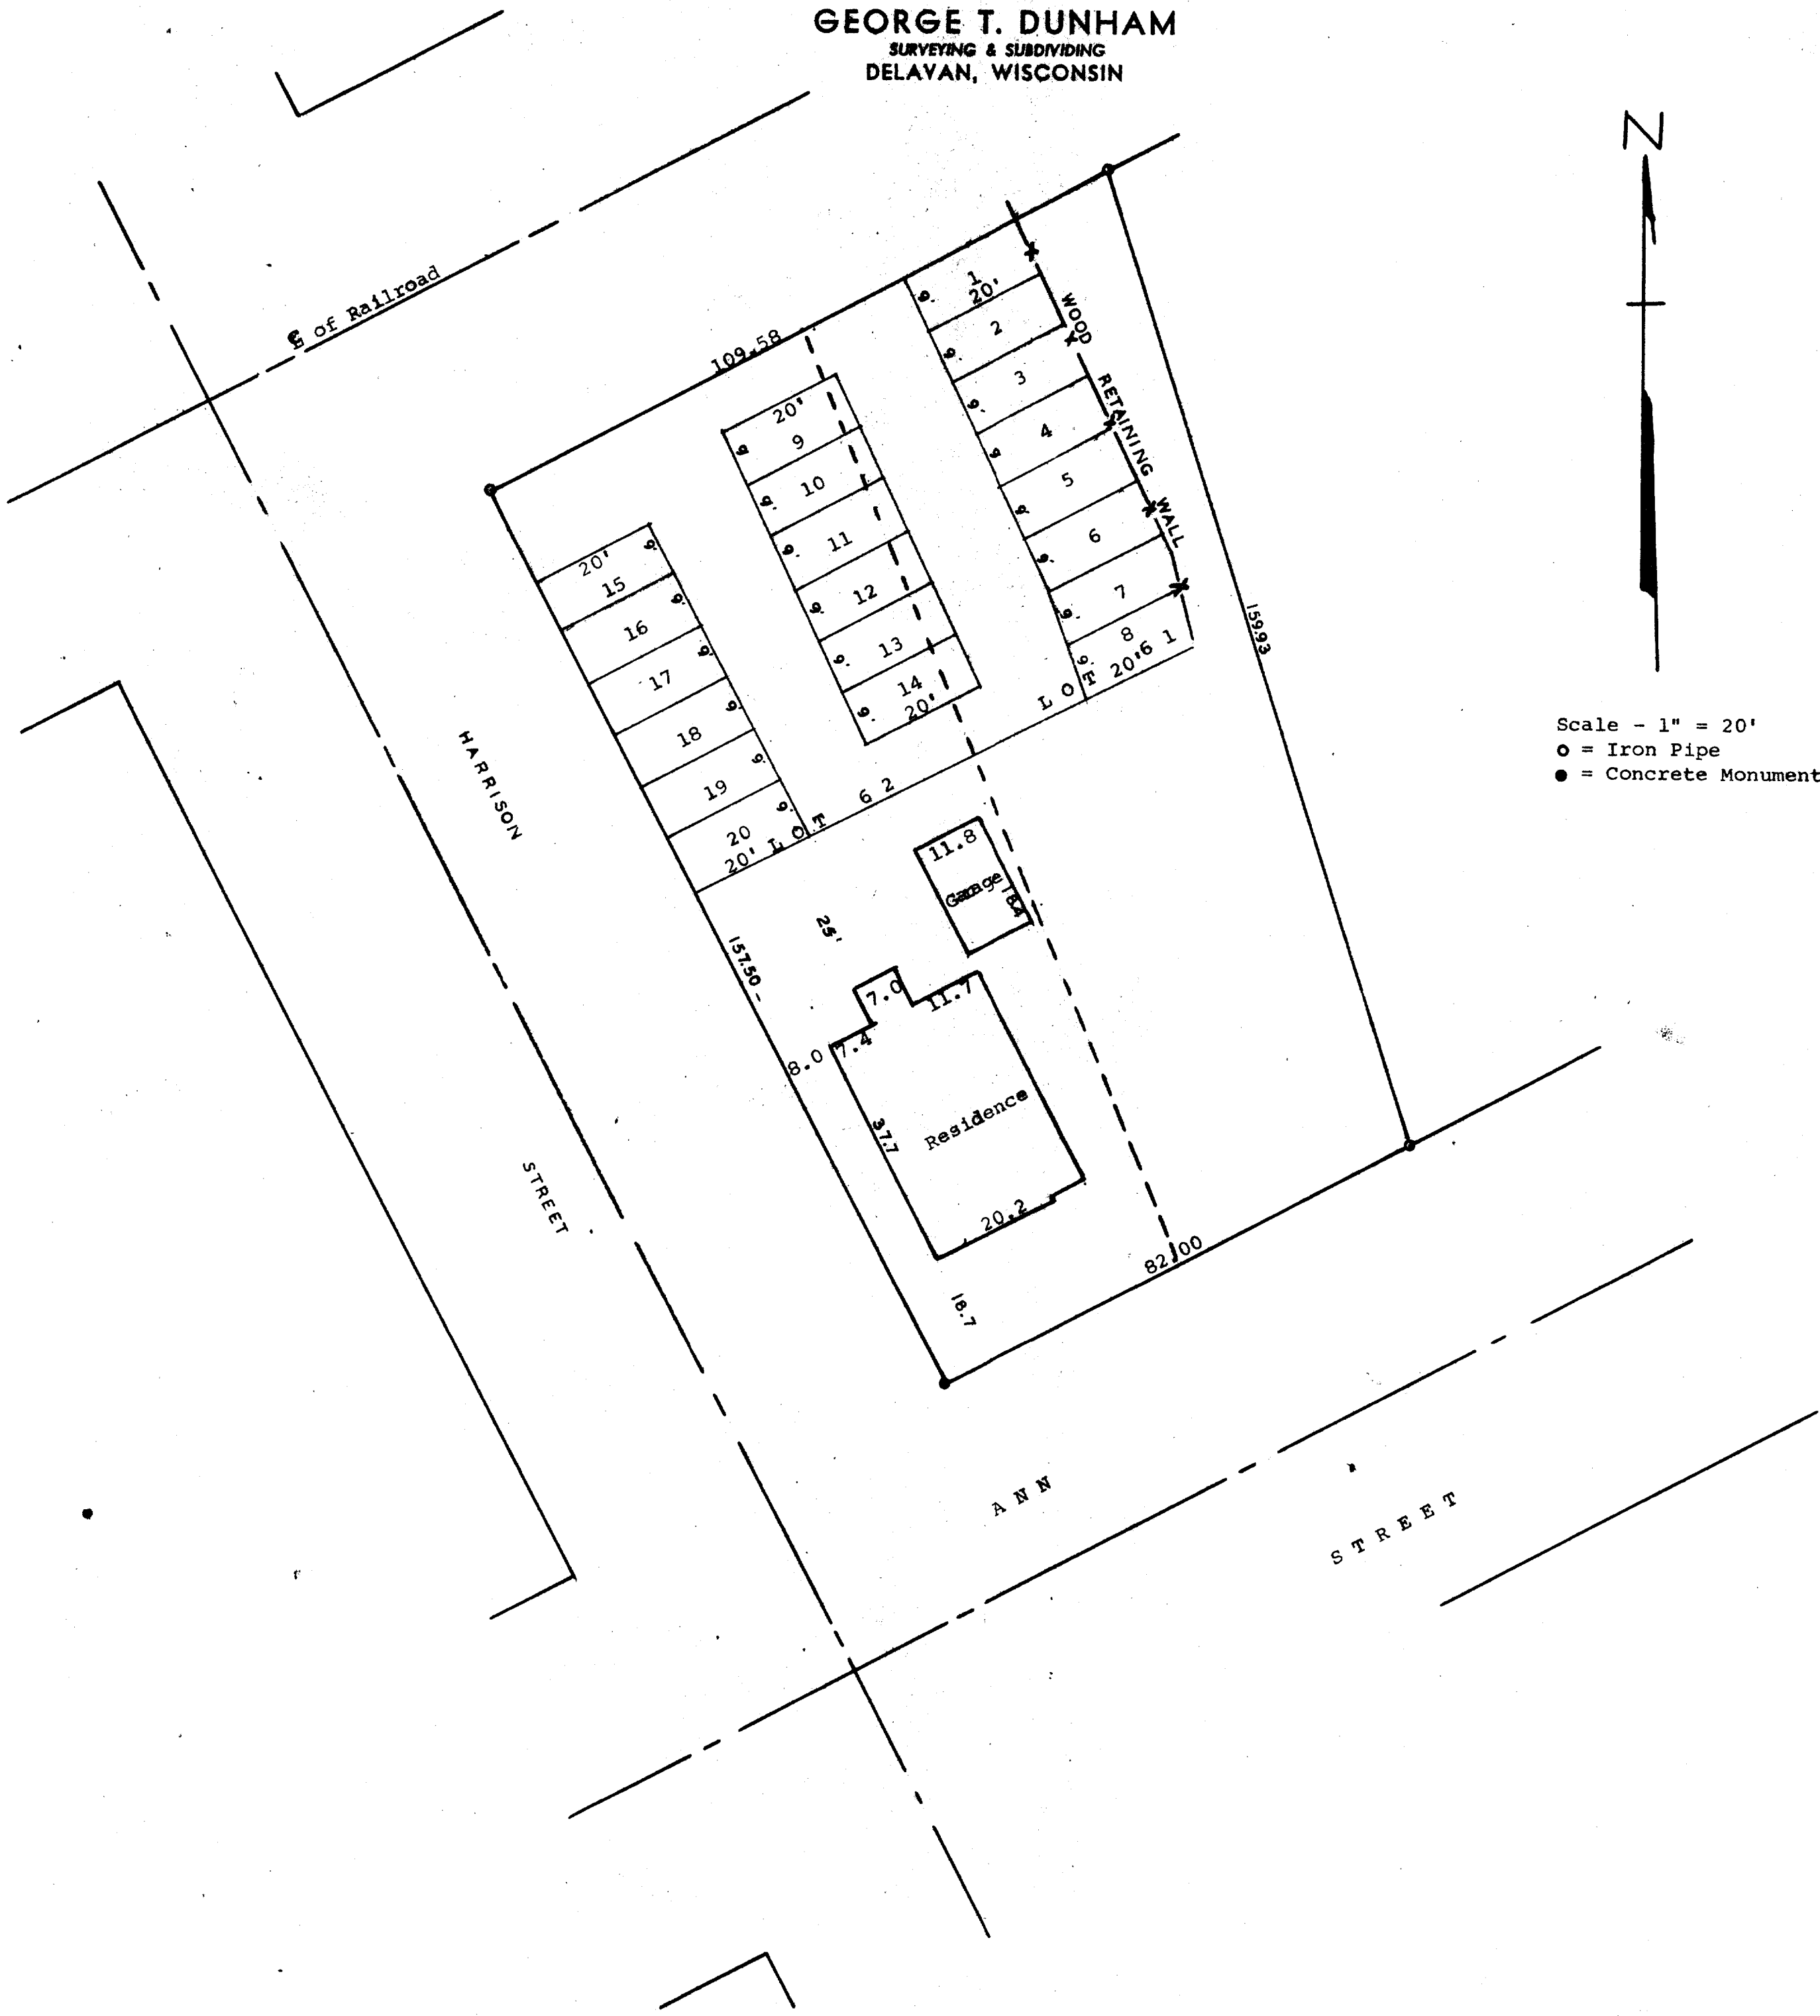

Plat of survey of Lots 61 and 62 of Tyrrell's
Subdivision located in the City of Delavan,
Walworth County, Wisconsin
May 28, 1965

George T. Dunham
George T. Dunham, Surveyor