



PLAT OF SURVEY & TOPOGRAPHIC MAPPING
LOTS 1 & 2 OF BLOCK 15 OF ALLYNHURST ADDITION NO. 2, A SUBDIVISION
LOCATED IN PART OF THE NE 1/4 OF THE NW 1/4 OF SECTION 20, TOWN 2 NORTH, RANGE 16 EAST, CITY OF DELAVAN, WALWORTH COUNTY, WISCONSIN

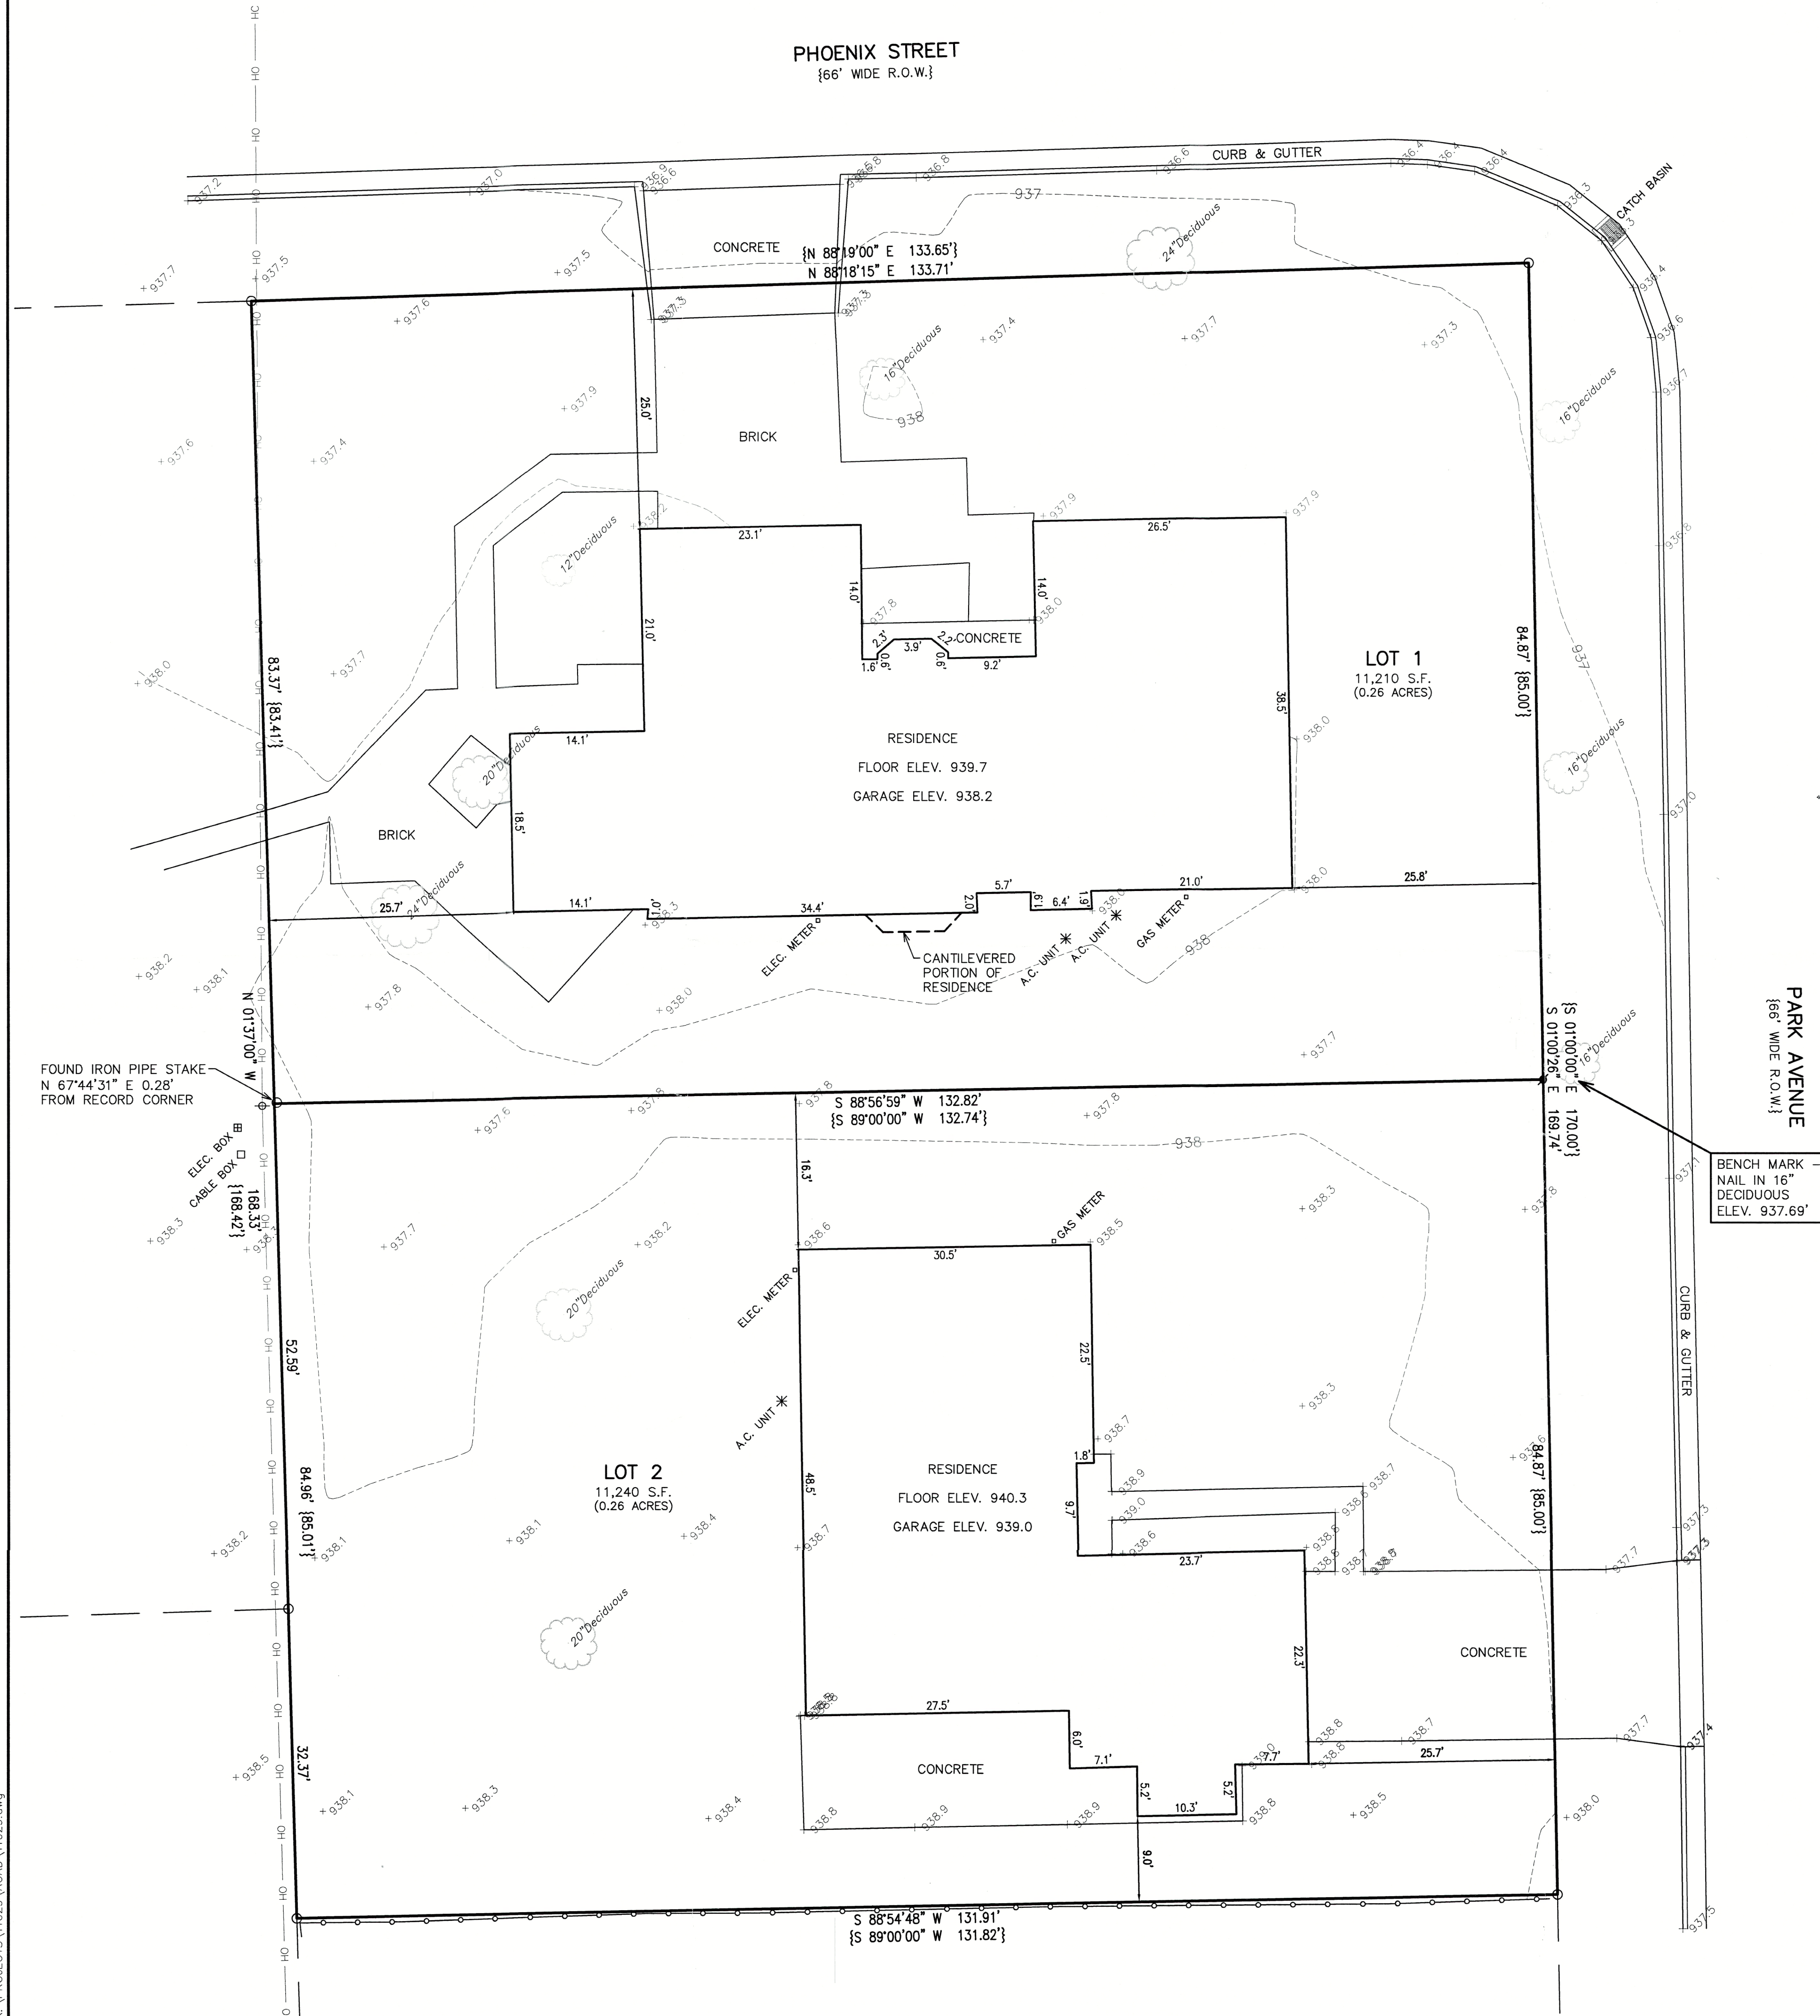

- LEGEND
- O = FOUND IRON PIPE STAKE
 - = SET IRON REBAR STAKE
 - ⊕ = UTILITY POLE LOCATED
 - = CHAINLINK FENCE LOCATED
 - OH— = OVERHEAD WIRES
 - {XXX} = RECORDED AS


NOTE: COPIES OF THIS MAP TO WHICH THE FOLLOWING CERTIFICATE WILL APPLY SHOW THE SURVEYOR'S ORIGINAL SEAL AND SIGNATURE IN RED INK. COPIES BY ANY OTHER MEANS MAY HAVE ALTERATIONS WHICH DO NOT REPRESENT THE SURVEYOR'S WORK PRODUCT.

I HEREBY CERTIFY THAT THE ABOVE DESCRIBED PROPERTY HAS BEEN SURVEYED UNDER MY DIRECTION AND THAT THE ABOVE MAP IS A TRUE REPRESENTATION THEREOF AND SHOWS THE SIZE AND LOCATION OF THE PROPERTY AND ITS EXTERIOR BOUNDARIES. THIS SURVEY IS MADE FOR THE USE OF THE PRESENT OWNERS OF THE PROPERTY, AND ALSO THOSE WHO PURCHASE, MORTGAGE, OR GUARANTEE THE TITLE THERETO WITHIN ONE YEAR FROM THE DATE HEREOF. FIELD WORK WAS CONDUCTED 4/26/2024.

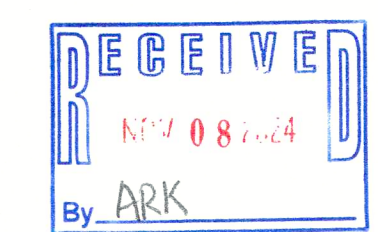

DATED: 5/9/2024

CHRISTOPHER A. HODGES P.L.S. 2760

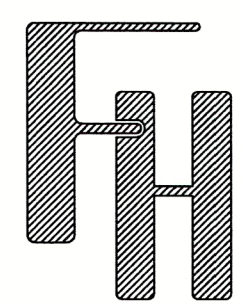

TOPOGRAPHIC SURVEY
608 PARK AVENUE & 1080 PHOENIX STREET
DELAVER, WISCONSIN

WORK ORDERED BY -
JEFFERY SCHERER
1080 PHOENIX STREET
DELAVER, WI 53115

FARRIS, HANSEN & ASSOCIATES, INC.
ENGINEERING - ARCHITECTURE - SURVEYING
7 RIDGWAY COURT P.O. BOX 437
ELKHORN, WISCONSIN 53121
PHONE: (262) 723-2098 e-mail: office@farris-hansen.com

REVISIONS

PROJECT NO.
11029

DATE
05/09/2024

SHEET NO.
1 OF 1