


●	Iron Rebar Set
	3/4" x 24"(1.5 Lbs./Ft.)
⦿	3/4" Iron Rebar Found, unless noted
⊙	Iron Pipe Found
✕	Cut Cross Found
—————	Existing Boundary Line
- - - - -	Existing Adjacent Property
(XXX.XX)	Record Information
—— X ——	Existing Fence
—— OH ——	Existing Overhead Power
⌀	Existing Utility Pole

OF LOT 14, BLOCK 20, PASSAGE, ARAM, & DOWNIE SUBDIVISION,
CITY OF DELAVAN, WALWORTH COUNTY, WISCONSIN.

1. SURVEYED PROPERTY SUBJECT TO ANY AND ALL EASEMENTS AND AGREEMENTS RECORDED AND UNRECORDED.
2. THIS SURVEY IS A RETRACEMENT OF A PLAT OF SURVEY BY ANDERSON LAND SURVEYING DATED APRIL 21, 1980 AS JOB NO. 780.

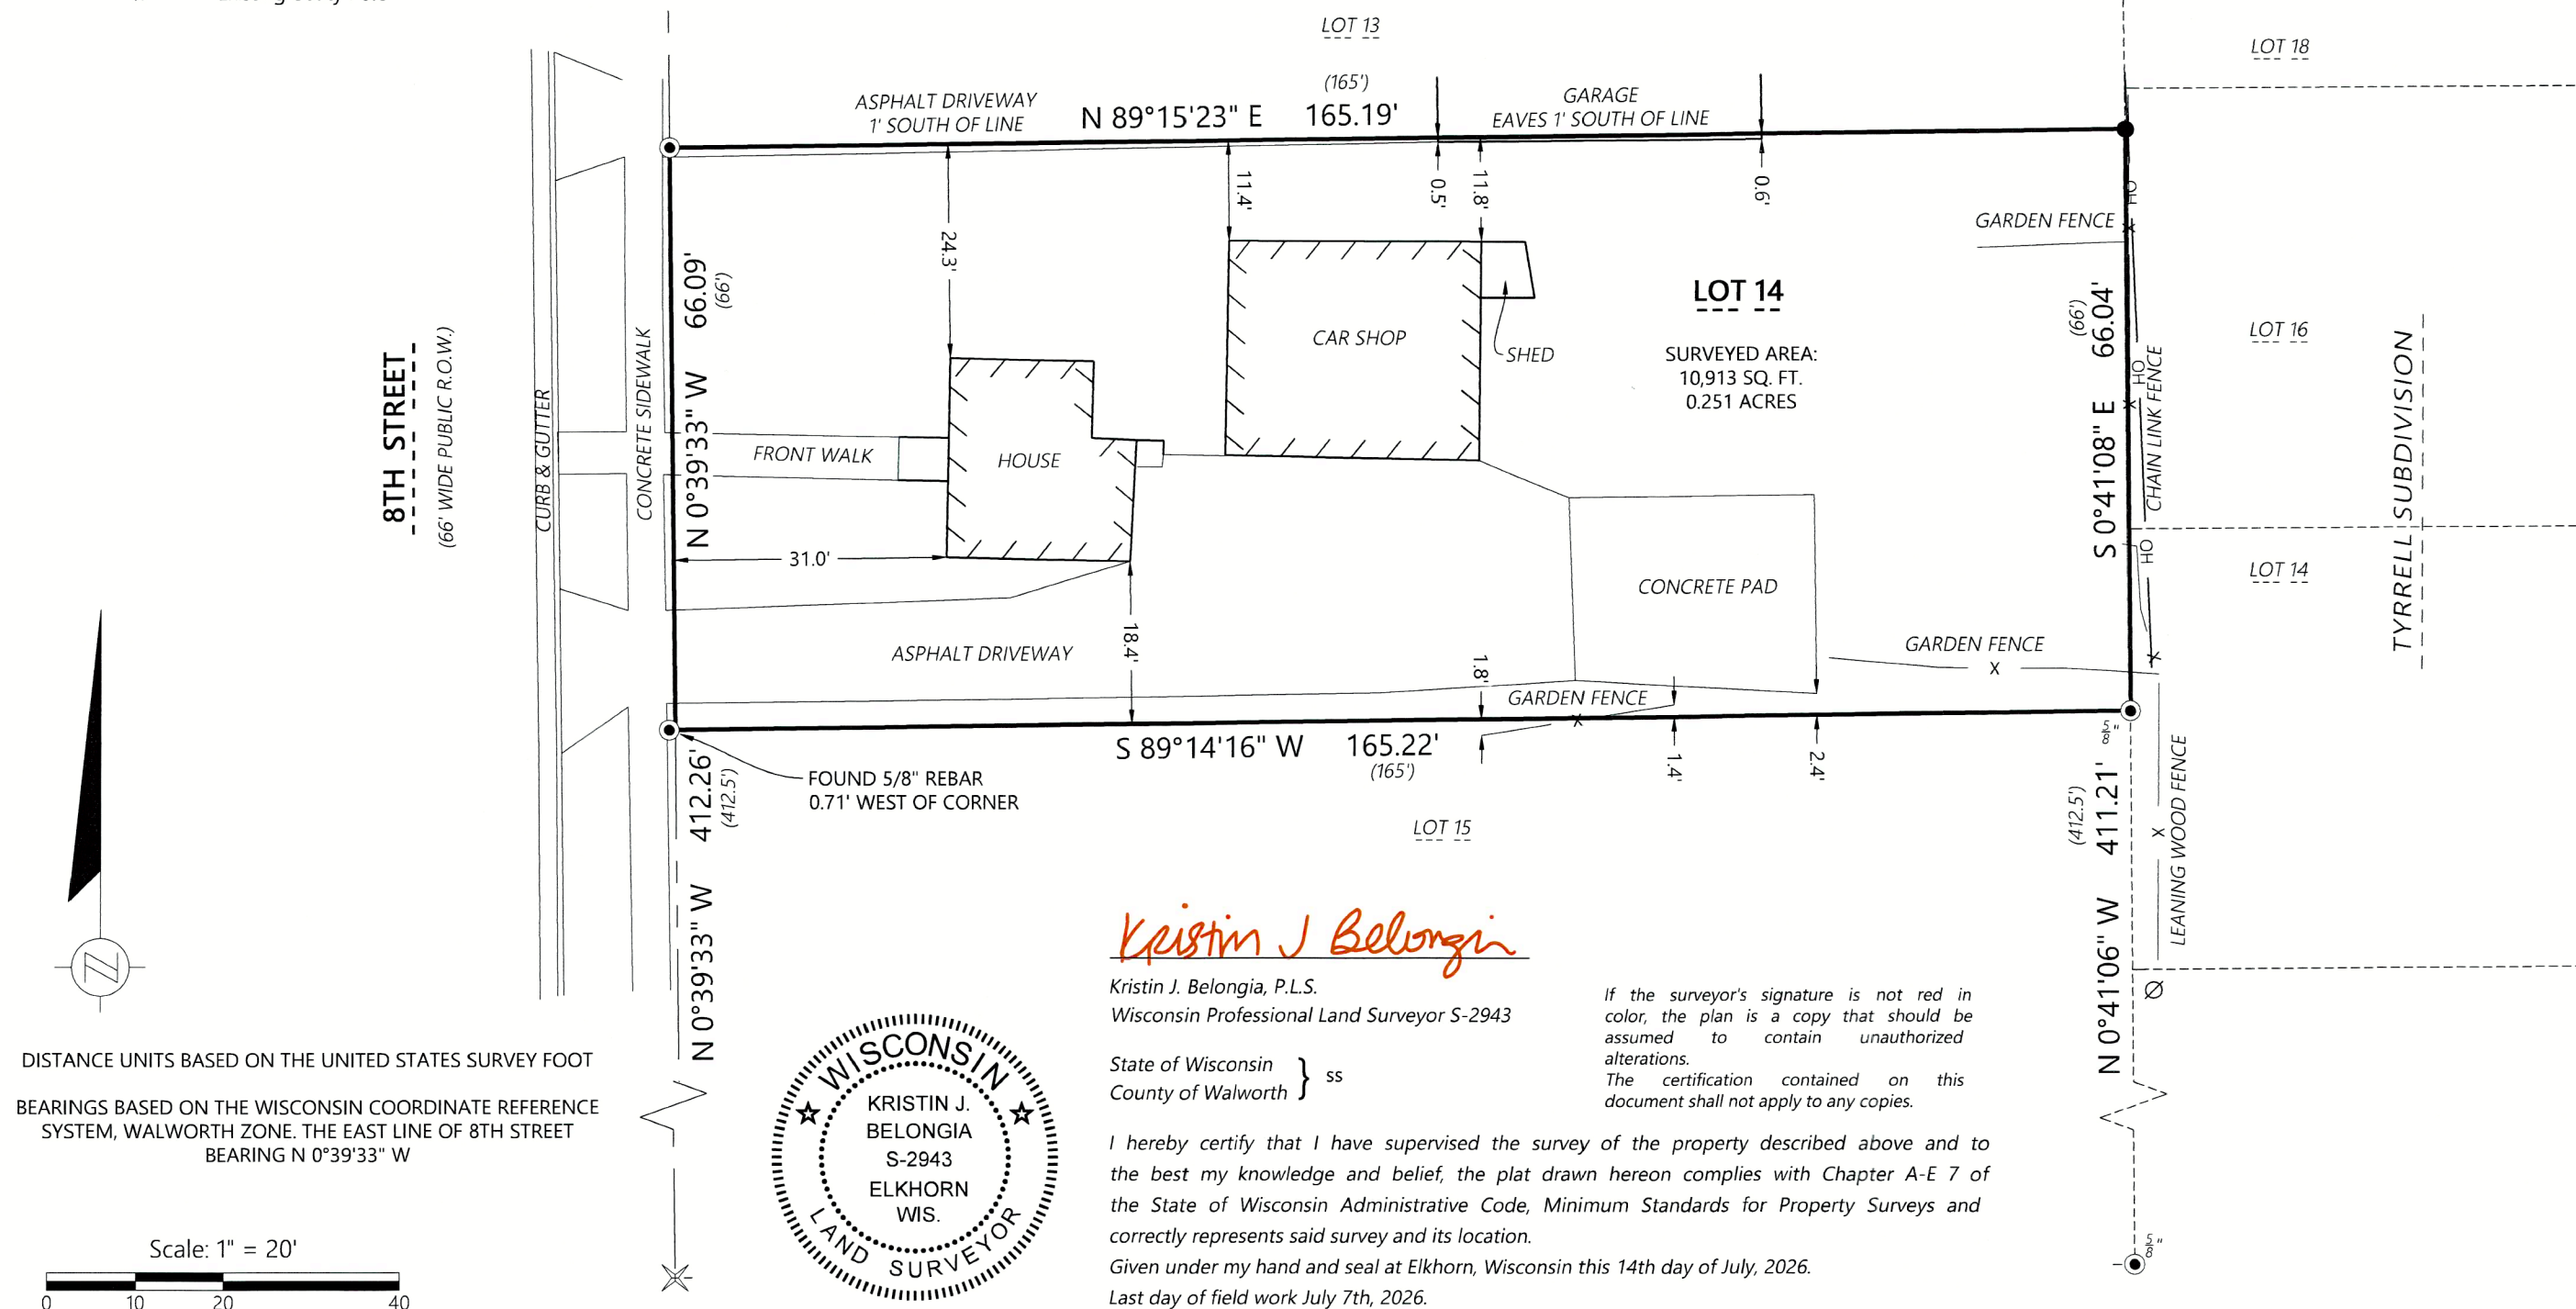

ORDER NO: 36020 FIELD CREW: ZWA DRAWN BY: ZWA SHEET 1 OF 1	FOR THE EXCLUSIVE USE OF: TIMOTHY MARK HANSSEN, II W4555 REMER RD ELKHORN, WI 53121	PLAT OF SURVEY	 Batterman SURVEYING & ENGINEERING BELLOIT/ELKHORN/FANESVILLE 2857 S. Bartells Dr., Beloit, WI 53511 608.365.4464 www.cbatterman.com
--	---	-----------------------	---

XP-224

002-2994