


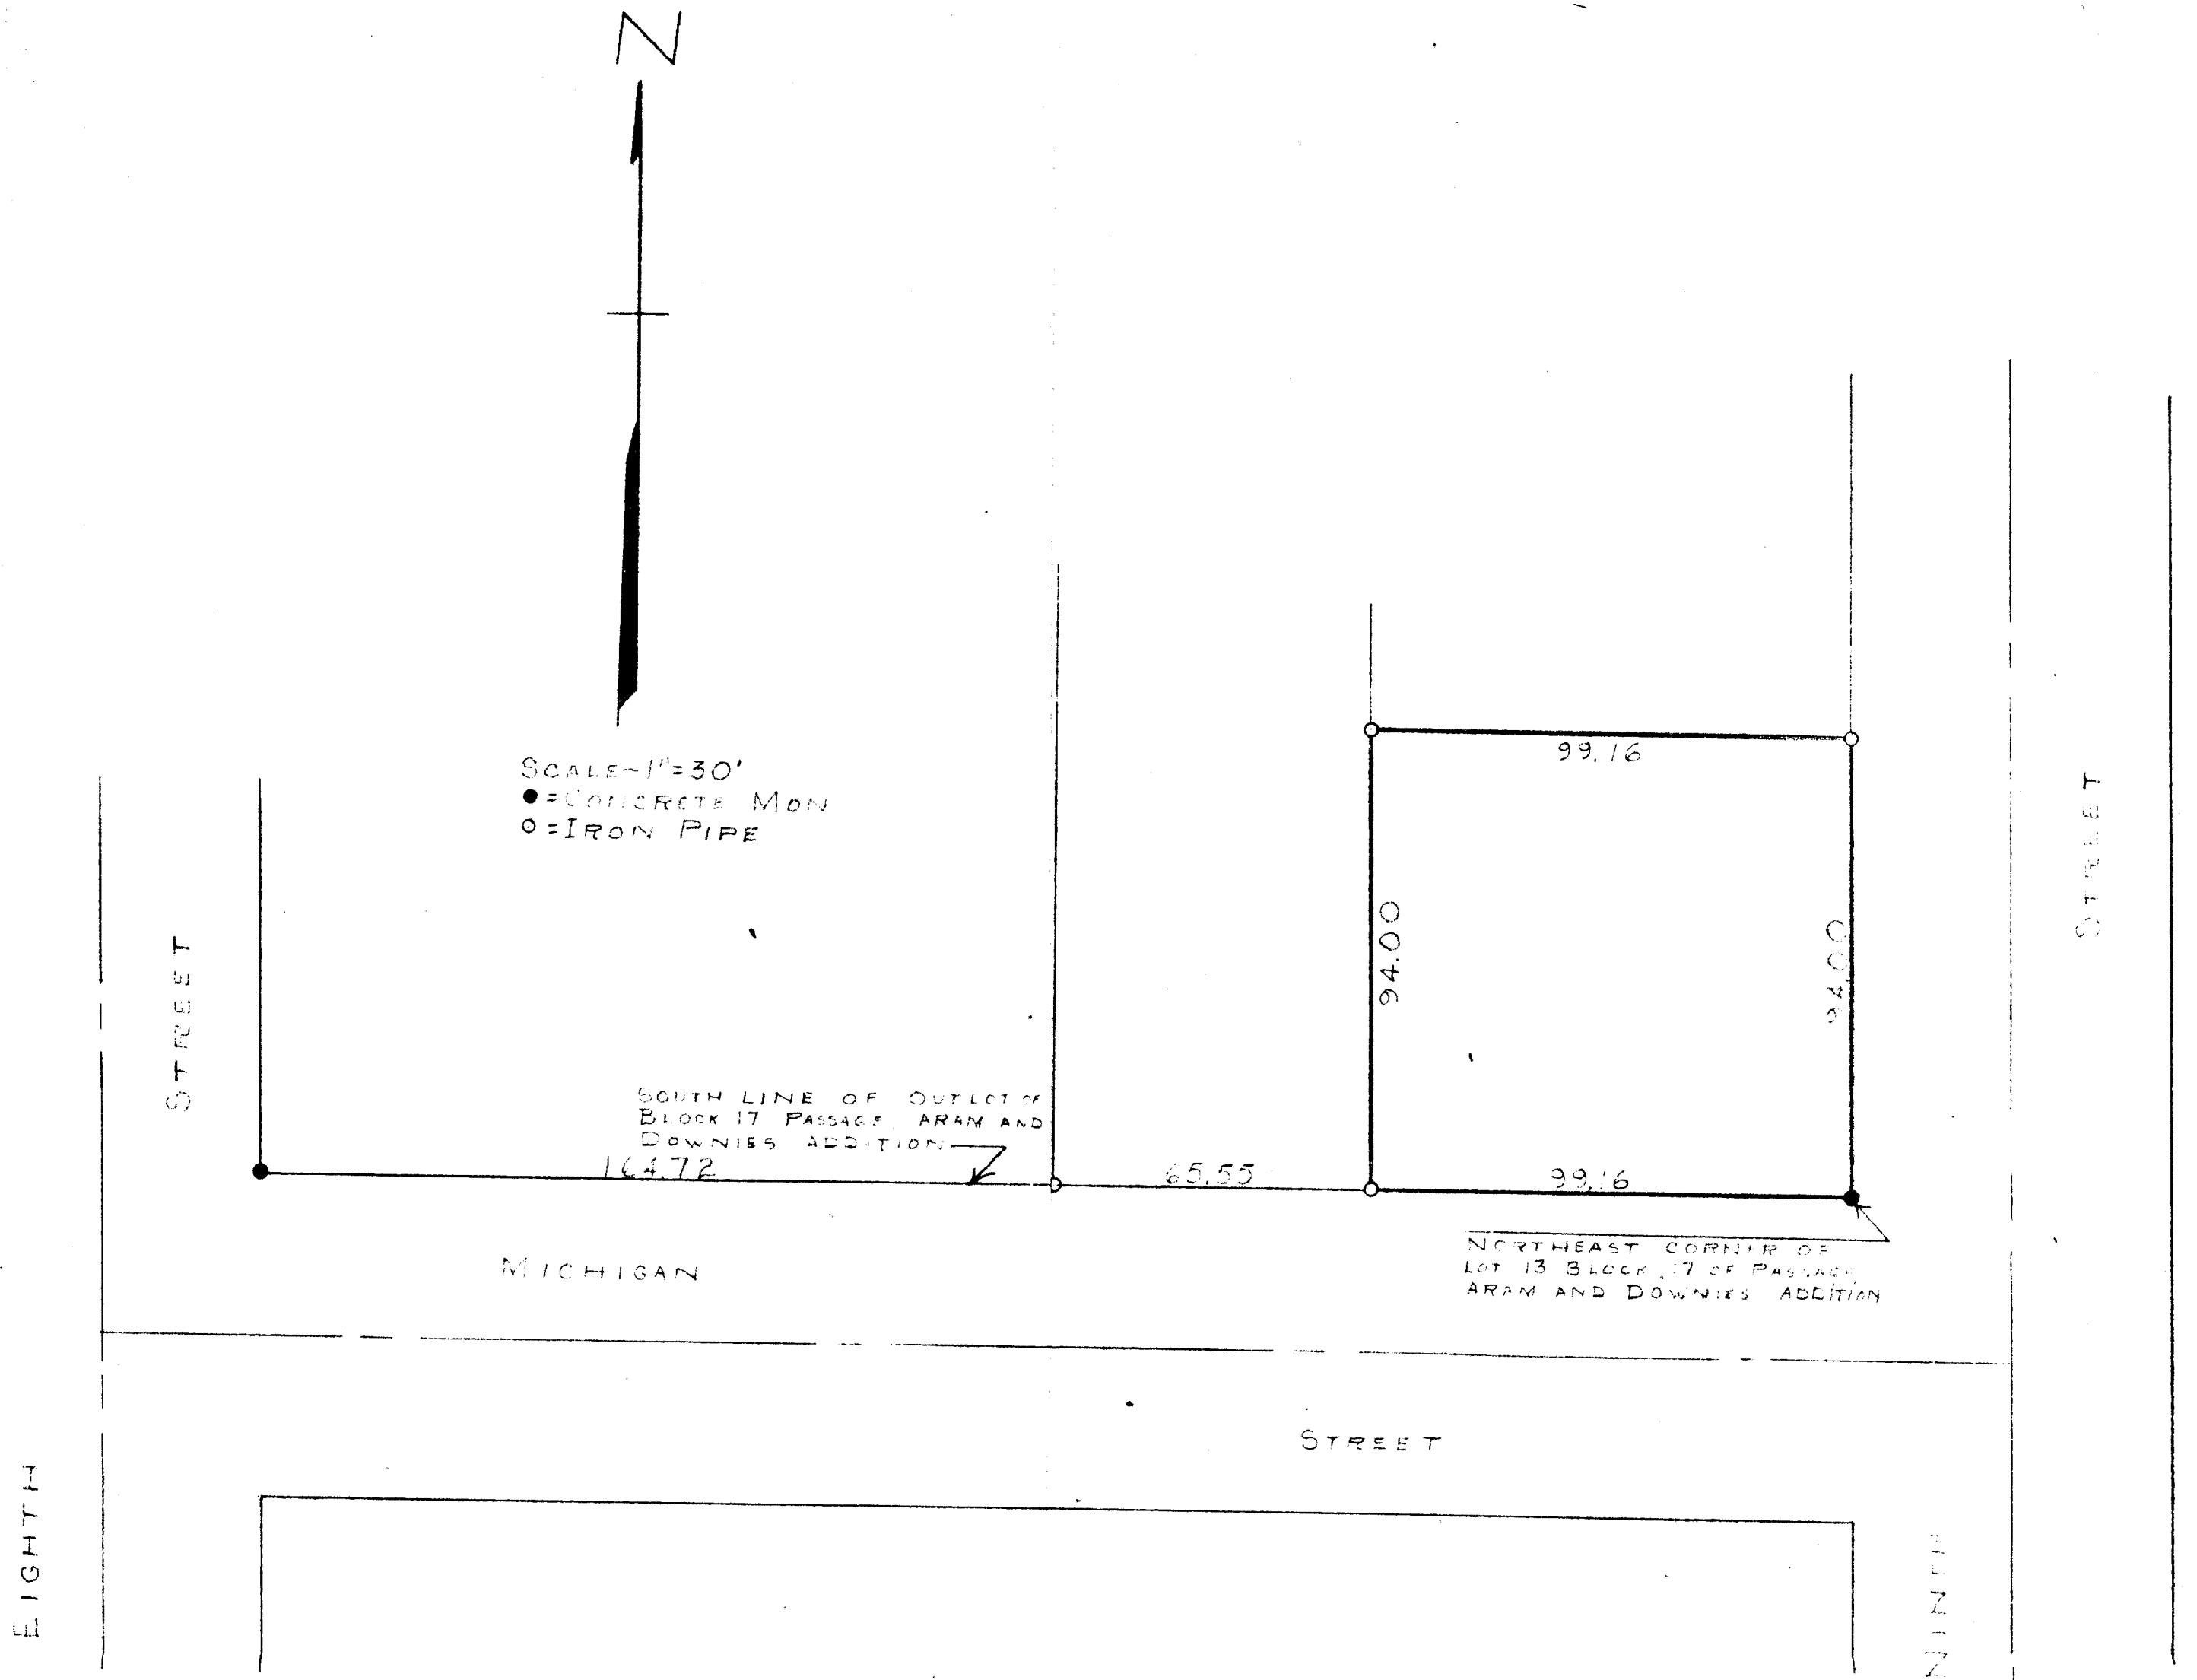

PLAT OF SURVEY OF A PARCEL OF LAND LOCATED IN OUTLOT OF
BLOCK 17 OF PASSAGE ARAM AND DOWNIES ADDITION TO THE VILLAGE
(NOW CITY) OF DELAVAN, WALWORTH COUNTY, WISCONSIN
JULY 15, 1953

George T. Dunham
GEORGE T. DUNHAM
DELAHAN WISCONSIN
SURVEYOR

2-3 ✓