


GEORGE T. DUNHAM  
SURVEYING & SUBDIVIDING  
DELAVER, WISCONSIN

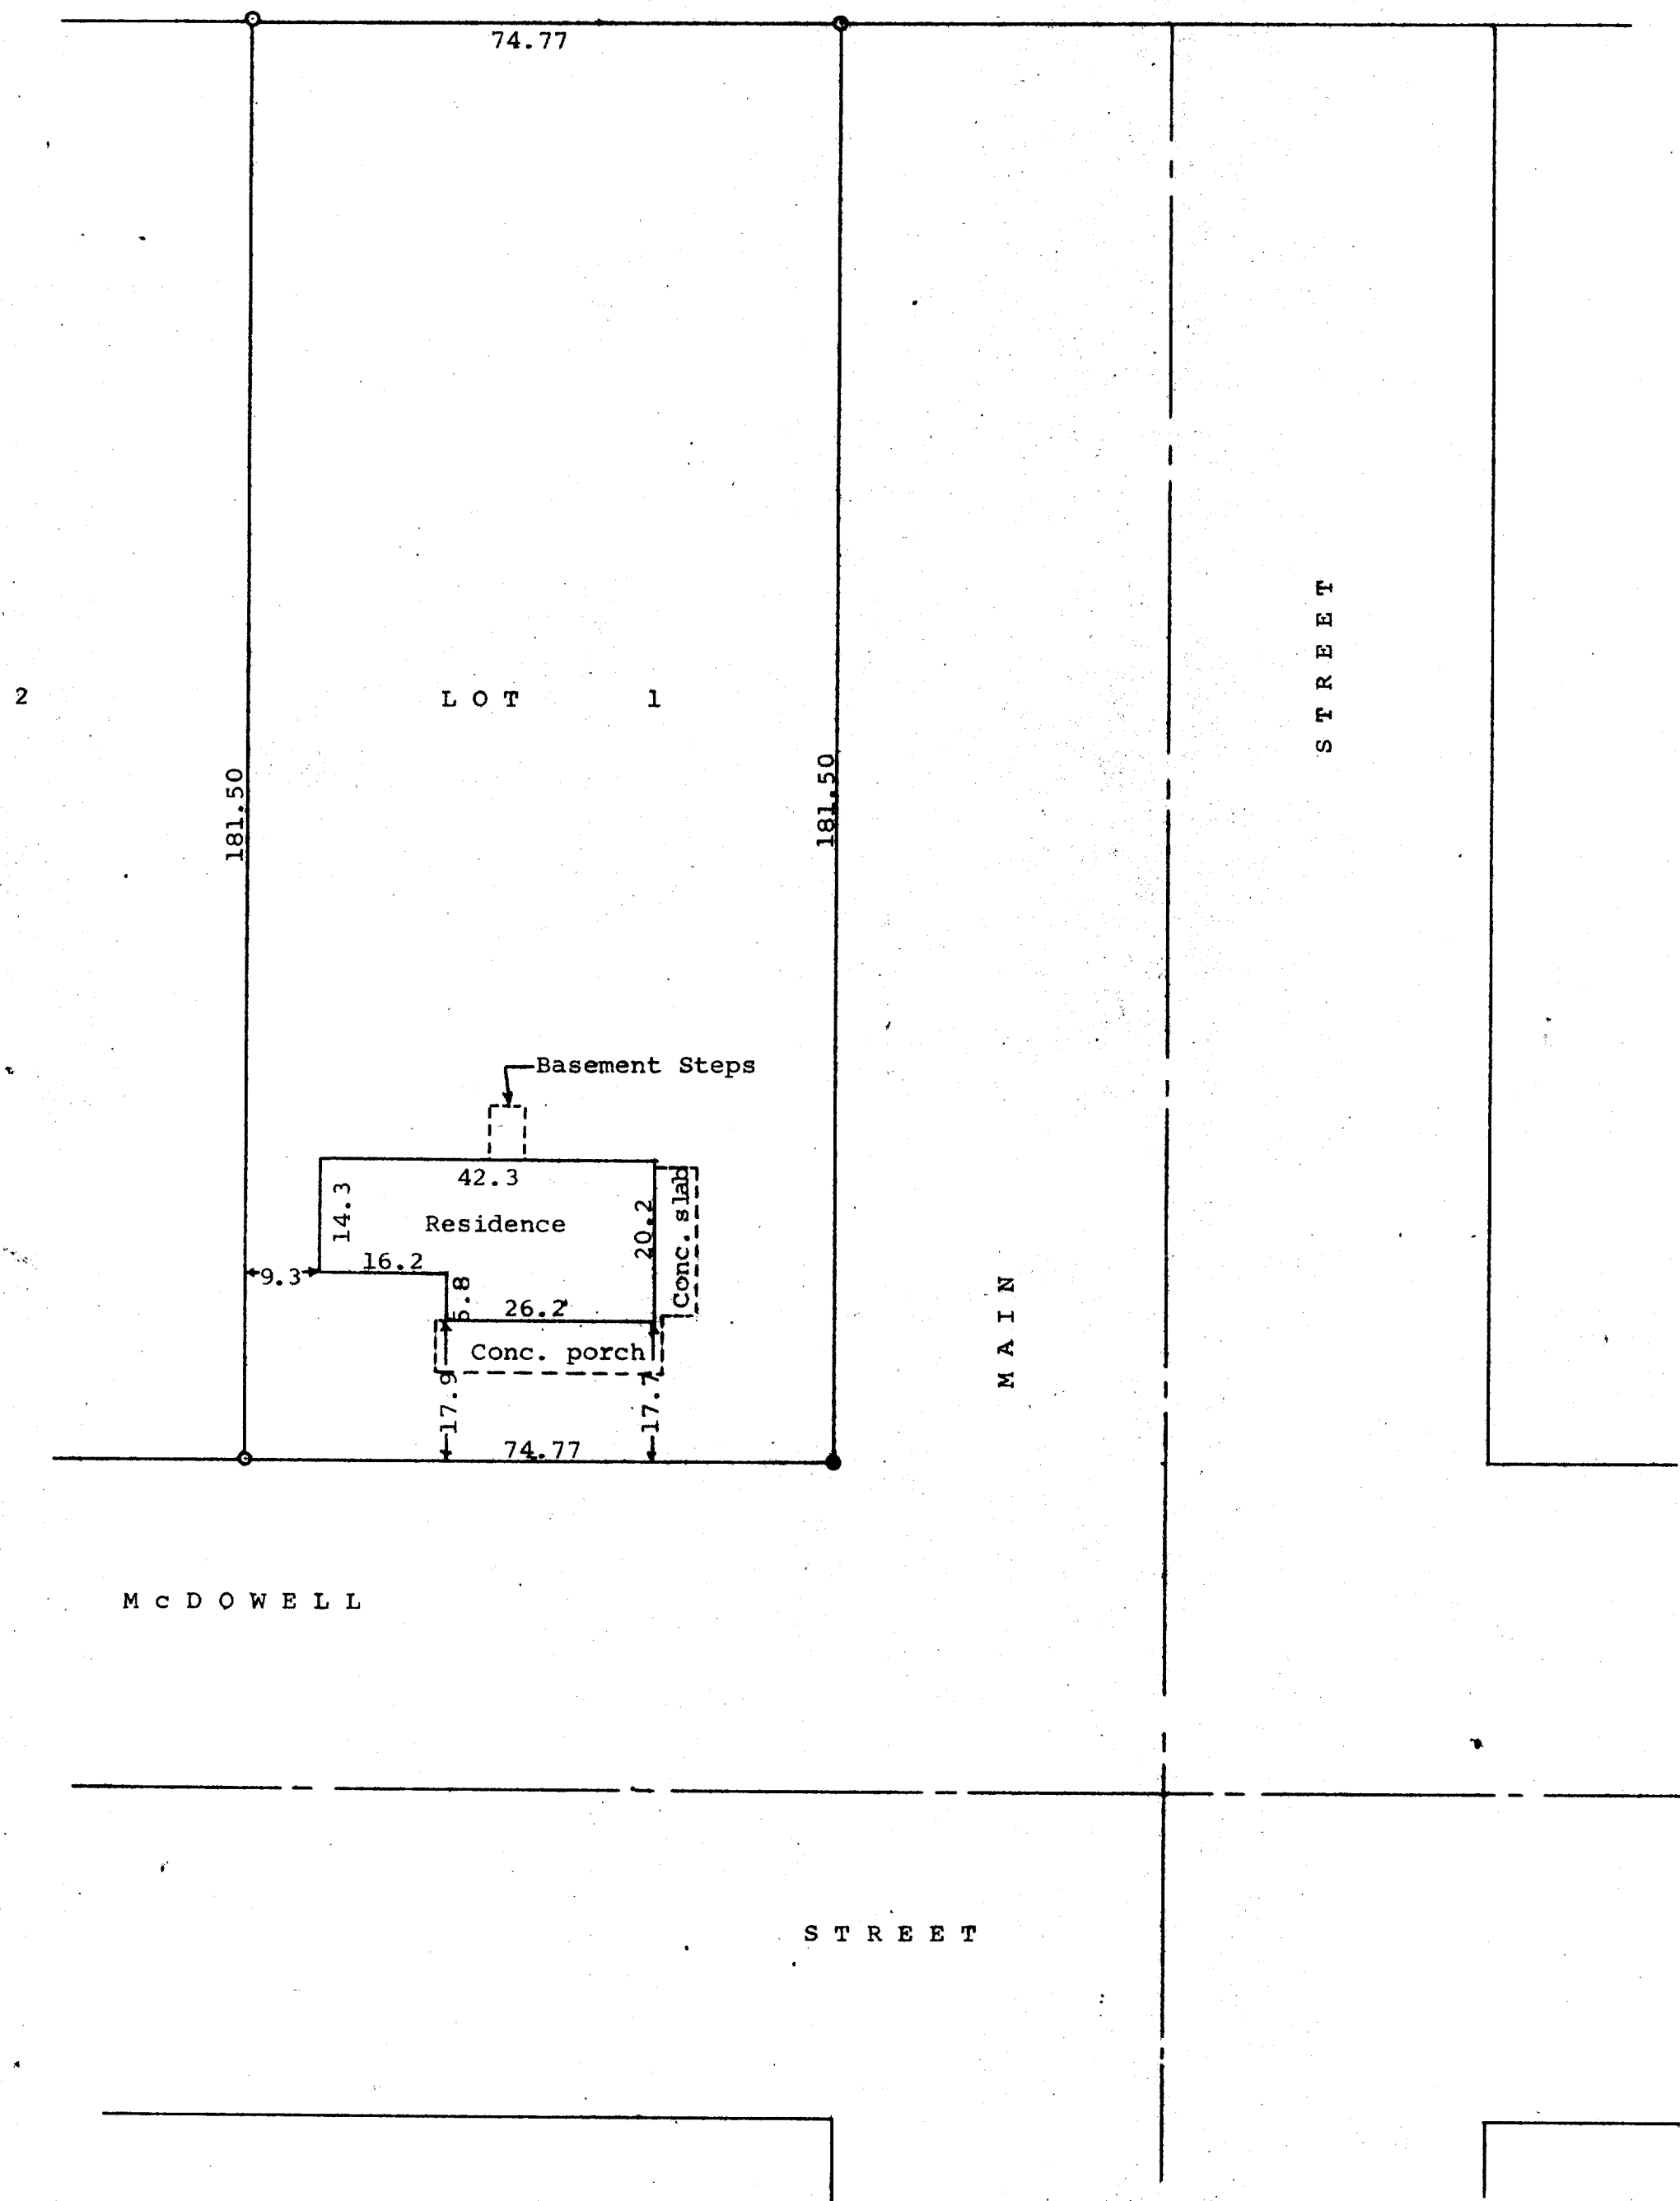

Scale - 1" = 20'  
○ = Iron Pipe  
● = Concrete Monument

Plat of survey of Lot 1 in Block 4 of the Original Town  
(Now City) of Delavan, Walworth County, Wisconsin  
September 22, 1966

*George T. Dunham*  
George T. Dunham, Surveyor