


GEORGE T. DUNHAM
SURVEYING & SUBDIVIDING
DELAVER, WISCONSIN



Scale - 1" = 20'
○ = Iron Pipe
X = Cross in Concrete

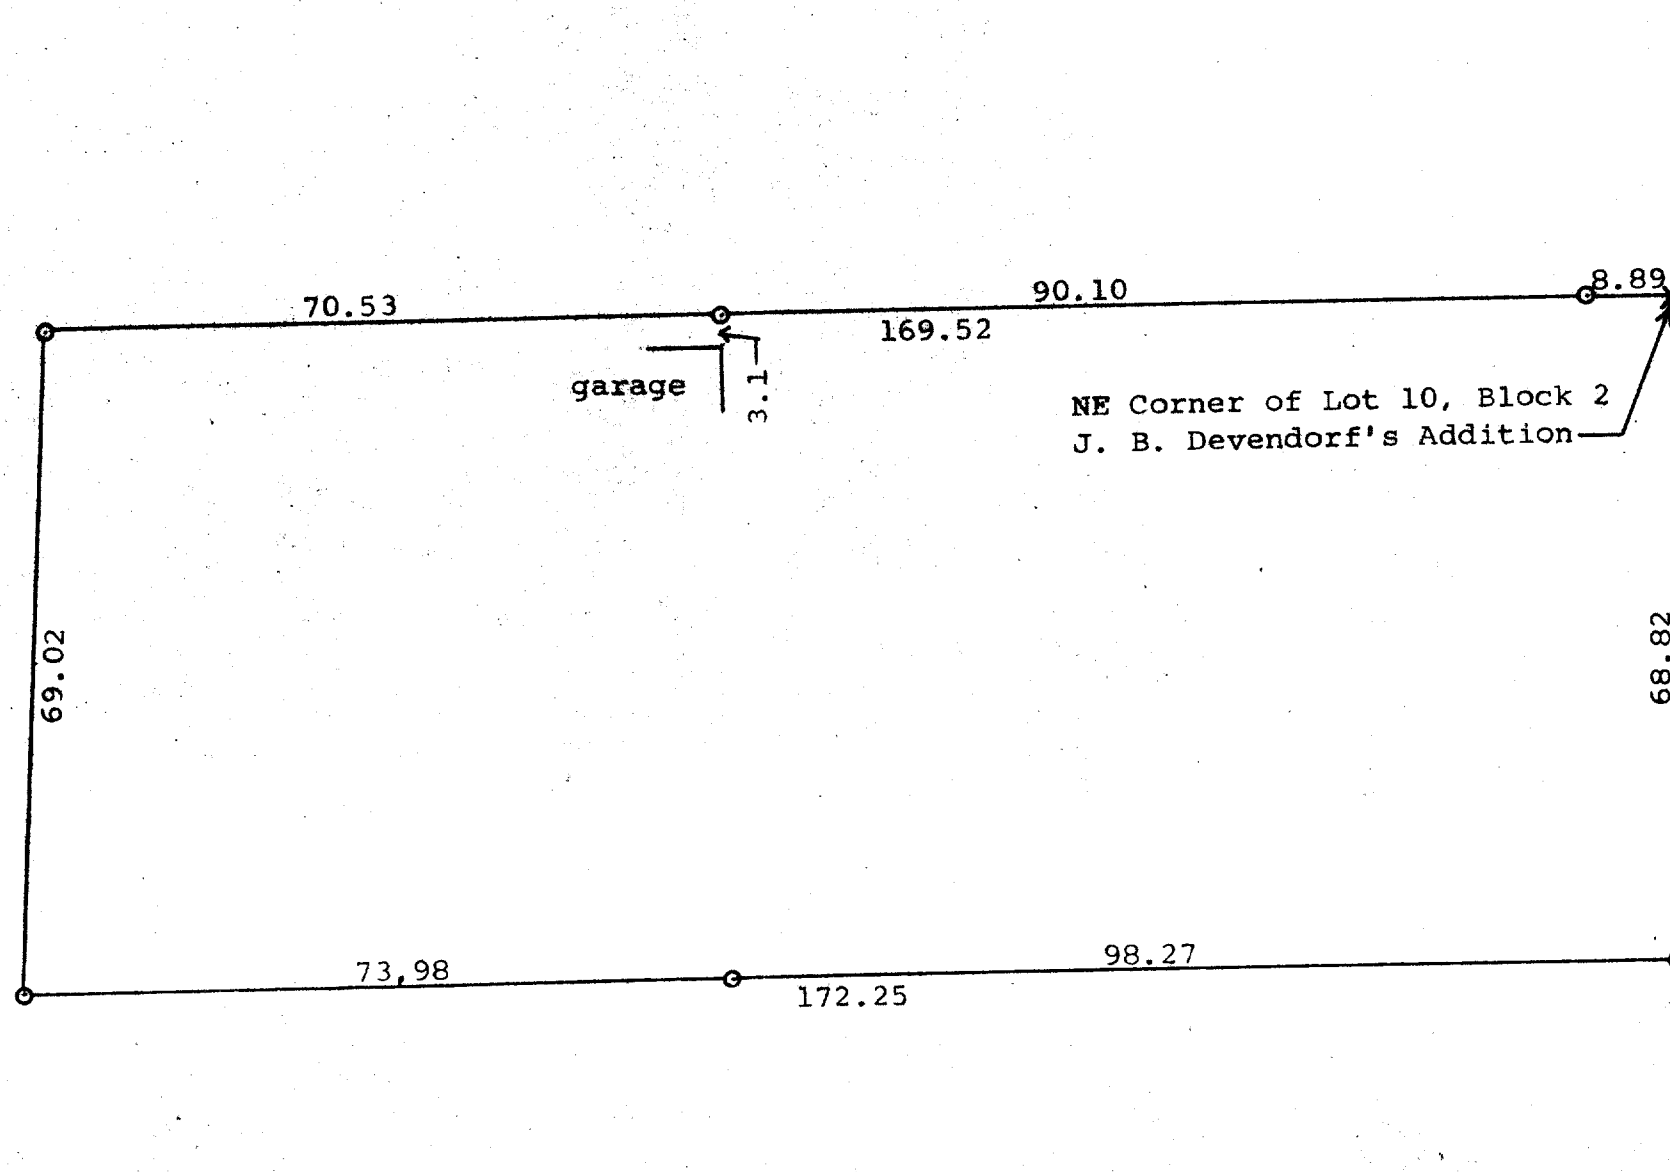

Plat of survey of the land purchased by Clifford Arndt
located in Lots 10 and 11, Block 2 of J. B. Devendorf's
Addition to the City of Delavan, Walworth County, Wisconsin.
August 1, 1969

George T. Dunham
George T. Dunham, Surveyor