

8-38-5

1959

1752

PLAT OF SURVEY OF LANDS NORTH OF
PHOENIX STREET AND EAST OF 4TH AVE IN
THE CITY OF DELAVAN, WALWORTH CO. WISCONSIN

by James F. Braggi
JAMES F. BRAGGI

SURVEYOR (S272)

NORTH




4TH

A

E

PHOENIX STREET

UP-157, 157A + 157E

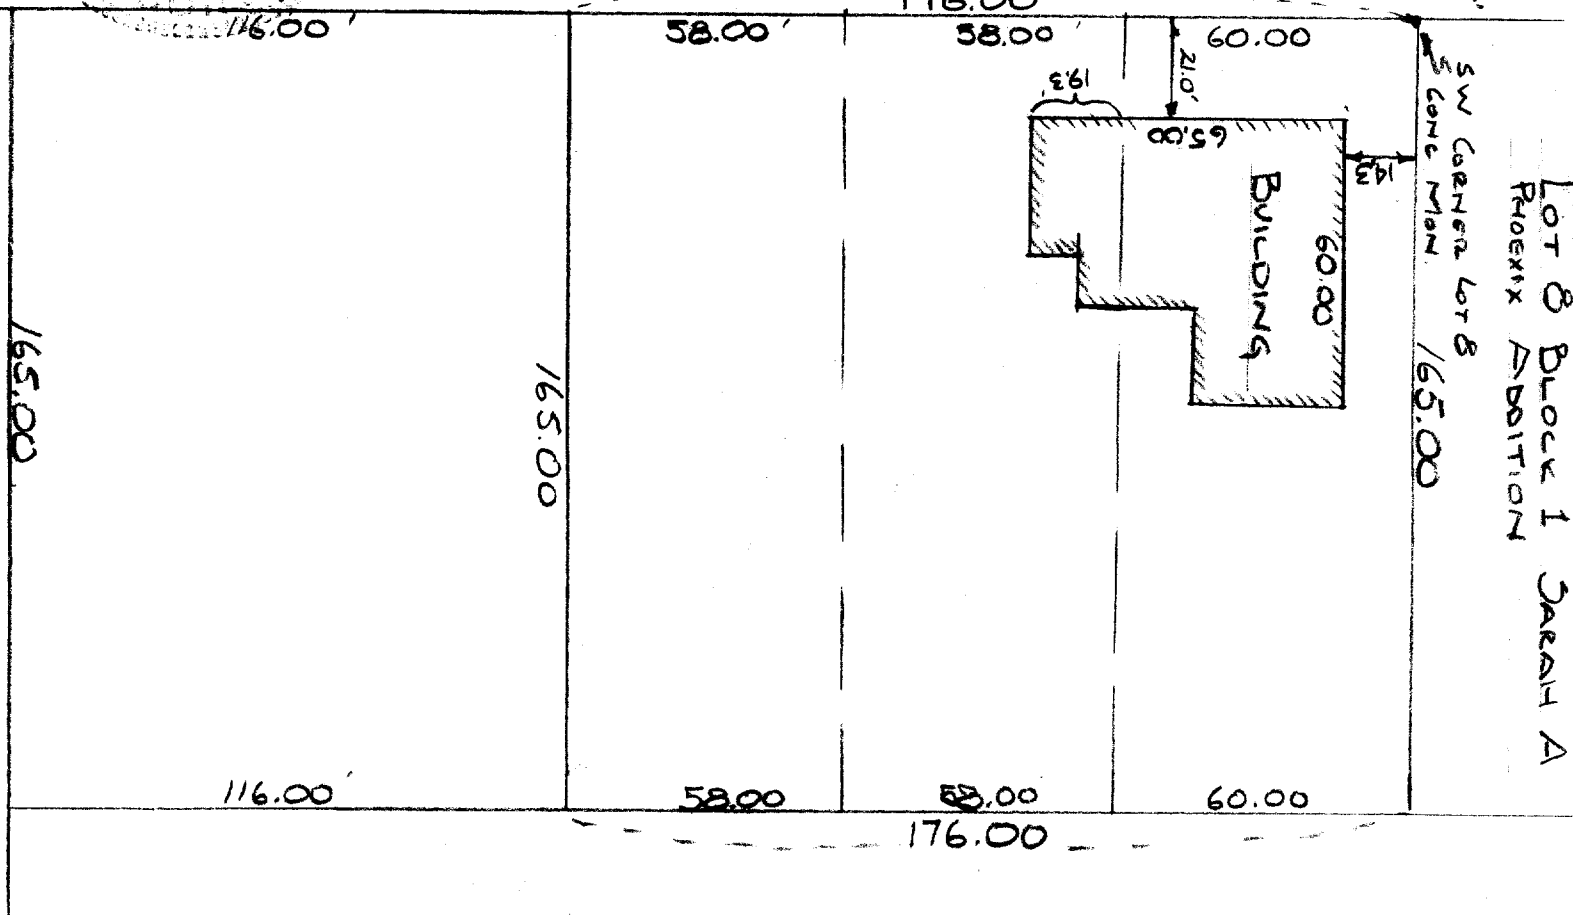

Lot 8 Block 1 Jarrah A
PHOENIX ADDITION

59-782

1-32