
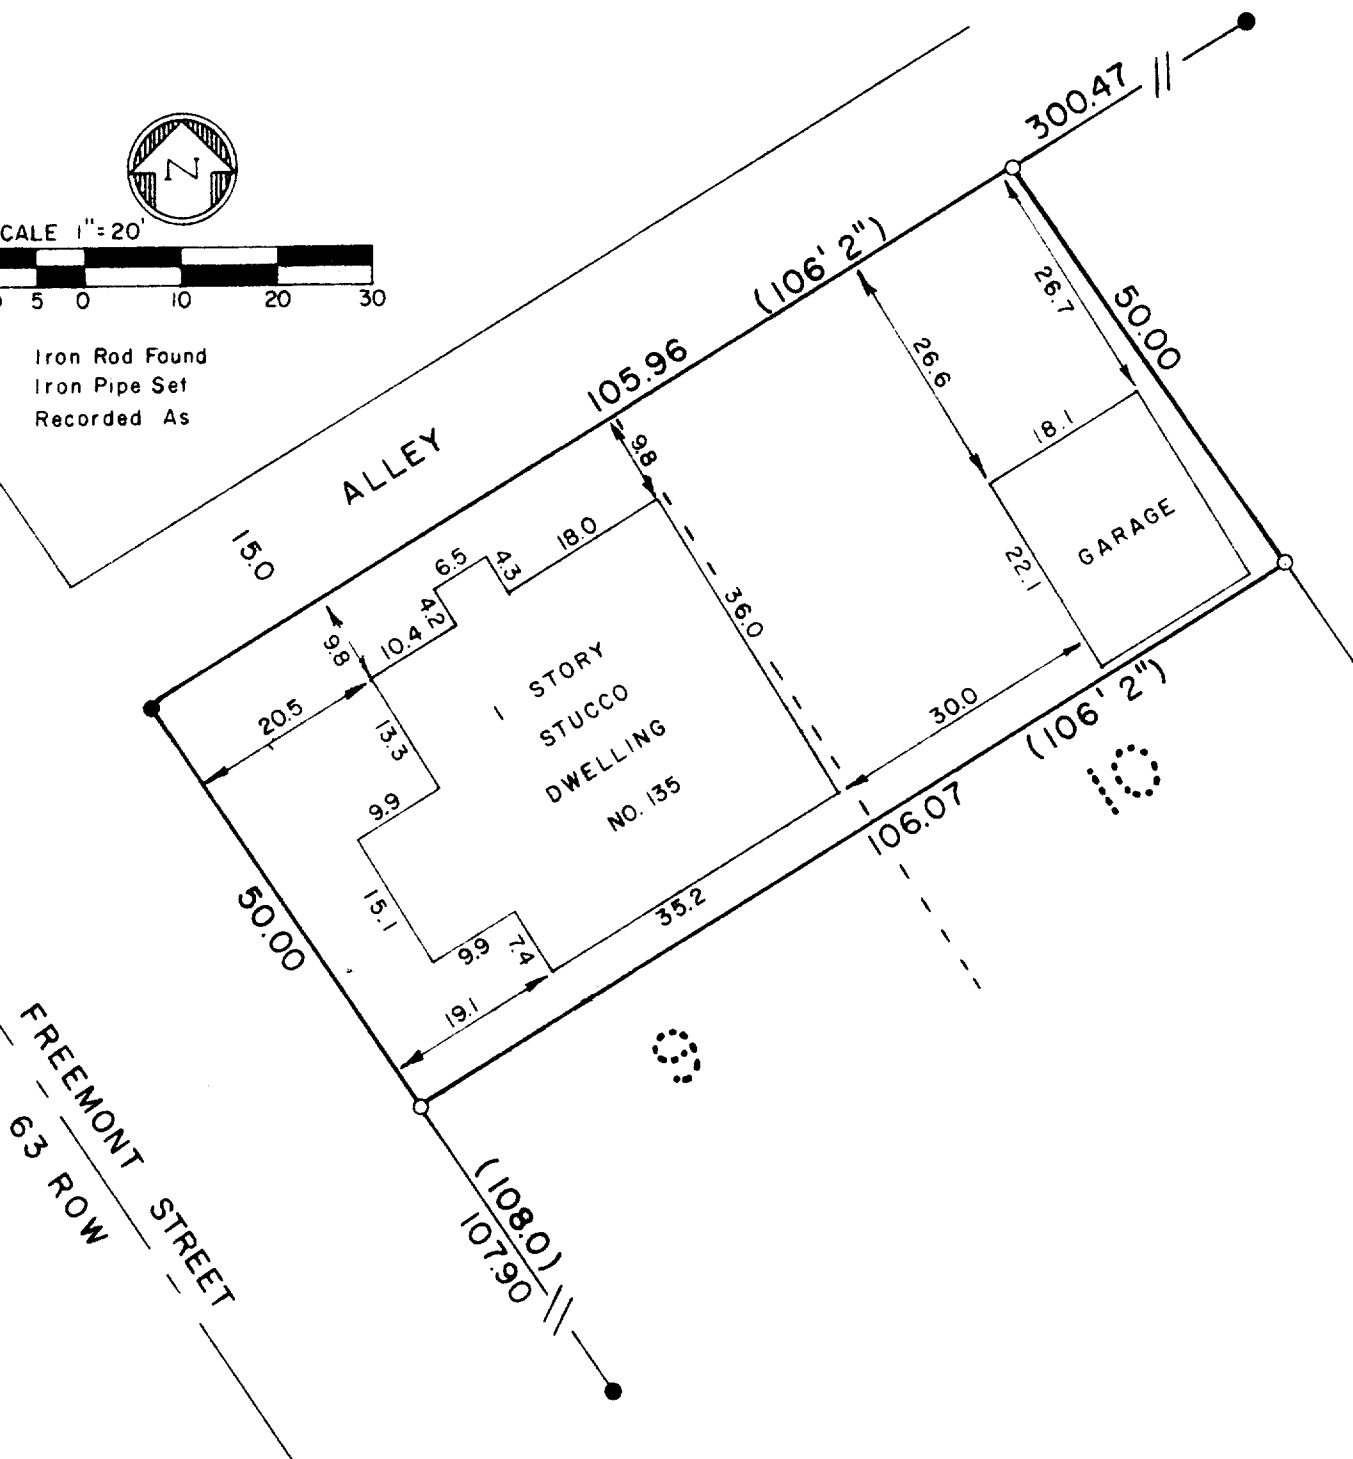


PLAT OF SURVEY

DESCRIPTION: The North 50.00 feet of Lots 9 and 10 in Block 4 of Converse's Subdivision in the City of Delavan, a part of the N 1/2 of Section 17, Township 2 North, Range 16 East of the Fourth Principal Meridian in Walworth County, Wisconsin, recorded in Volume 544 of Deeds, Page 349.

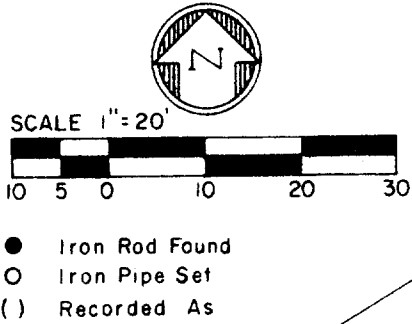


SURVEYOR'S CERTIFICATE

I have surveyed the above described property and the above map is a true representation thereof and shows the size and location of the property, its exterior boundaries, the location and dimensions of all visible encroachments. This survey is made for the exclusive use of the present owners of the property, and also those who purchase, mortgage, or guarantee the title thereto within one (1) year from date hereof and as to them I warrant the accuracy of said survey and map.

Date June 30, 1978

Dennis W. Valentine DENNIS W.
Dennis W. Valentine, PLs 1419 VALENTINE

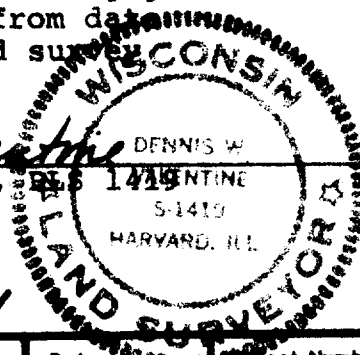

Part
XCS-34

SURV

Prepared By
VALENTINE AND ASSOCIATES, INC.
DELAWARE, WISCONSIN

Prepared For
DUANE DUESTERBECK
DELAVER, WISCONSIN

Date 6/30/78	Sheet Number 1 of 1
Job Number 7868	Reference file

29,330