


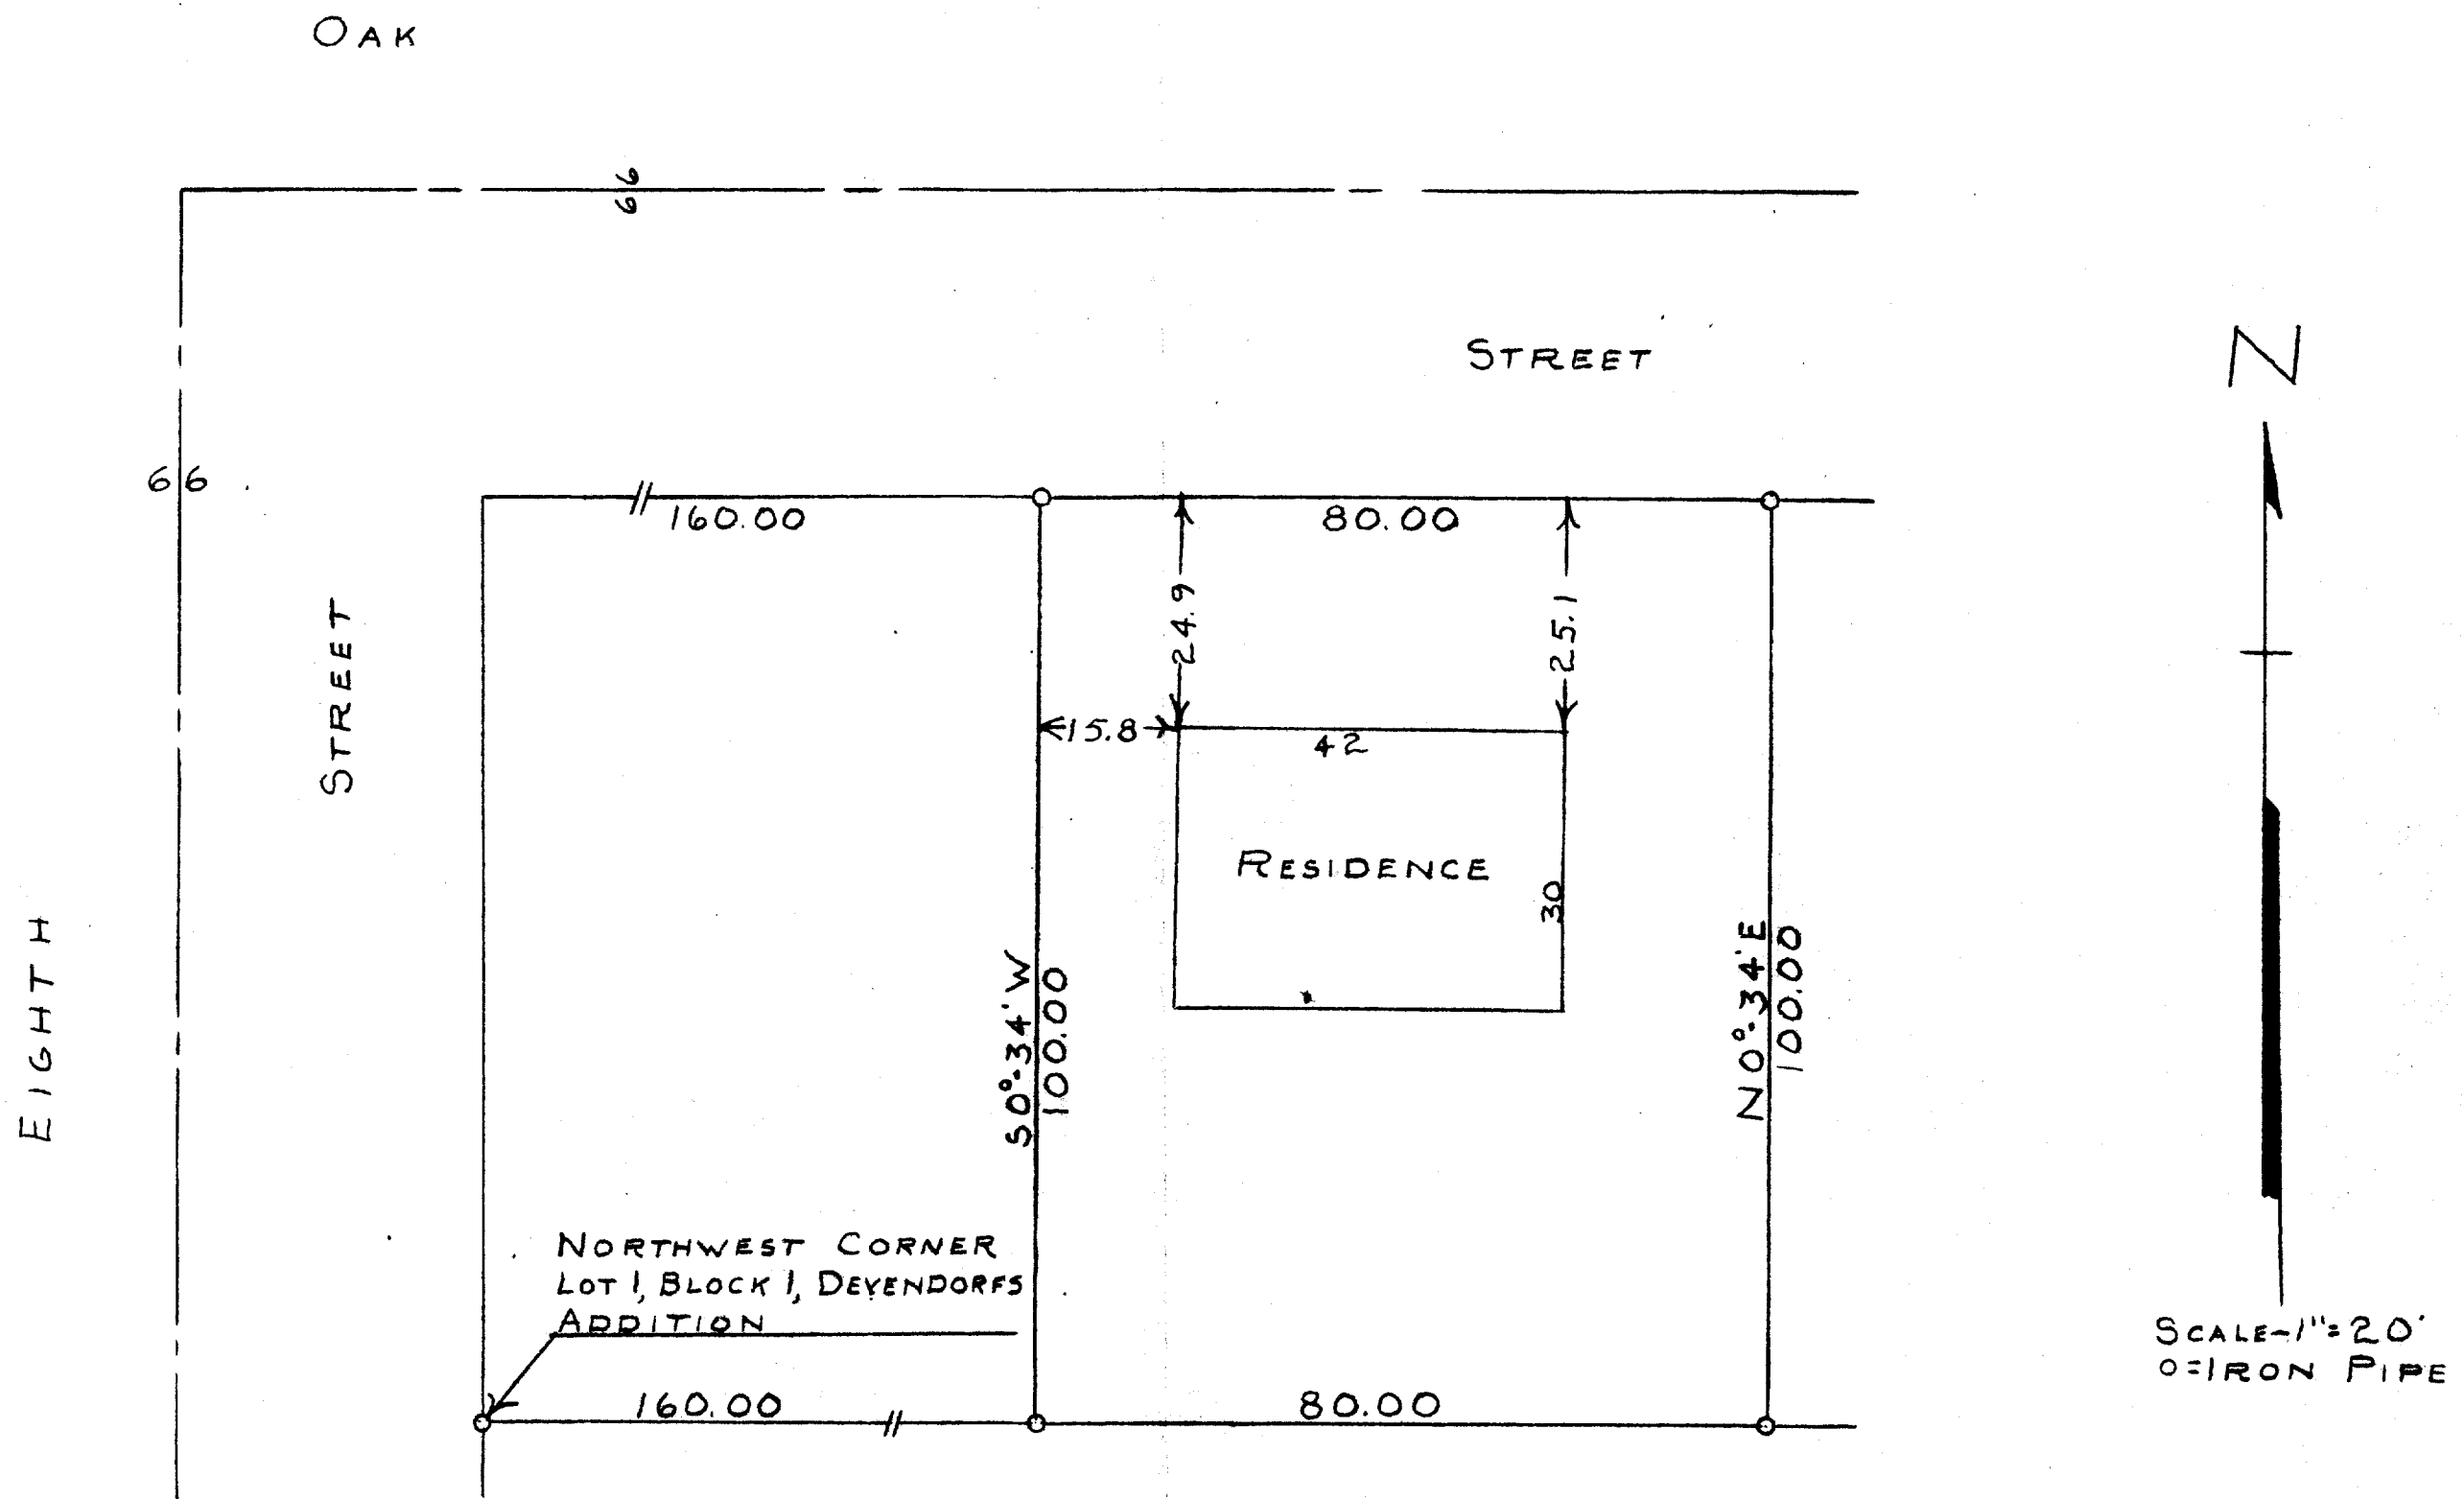

STATE OF WISCONSIN)
COUNTY OF WALWORTH)

I, GEORGE T. DUNHAM, DO HEREBY CERTIFY THAT I HAVE SURVEYED THE PROPERTY DESCRIBED AS FOLLOWS:

A PARCEL OF LAND LOCATED IN THE NW 1/4 OF SECTION 17, T2N R16E, CITY OF DELAYAN WALWORTH COUNTY, WISCONSIN, DESCRIBED AS FOLLOWS, TO-WIT: COMMENCING AT THE NW CORNER OF LOT 1, BLOCK 1, OF DEVENDORF'S ADDITION TO THE CITY OF DELAYAN; THENCE EASTERLY ALONG THE NORTH LINE OF SAID LOT 1, 160.00 FEET TO THE PLACE OF BEGINNING; THENCE CONTINUE EASTERLY ALONG SAID NORTH LINE EXTENDED EAST 80.00 FEET; THENCE N0°34'E PARALLEL TO THE EAST LINE OF EIGHTH STREET 100.00 FEET TO THE SOUTH LINE OF OAK STREET; THENCE WESTERLY ALONG THE SOUTH LINE OF OAK STREET 80.00 FEET; THENCE S0°34'W 100.00 FEET TO THE PLACE OF BEGINNING.

AND THAT THE PLAT SHOWN ABOVE IS A CORRECT REPRESENTATION OF THE PROPERTY LINES.
DEC. 14, 1955

George T. Dunham
GEORGE T. DUNHAM, SURVEYOR
DELAYAN, WISCONSIN

XWUP-42C

2-35