


GEORGE T. DUNHAM
 SURVEYING & SUBDIVIDING
 DELAVAN, WISCONSIN

N

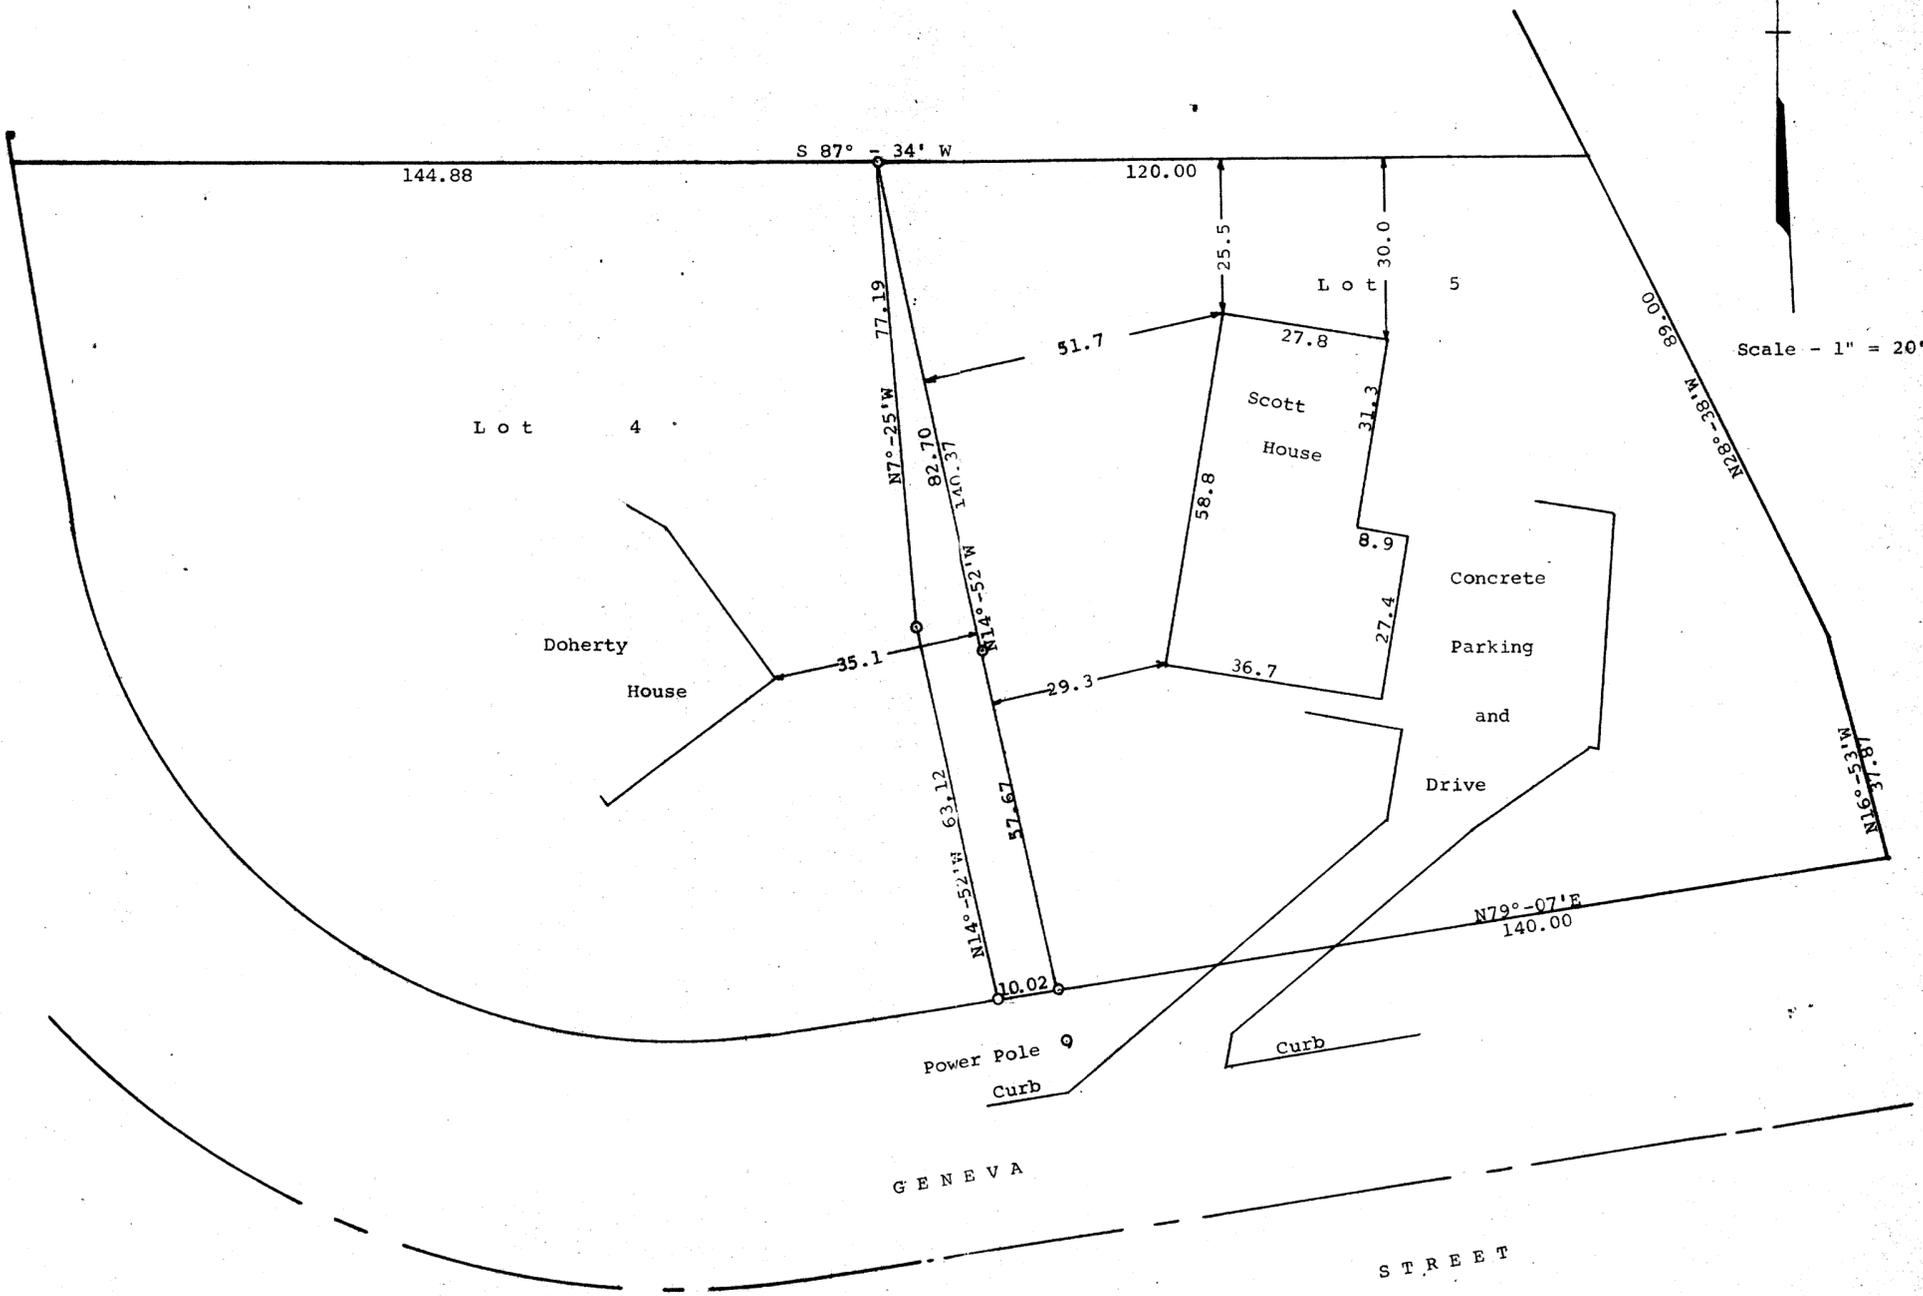

Plat showing the location of the house on Lot 5, and the location of the house to the lot line on Lot 4 in Block 1 of Springs Park Subdivision, City of Delavan, Walworth County, Wisconsin.
 July 2, 1969
 Revised July 1, 1970 *George T. Dunham*
 George T. Dunham, Surveyor