



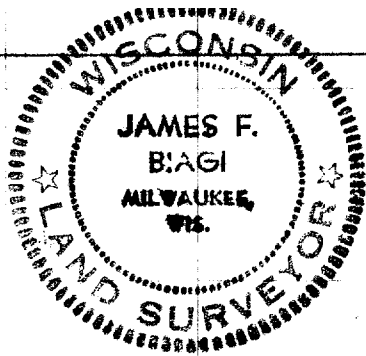

NORTH

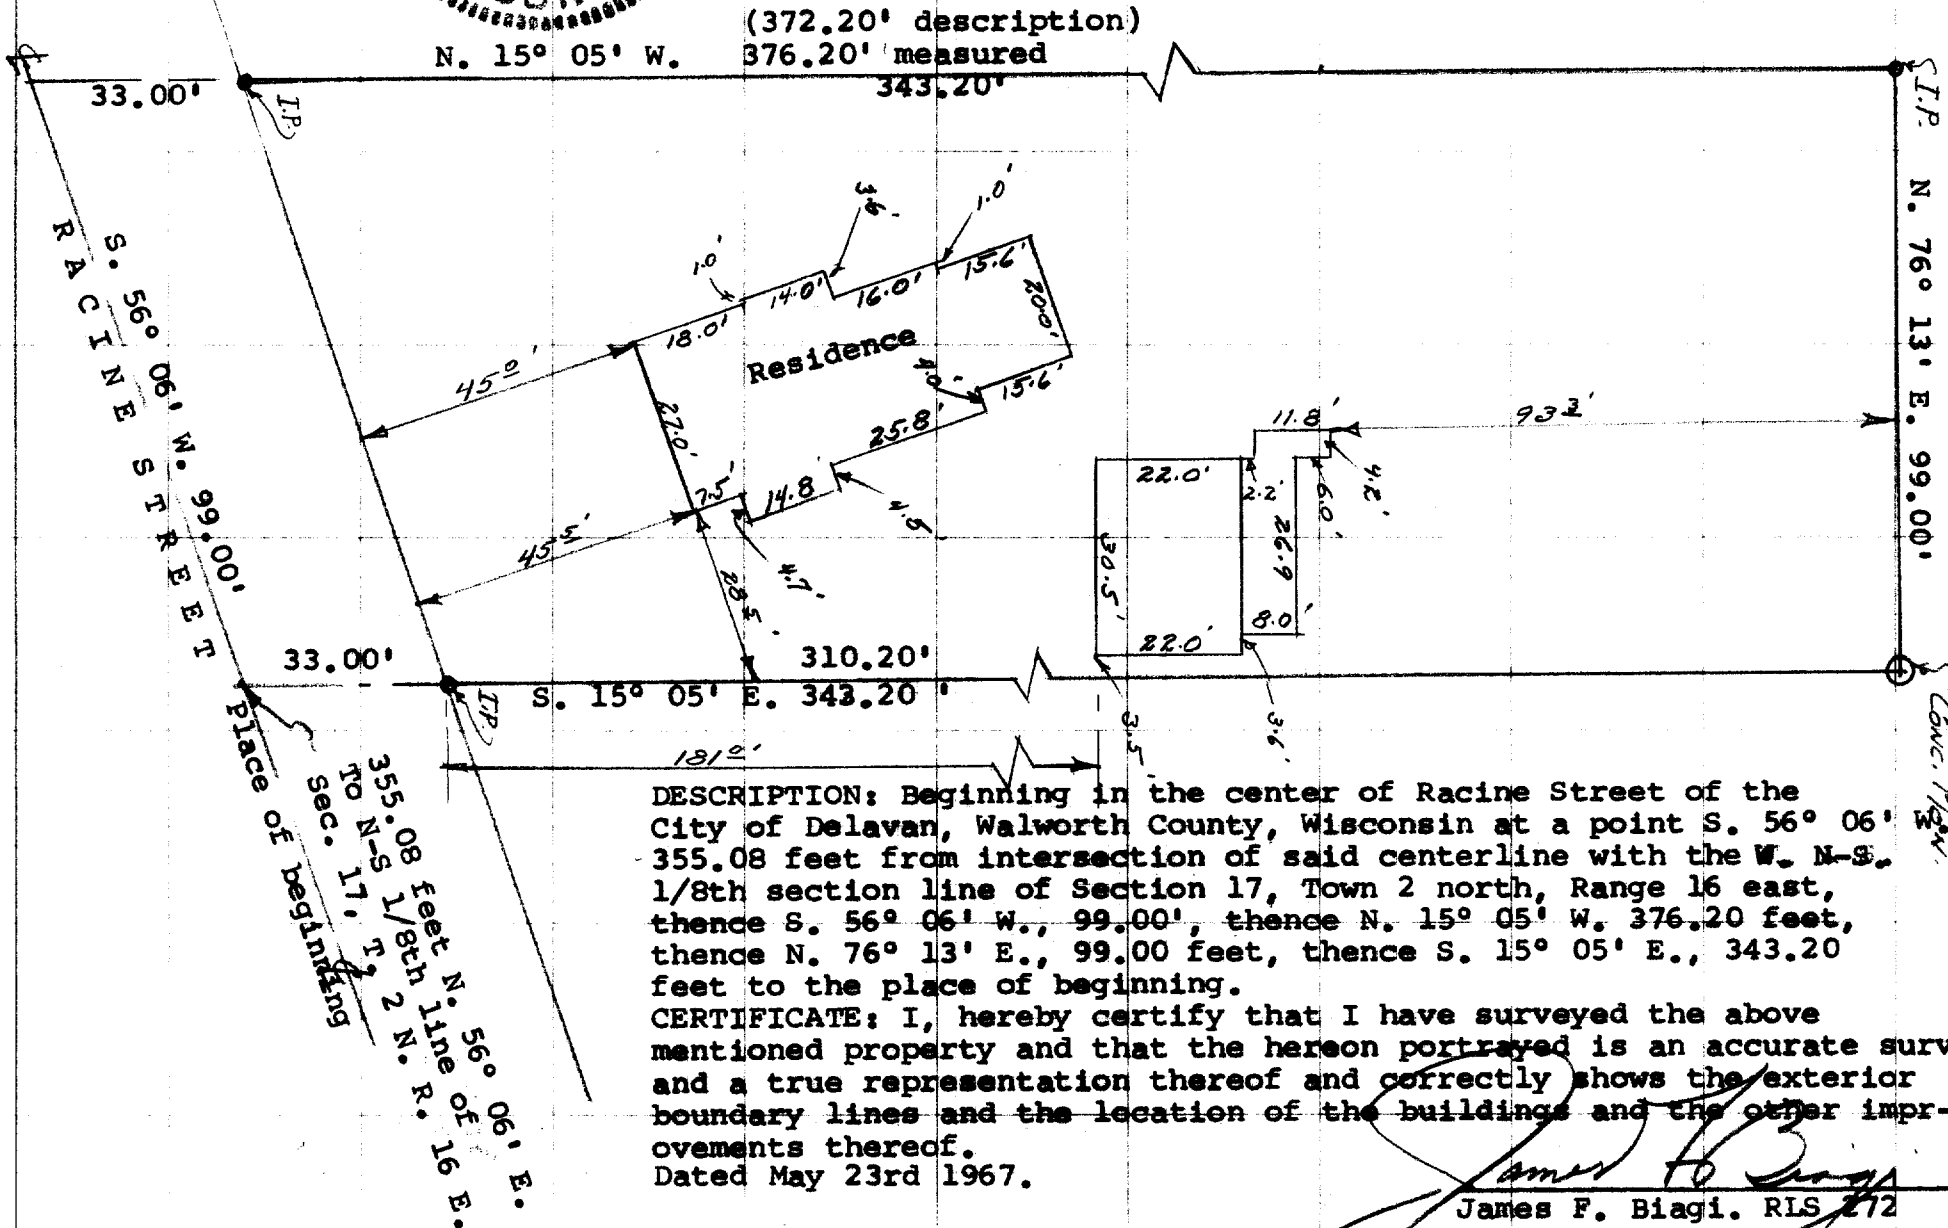

XWUP-39

2-35 B

#78-67