


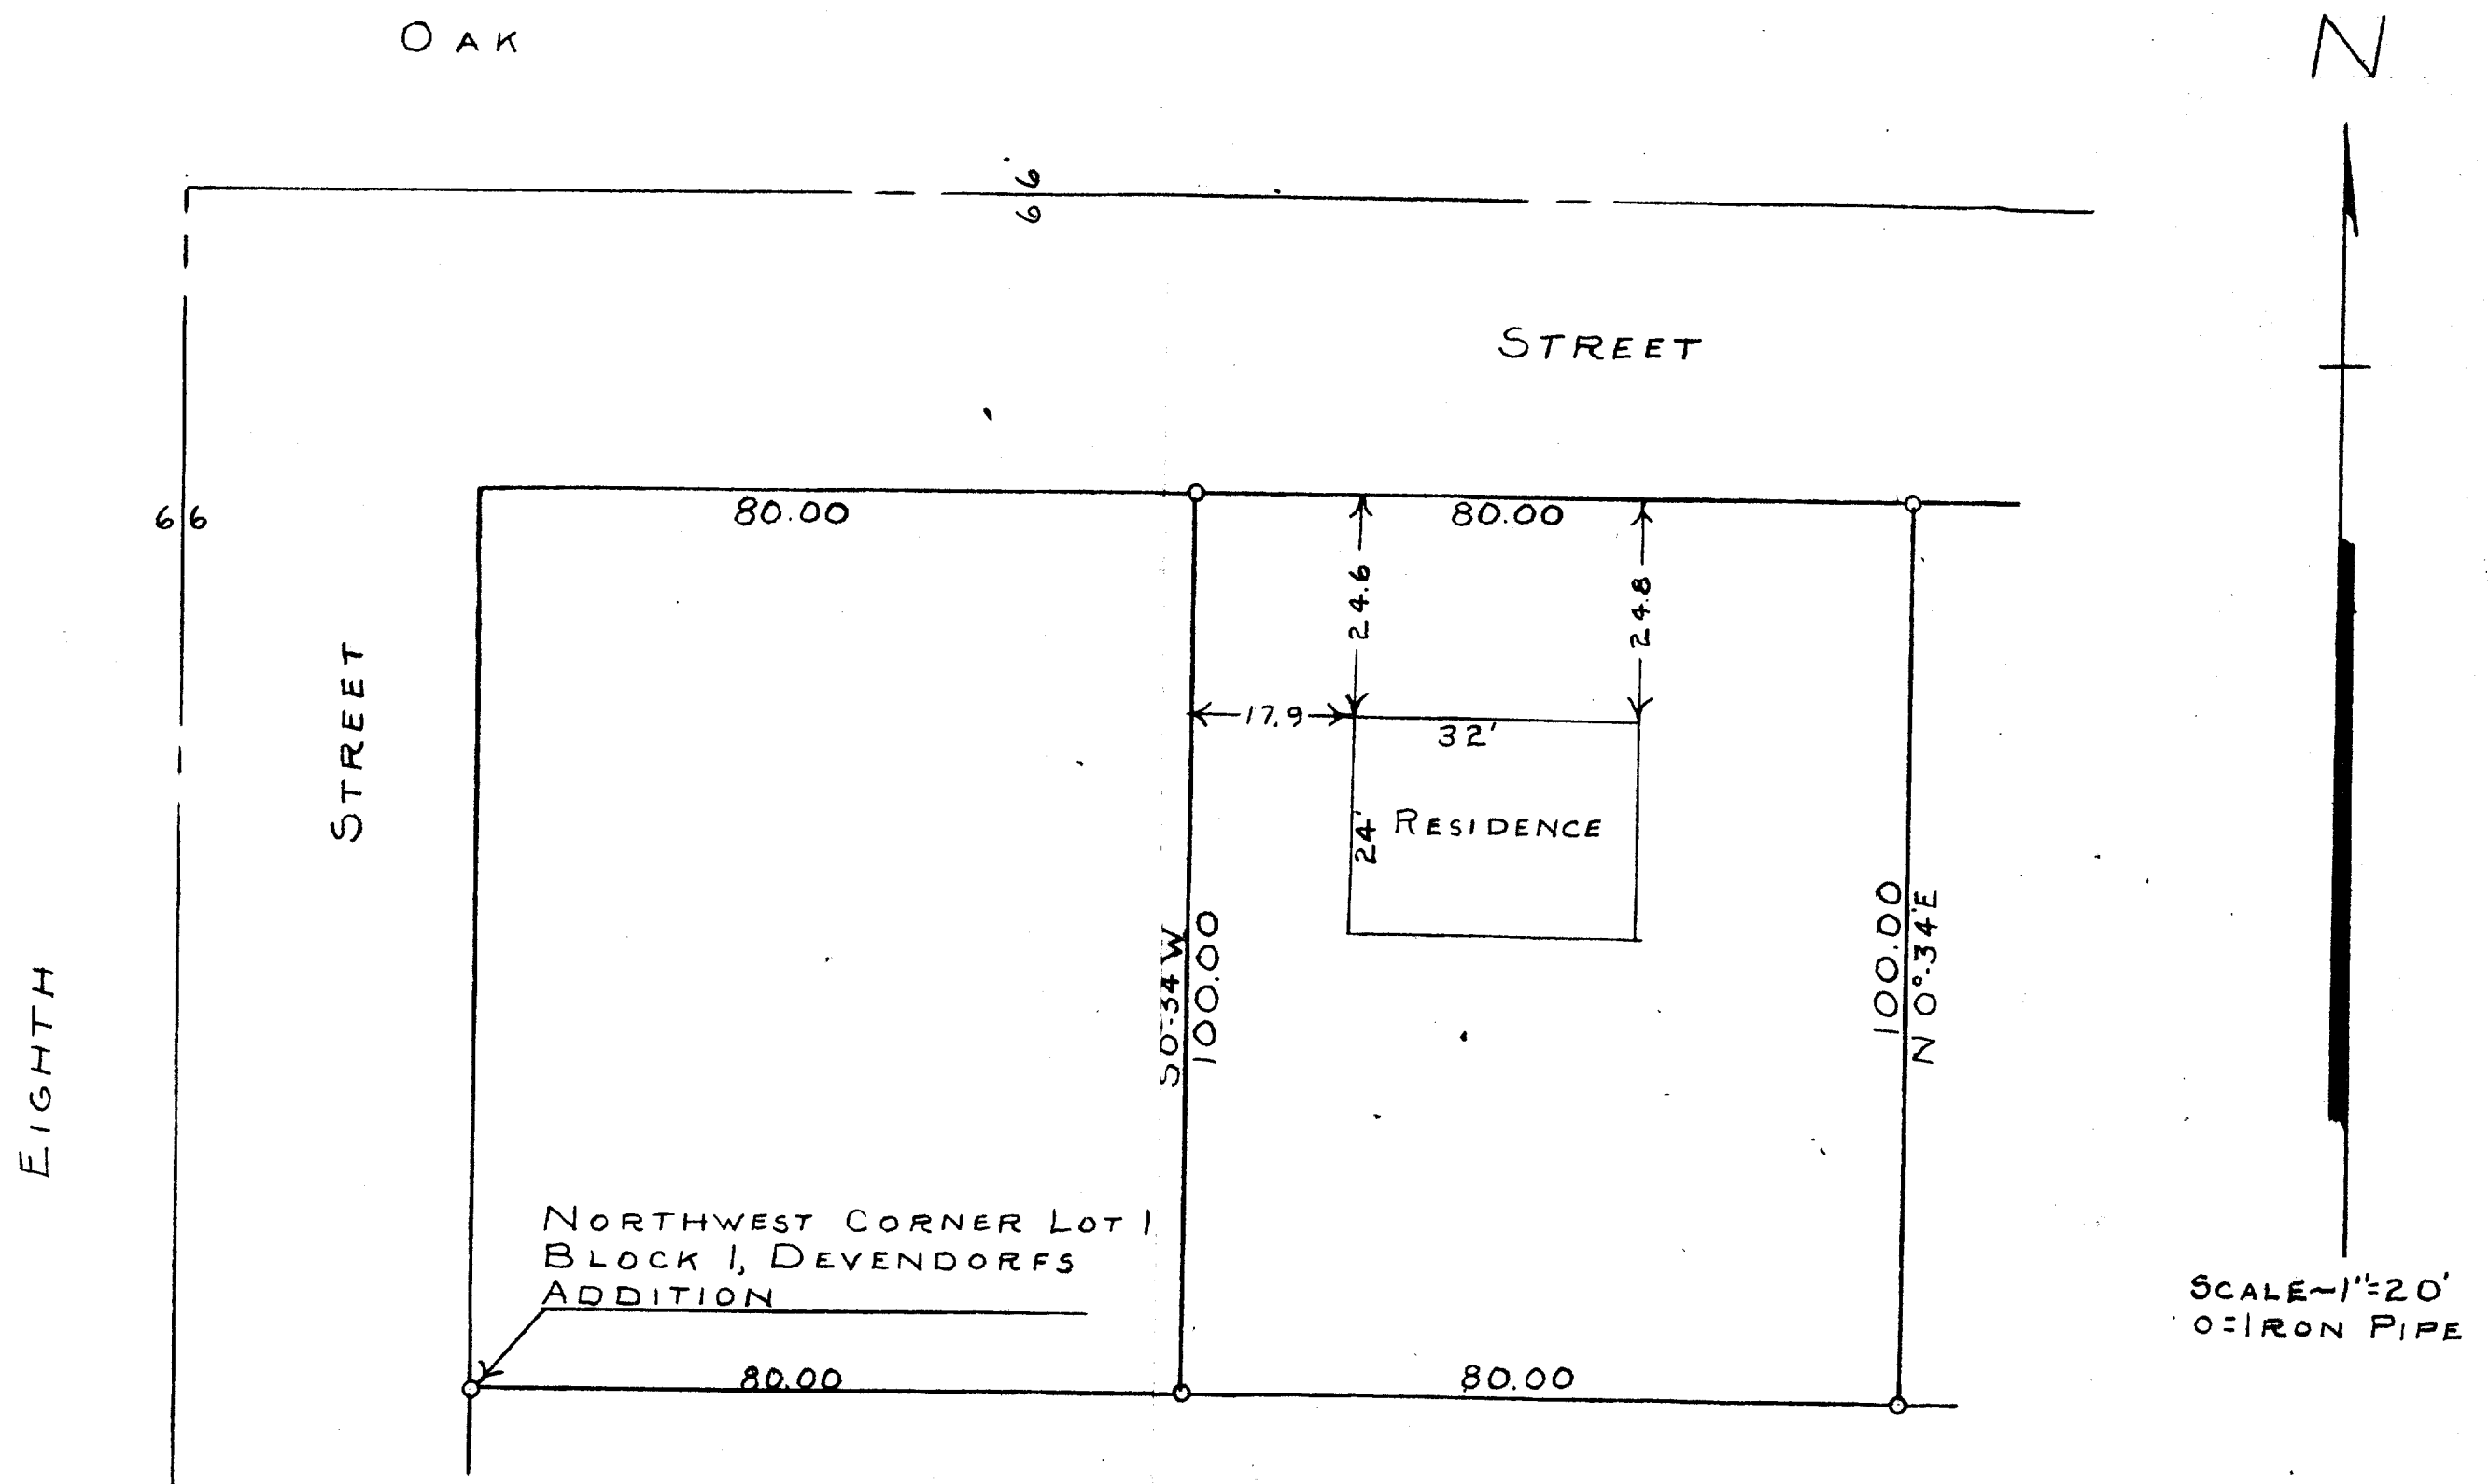

STATE OF WISCONSIN)^{ss}
COUNTY OF WALWORTH)

I, GEORGE T. DUNHAM, DO HEREBY CERTIFY THAT I HAVE SURVEYED THE PROPERTY DESCRIBED AS FOLLOWS:

A PARCEL OF LAND LOCATED IN THE NW 1/4 OF SECTION 17, T2N R16E, CITY OF DELAVAN, WALWORTH COUNTY, WISCONSIN, DESCRIBED AS FOLLOWS, TO WIT: COMMENCING AT THE NW CORNER OF LOT 1, BLOCK 1, OF DEVENDORFS ADD. TO THE CITY OF DELAVAN; THENCE EASTERLY ALONG THE NORTH LINE OF SAID LOT 1, 80.00 FEET TO THE PLACE OF BEGINNING; THENCE CONTINUE EASTERLY ALONG SAID NORTH LINE 80.00 FEET; THENCE N 0°34'E PARALLEL TO THE EAST LINE OF EIGHTH STREET 100.00 FEET TO THE SOUTH LINE OF OAK STREET; THENCE WESTERLY ALONG THE SOUTH LINE OF OAK STREET 80.00 FEET; THENCE S 0°34'W 100.00 FEET TO THE PLACE OF BEGINNING;

AND THAT THE PLAT SHOWN ABOVE IS A CORRECT REPRESENTATION OF THE PROPERTY LINES.

DEC. 14, 1955

XWVP-42B

George T. Dunham
GEORGE T. DUNHAM, SURVEYOR
DELAVAN, WISCONSIN

2-36