


GEORGE T. DUNHAM
SURVEYING & SUBDIVIDING
DELAVER, WISCONSIN

N

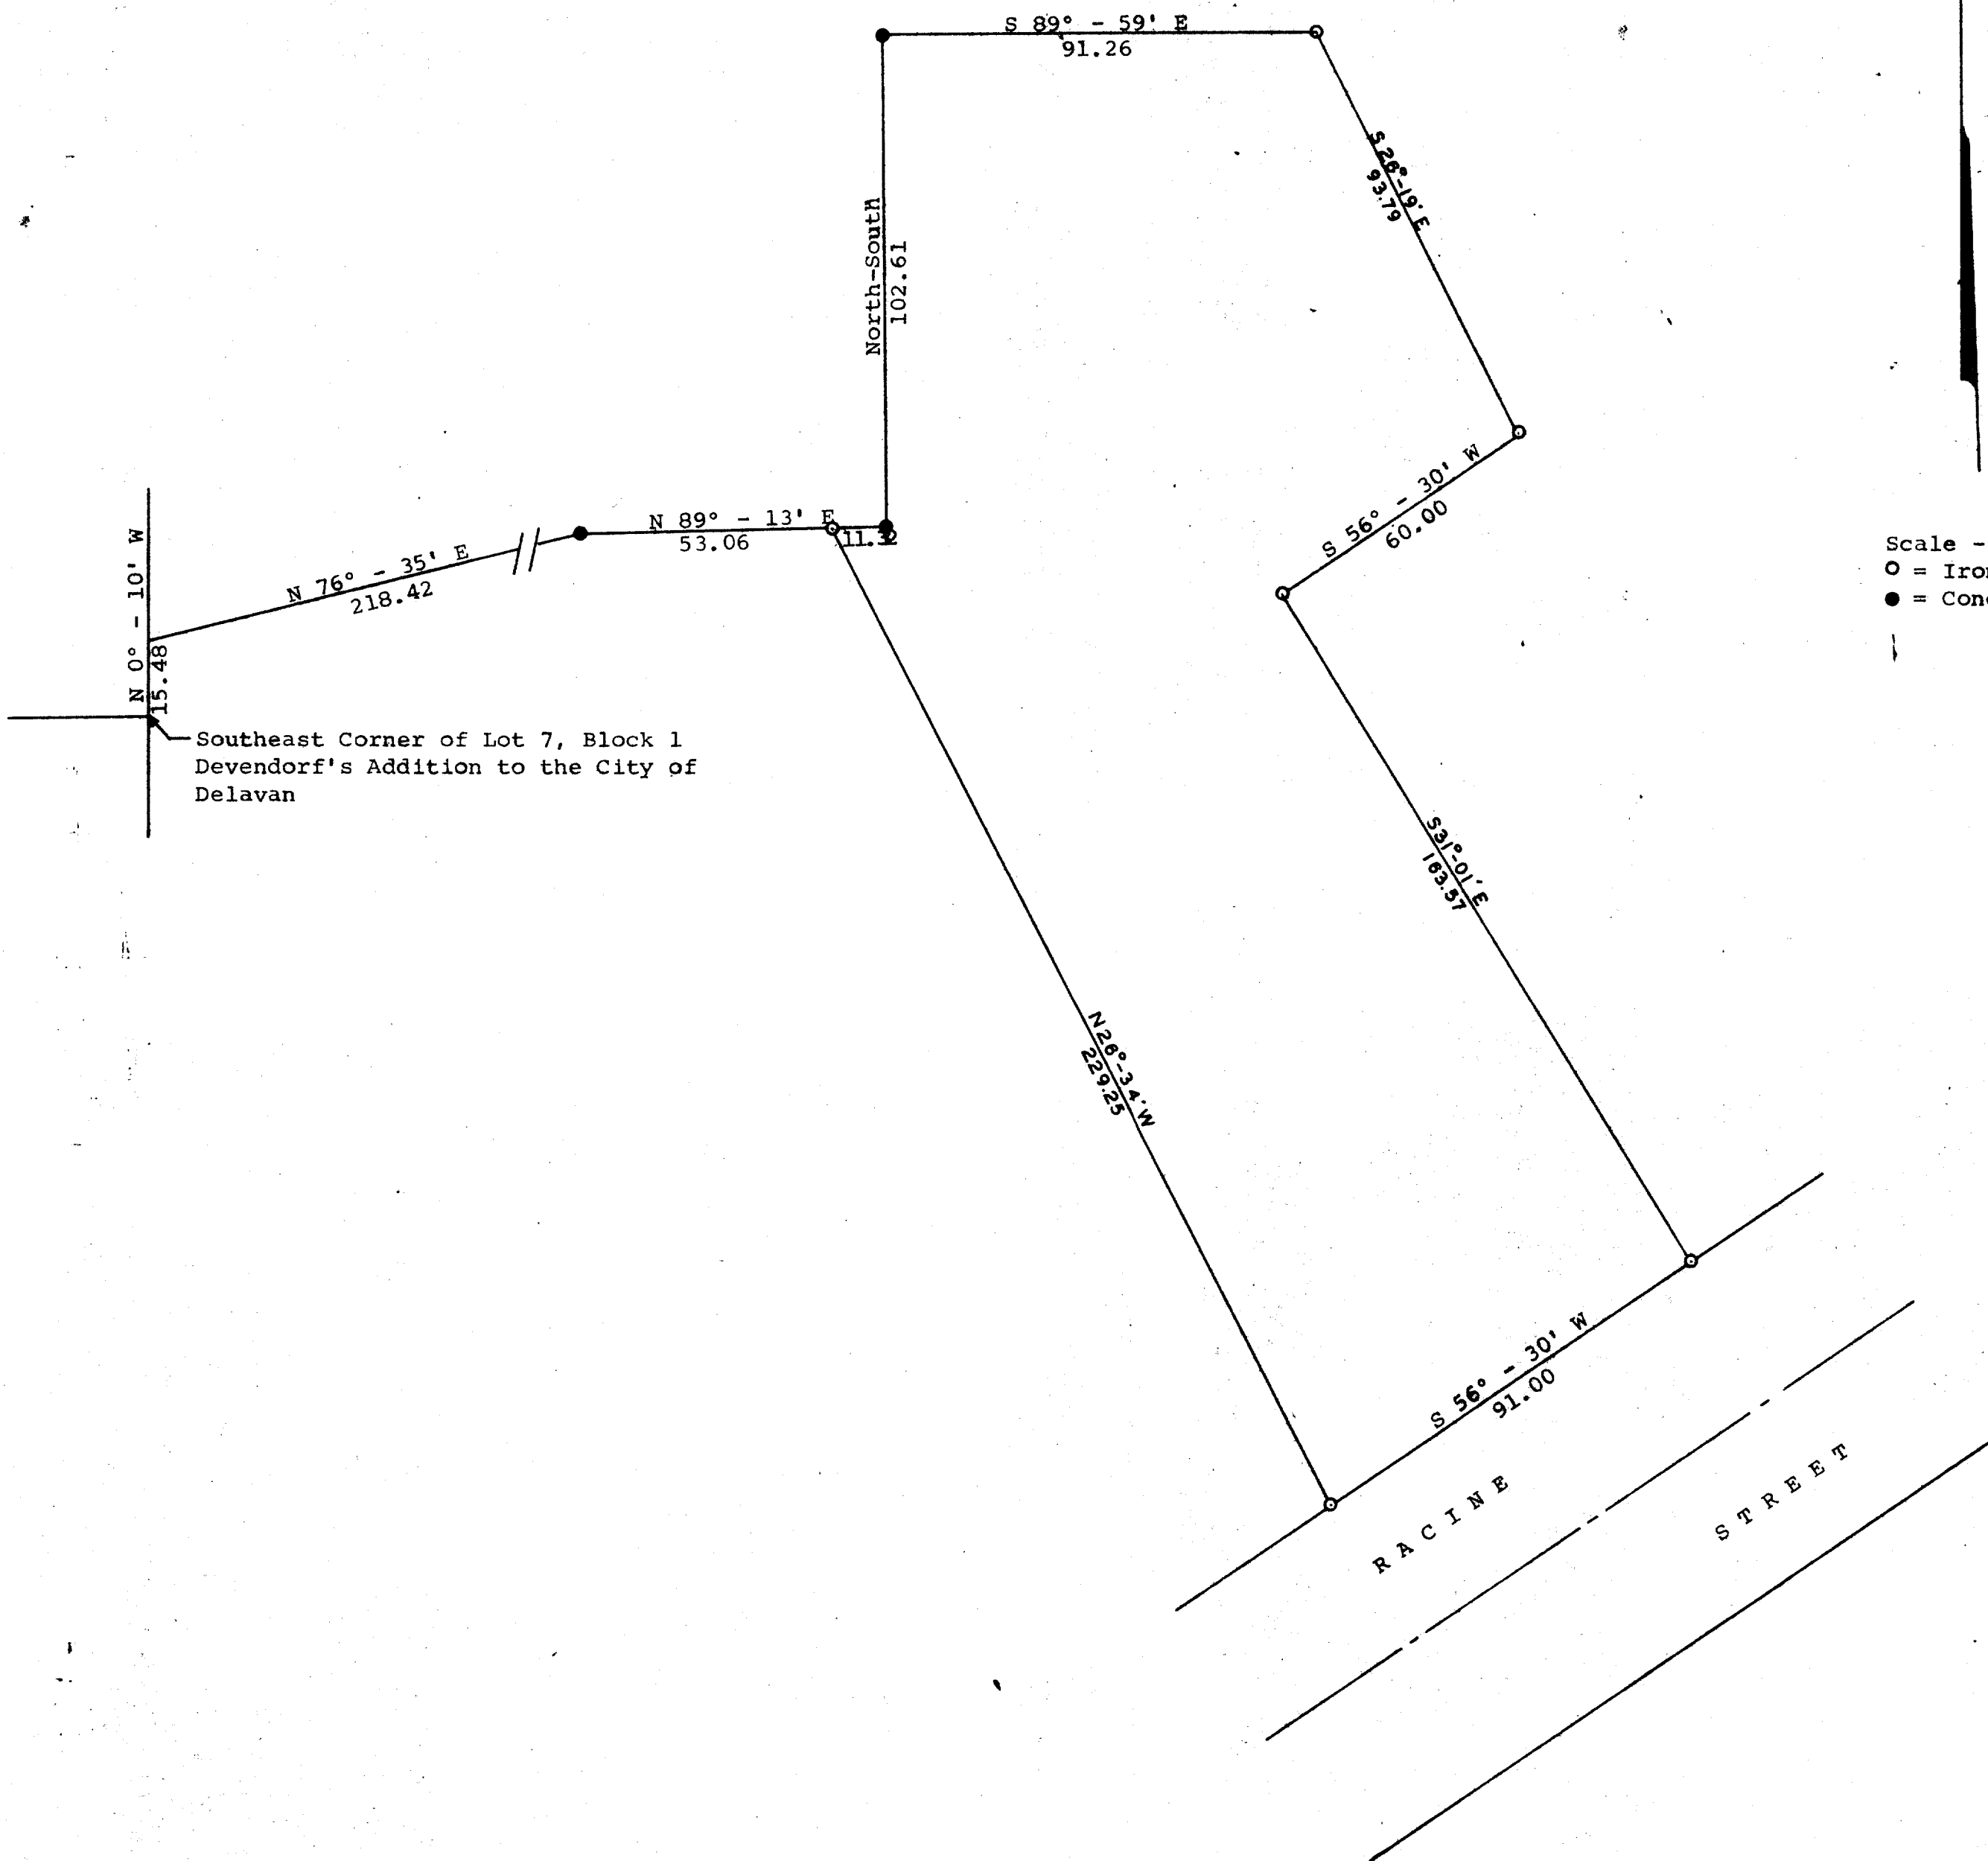

Plat of survey of the former Robert T. Seymour Property
located in the Northwest ¼ of Section 17, T 2 N, R 16 E,
City of Delavan, Walworth County, Wisconsin.
December 2, 1968

George T. Dunham
George T. Dunham, Surveyor