

GEORGE T. DUNHAM
SURVEYING & SUBDIVIDING
DELAYAN, WISCONSIN


N



Scale - 1" = 20'
O = Iron Pipe

STATE TRUNK

HIGHWAY No. 15

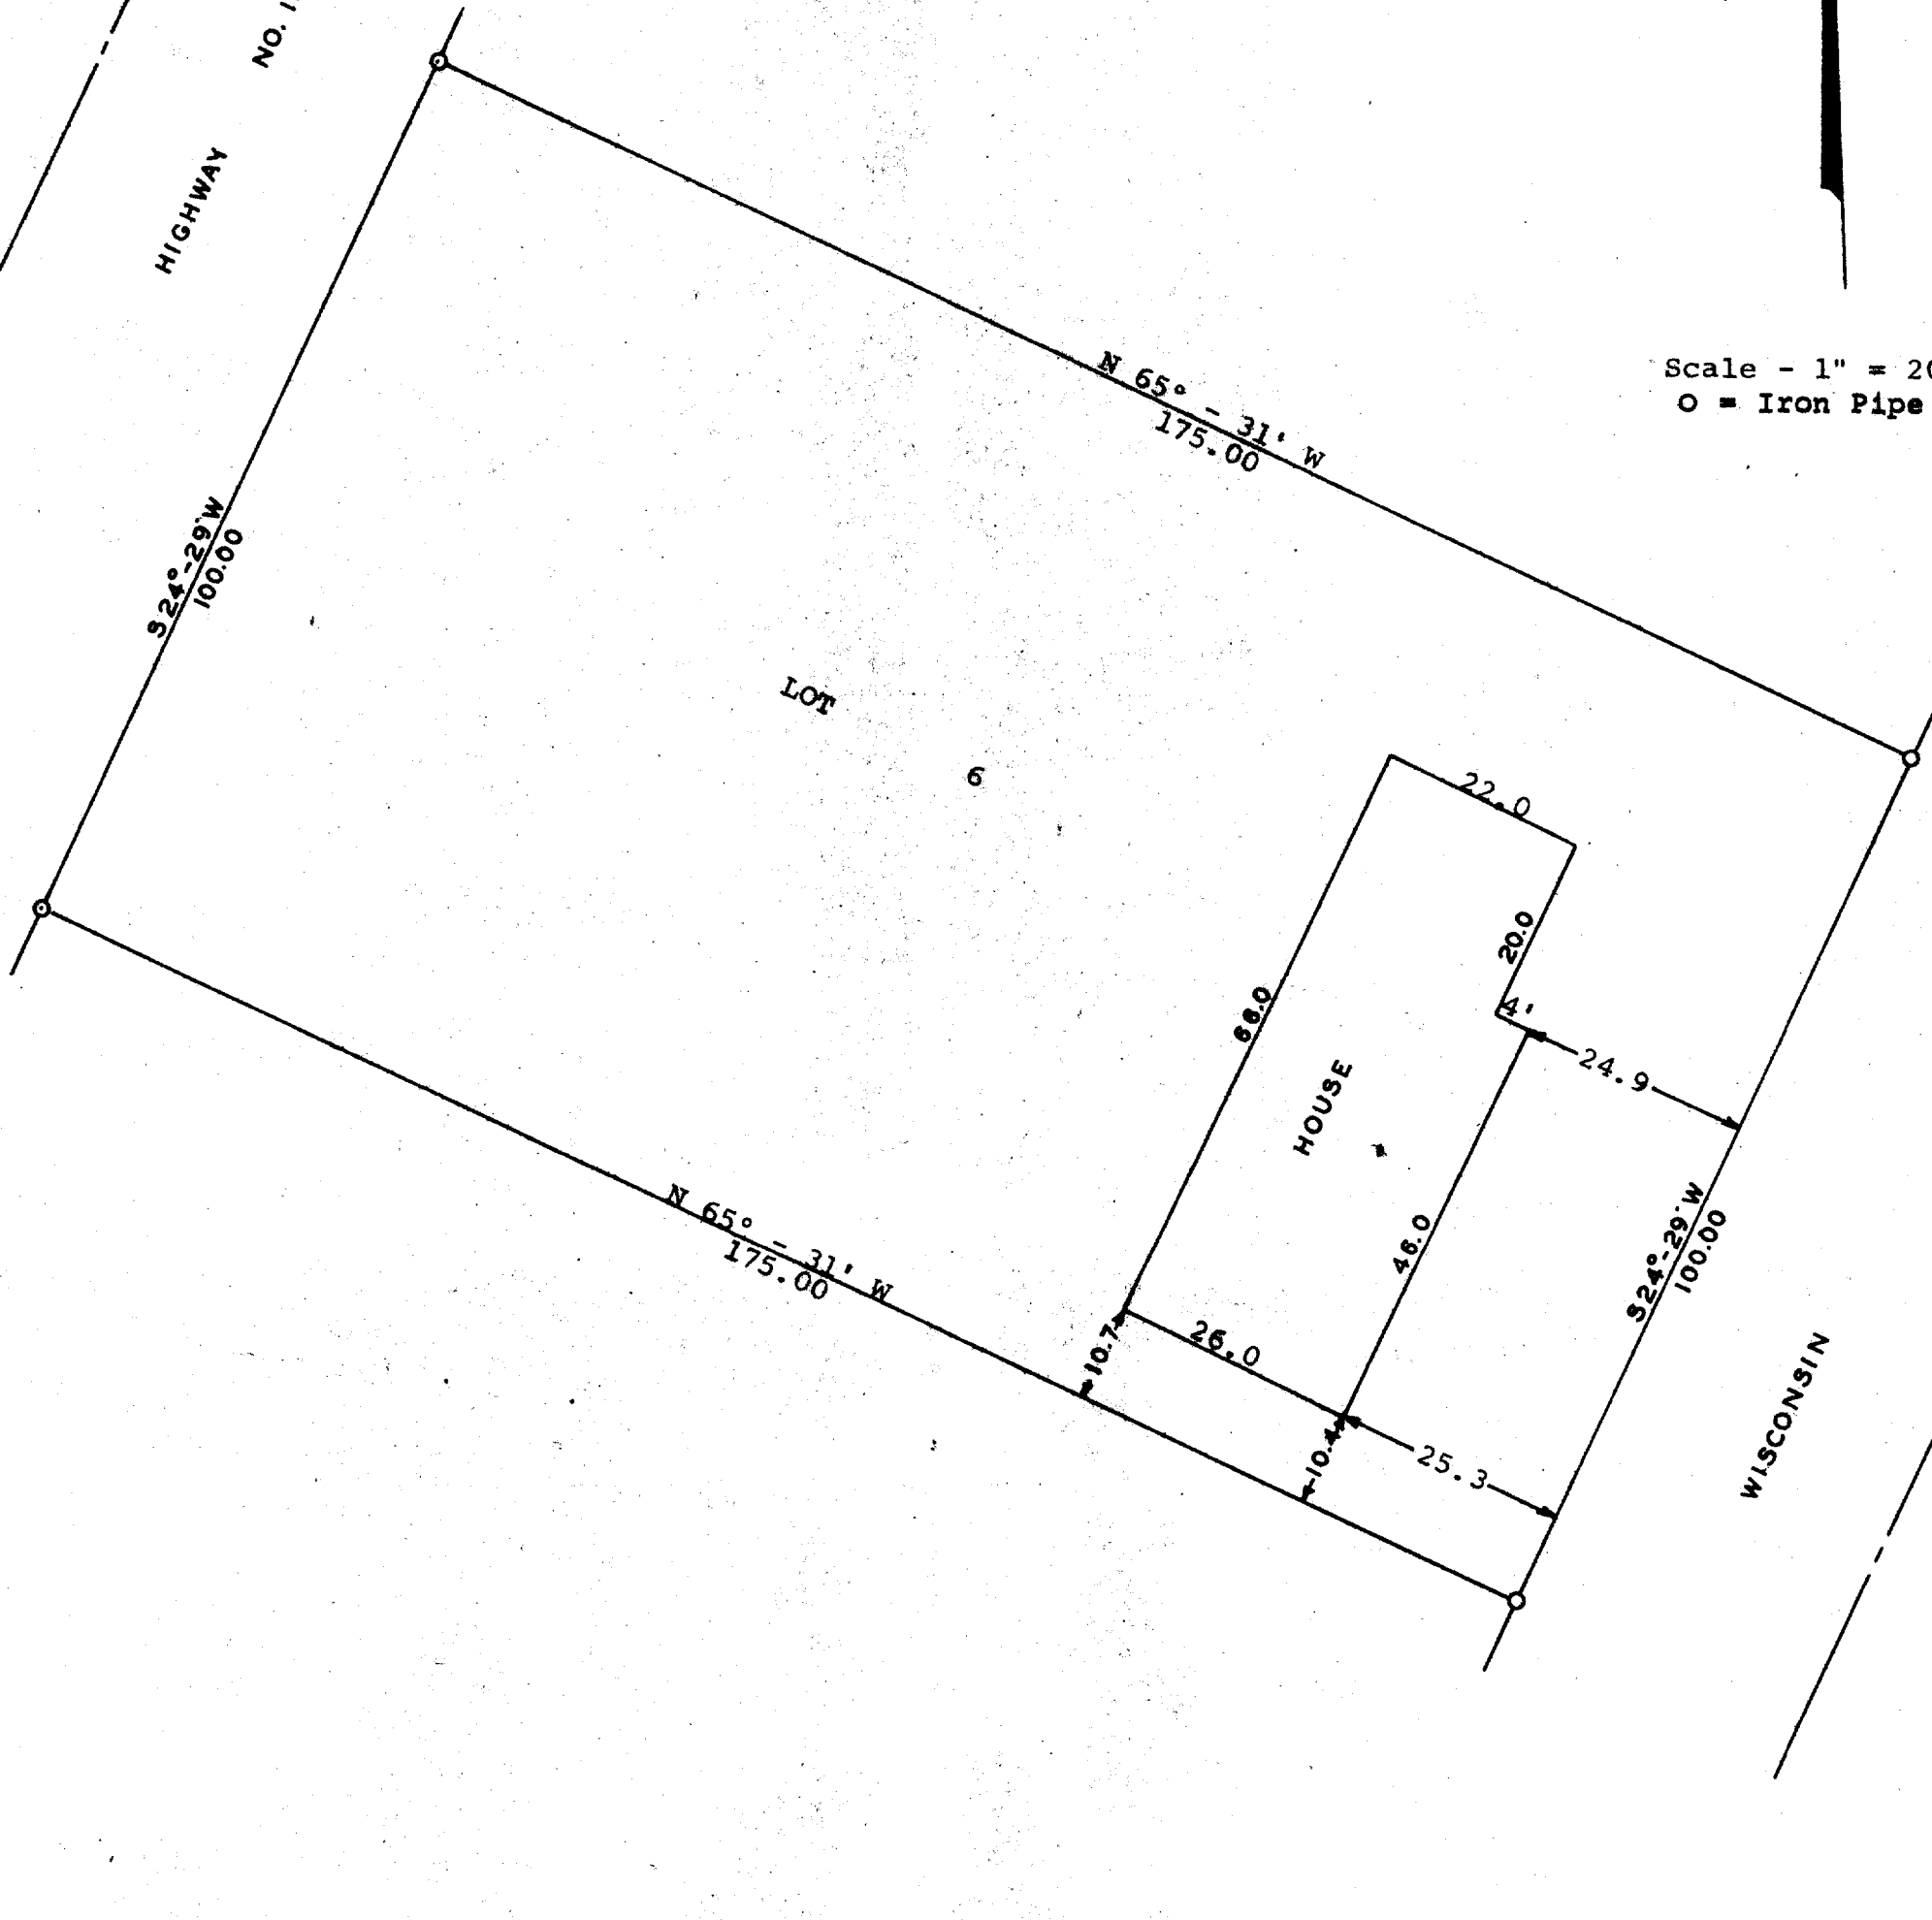

STATE OF WISCONSIN) SS
WALWORTH COUNTY)

I, George T. Dunham, Surveyor, certify that I have surveyed the property described as follows,
Lot 6, Block 4, Springs Park Subdivision Addition No. 1
located in the City of Delavan, Walworth County, Wisconsin
and that the above plat is an accurate survey and a true representation thereof and correctly shows the exterior boundary lines and location of buildings on said property and the correct measurements thereof.
March 6, 1969

George T. Dunham
George T. Dunham, Surveyor