


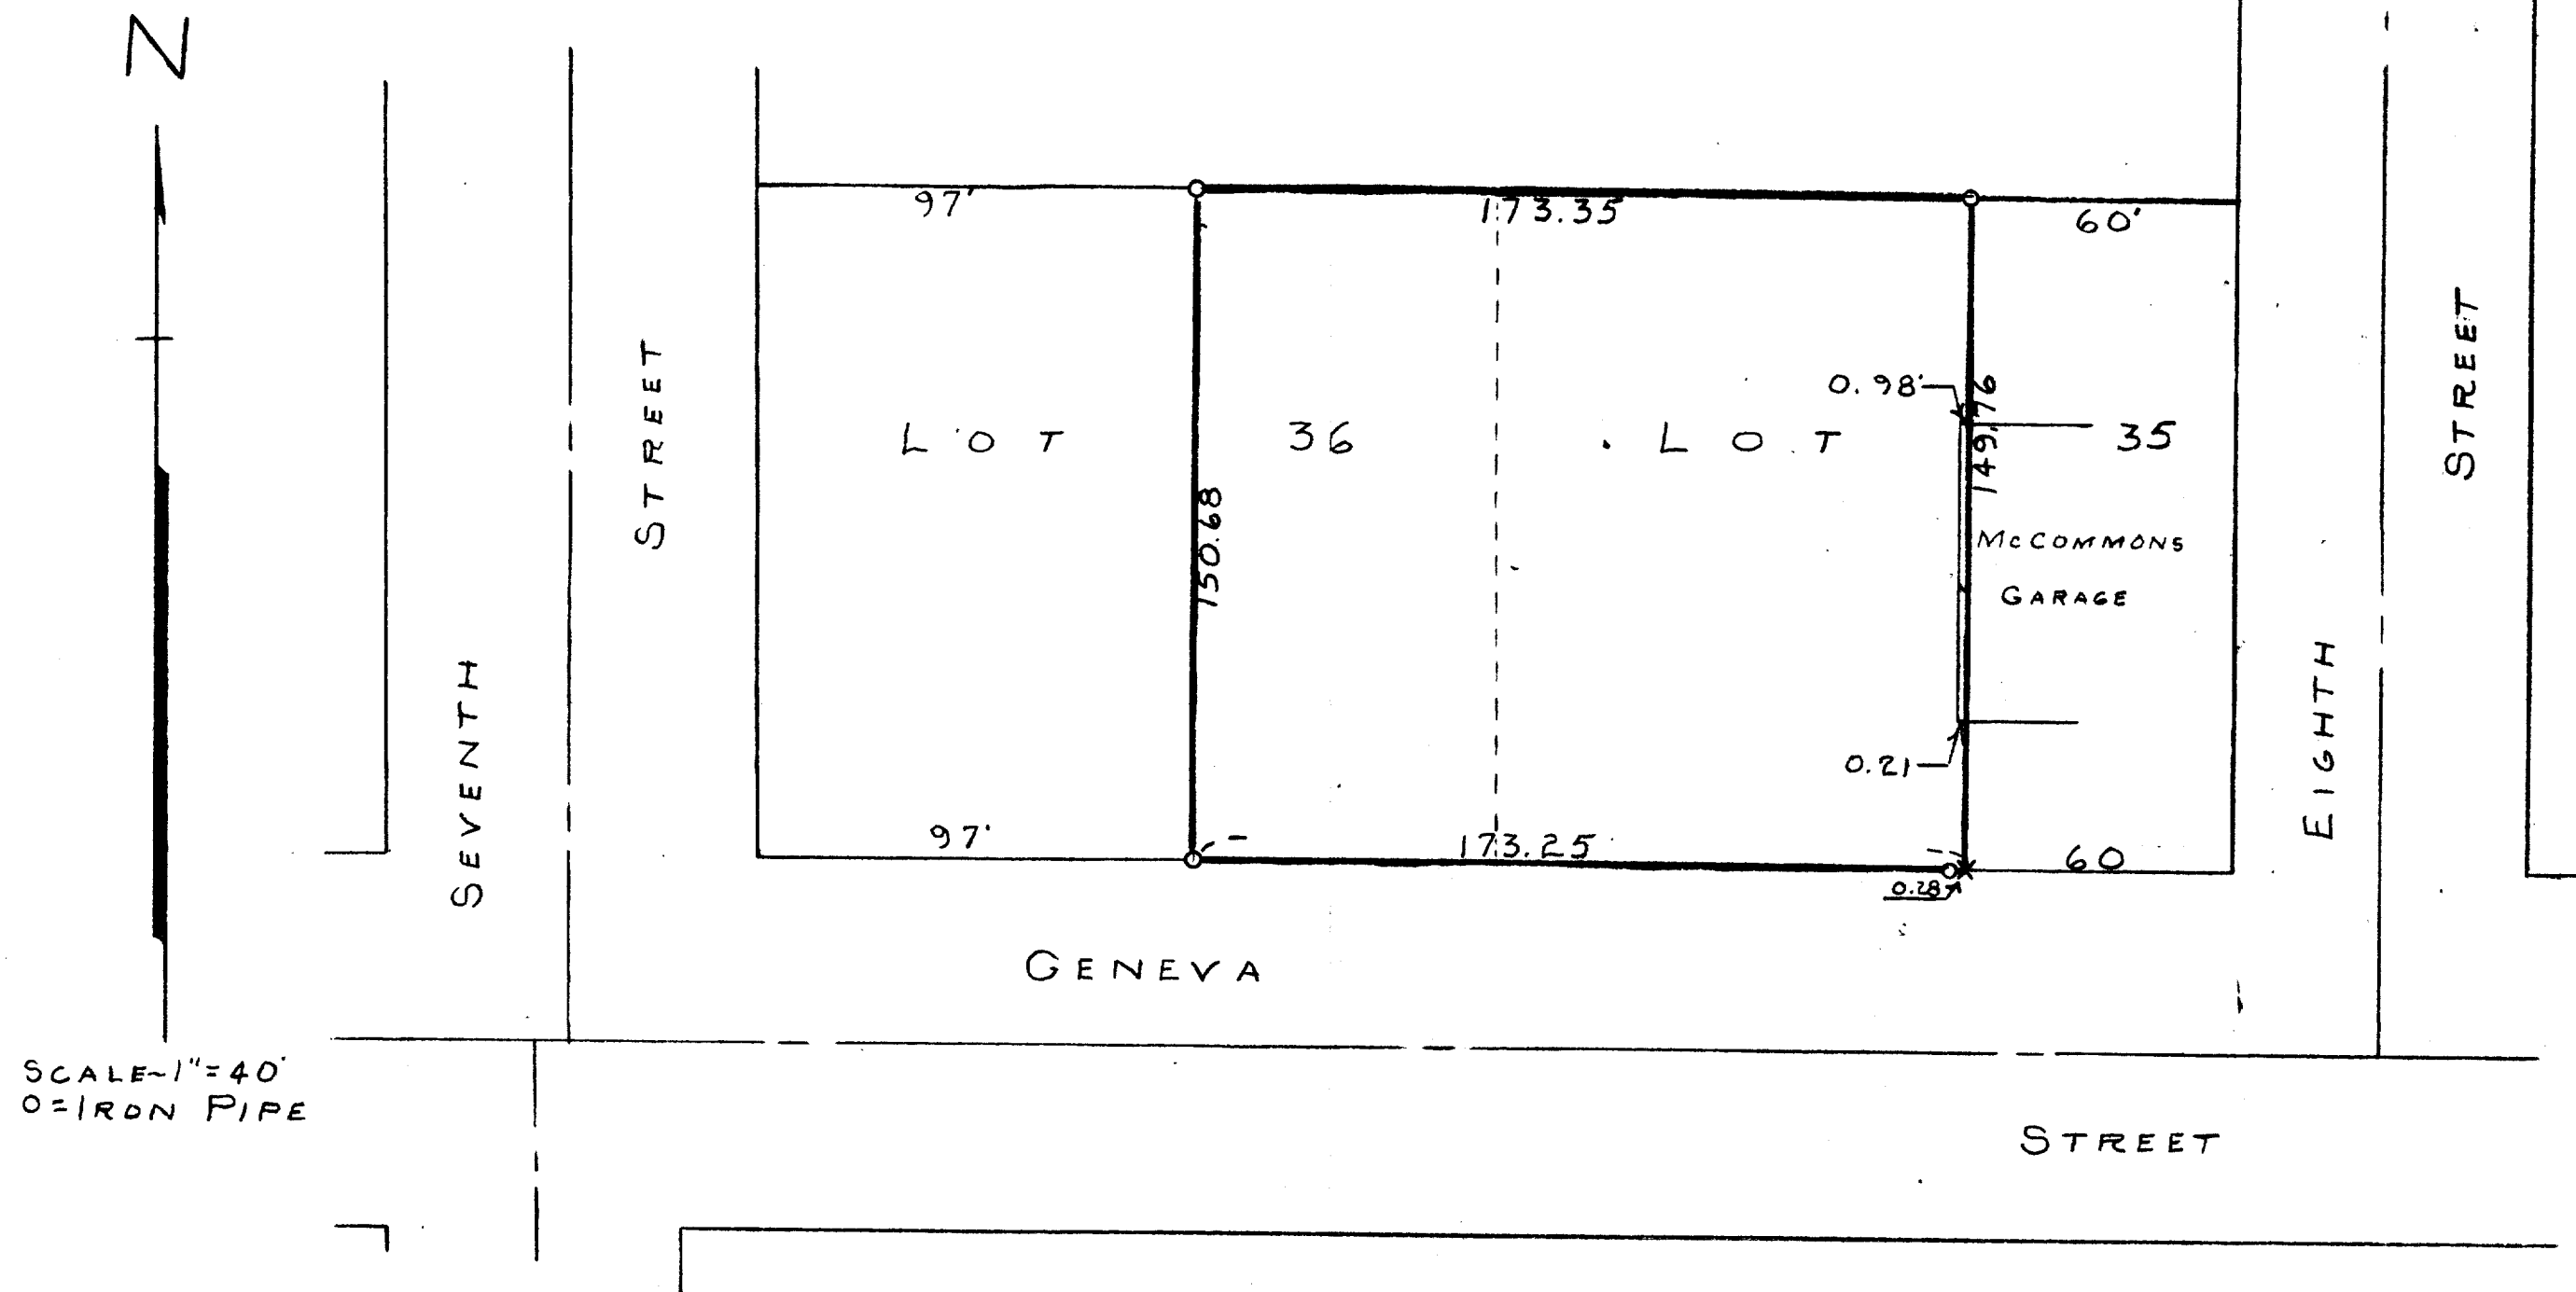

PLAT OF SURVEY OF PART OF LOTS 35 AND 36, BLOCK 13, PASSAGE, ARAM, AND DOWNIE'S ADDITION, CITY OF DELAVAN, WALWORTH COUNTY, WISCONSIN
OCTOBER 1955

George T. Dunham
GEORGE T. DUNHAM, SURVEYOR
DELAVAN, WISCONSIN

XP-180.179

2-37