


N
 SCALE 1"=20'
 ●=CONC. MONU
 ○=IRON PIPE

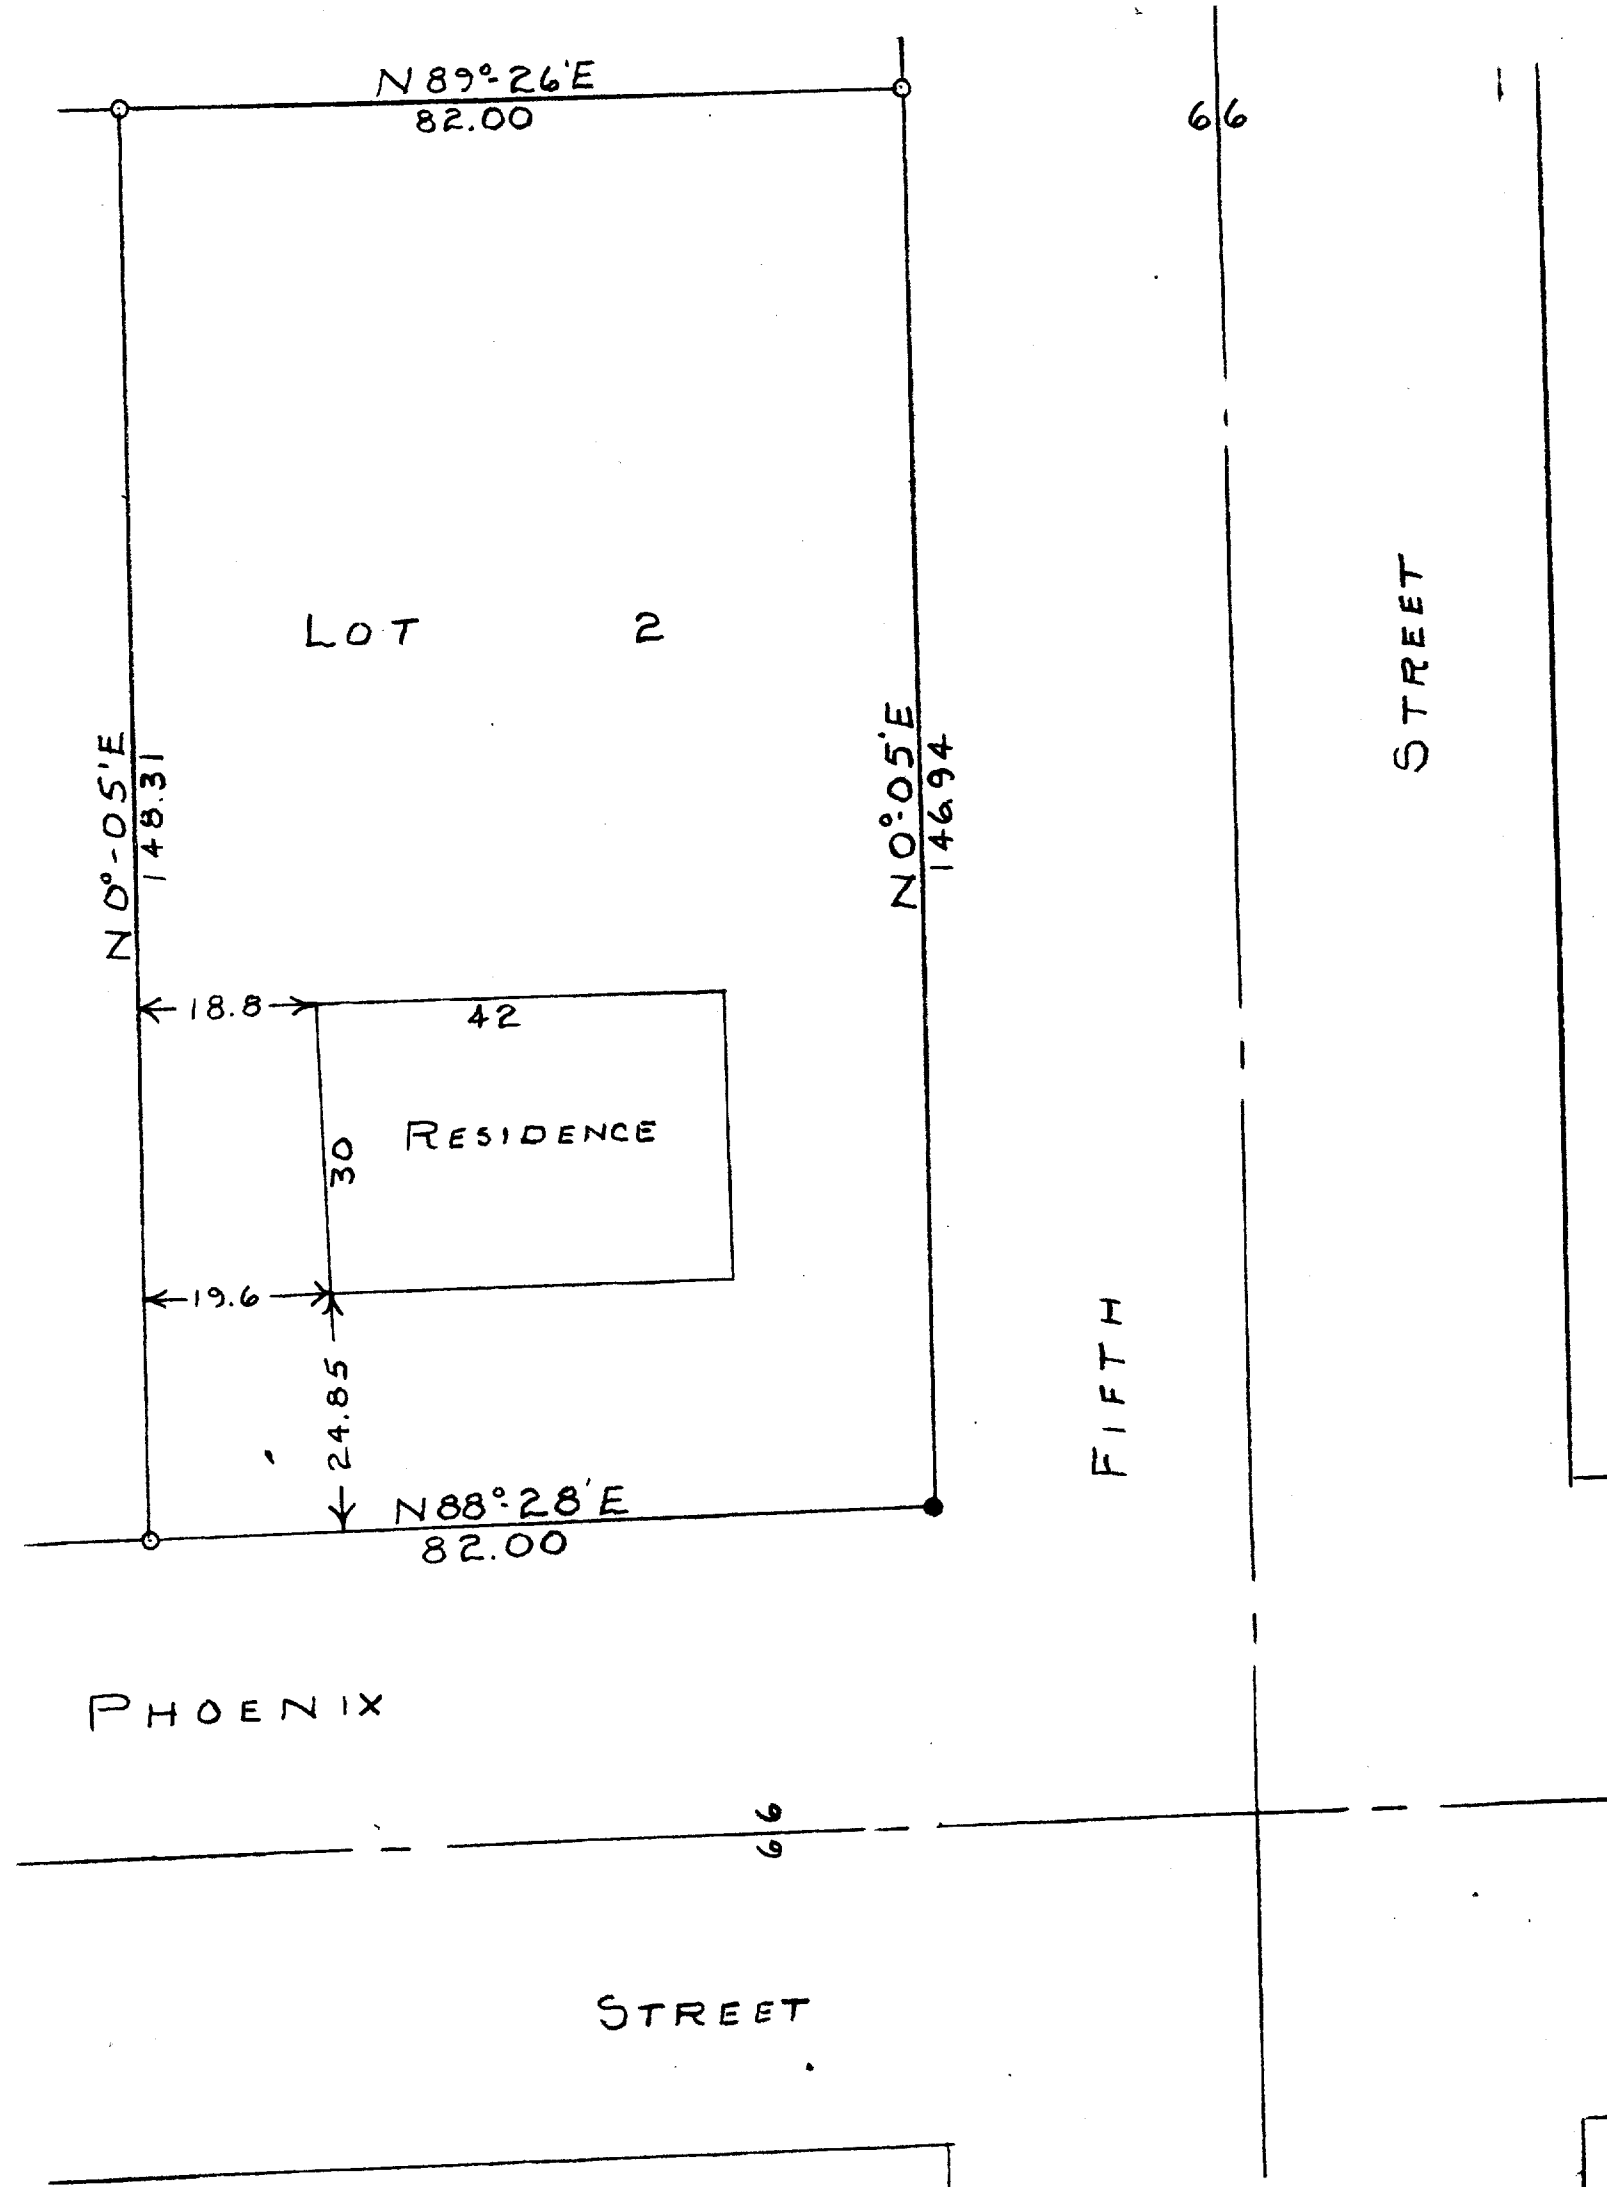

STATE OF WISCONSIN)
 COUNTY OF WALWORTH)
 I, GEORGE T. DUNHAM, DO HEREBY CERTIFY THAT I HAVE SURVEYED
 THE PROPERTY DESCRIBED AS FOLLOWS:
 LOT 2 OF KNAPP'S SUBDIVISION LOCATED IN THE CITY OF DELAVAN,
 WALWORTH COUNTY, WISCONSIN.
 AND THAT THE PLAT SHOWN ABOVE IS A CORRECT REPRESENTATION OF THE PROPERTY
 LINES
 DEC 16, 1955

George T. Dunham
 GEORGE T. DUNHAM, SURVEYOR
 DELAVAN, WISCONSIN 2-39