

GEORGE T. DUNHAM  
SURVEYING & SUBDIVIDING  
DELAVER, WISCONSIN


N



Scale - 1" = 10'  
O = Iron Pipe

STREET  
(82.50')

TERRACE

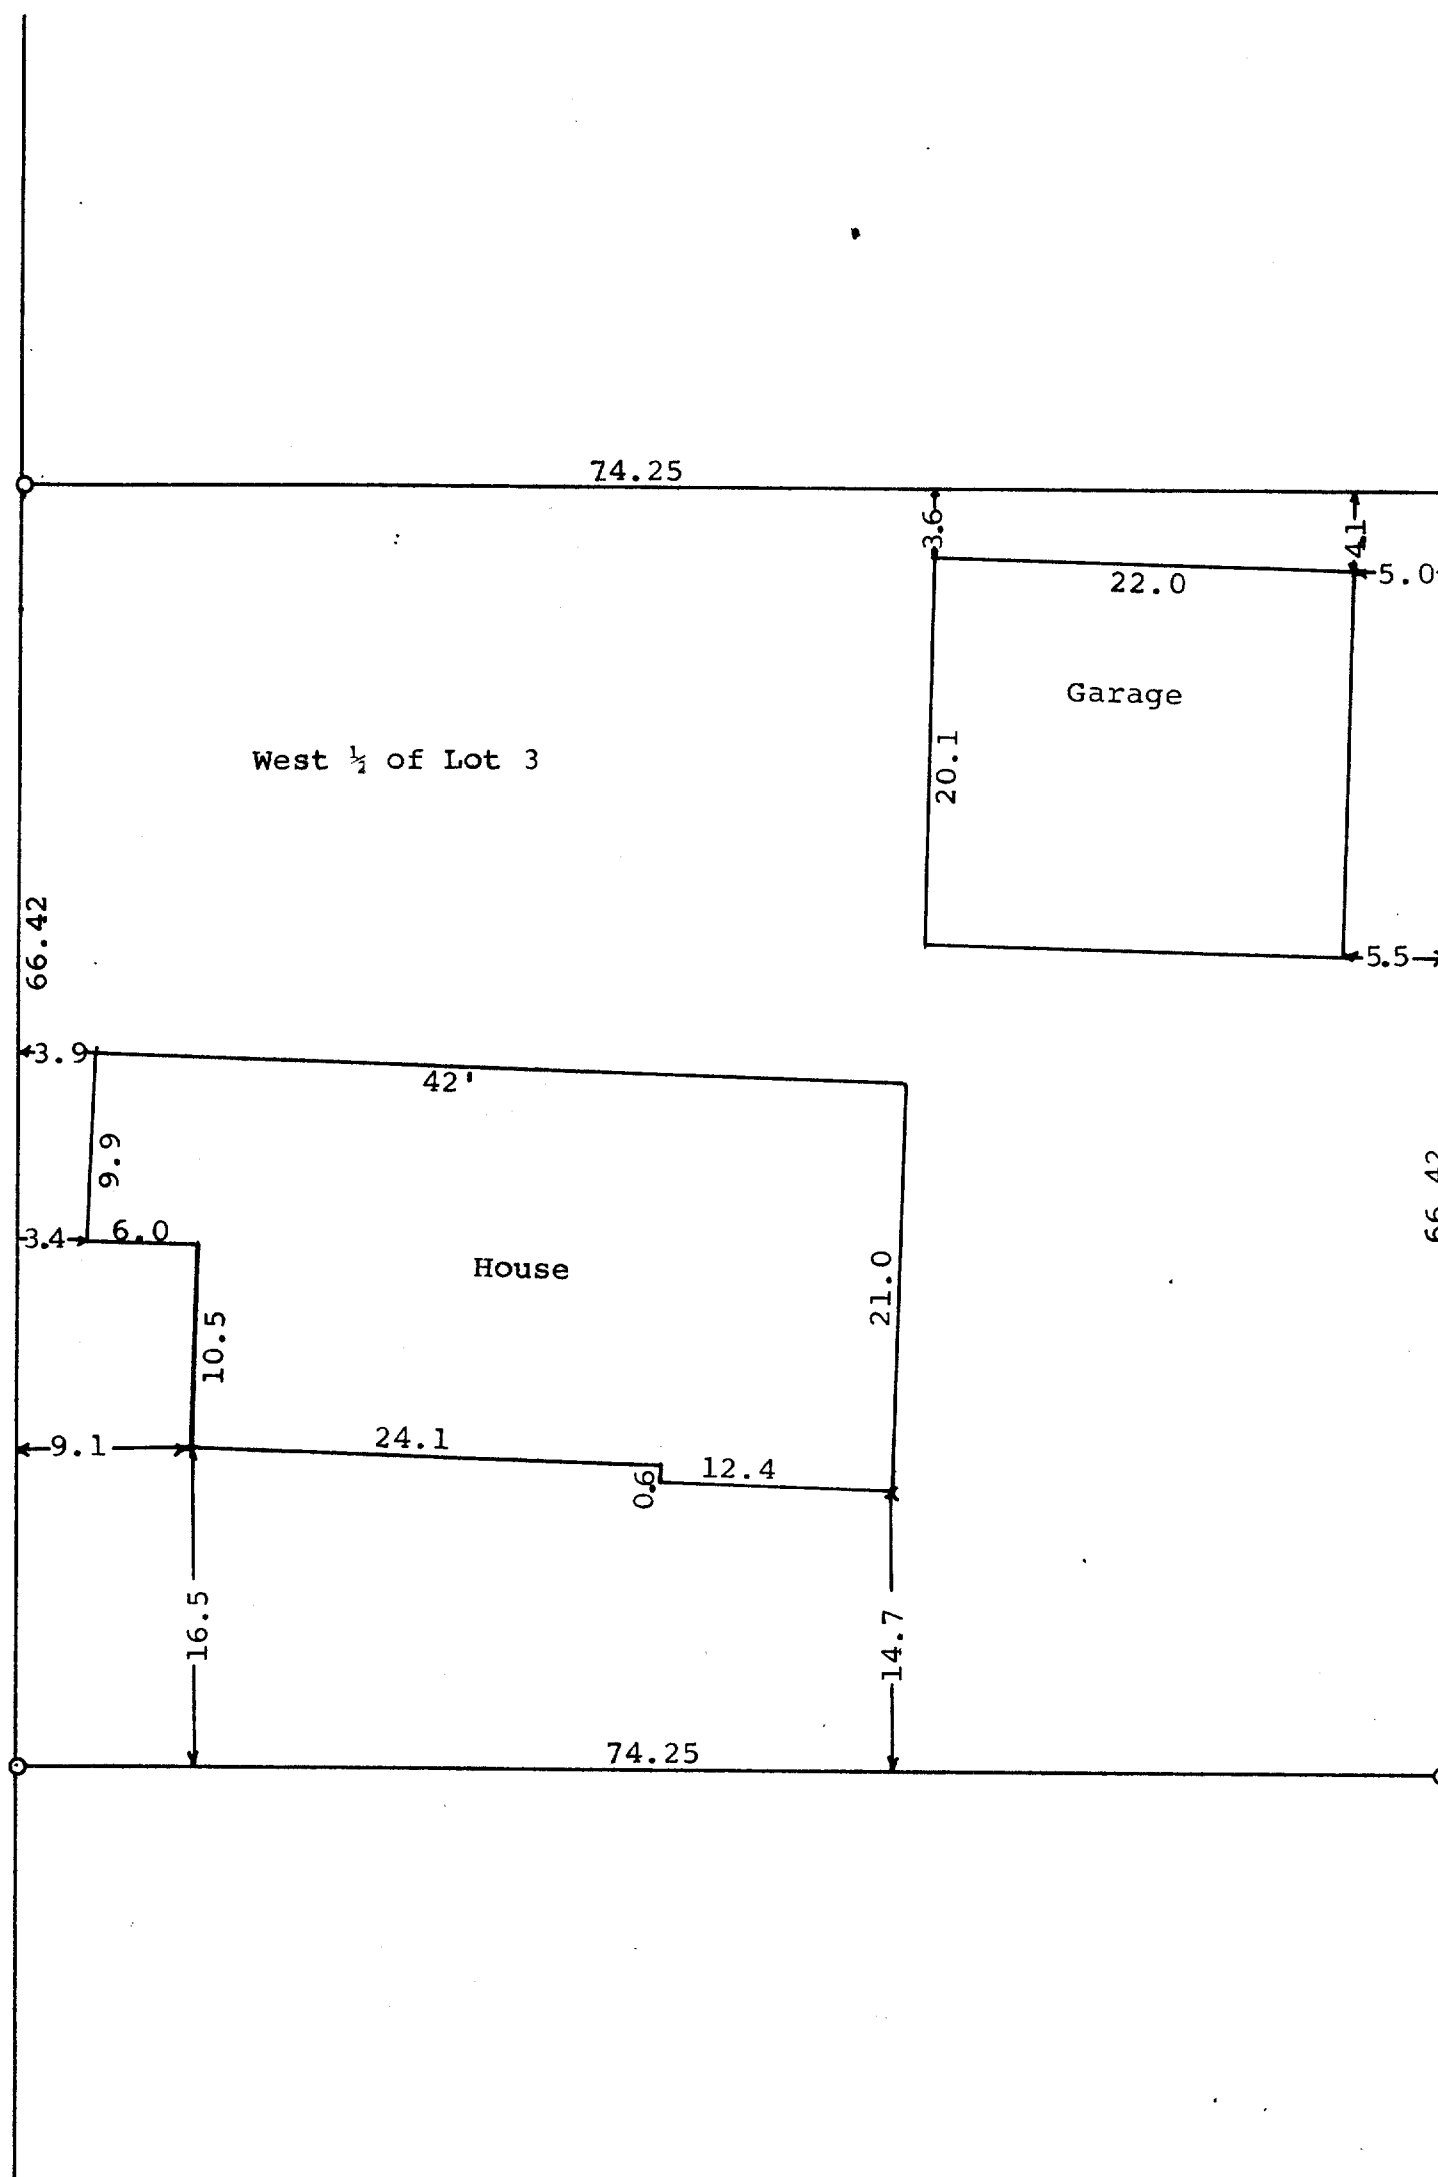

STATE OF WISCONSIN)  
WALWORTH COUNTY ) SS

I, George T. Dunham, Surveyor, certify that I have surveyed the property described as follows,  
The West 1/2 of Lot 3, Block 22 of the Original Town (Now City) of Delavan, Walworth County, Wisconsin and the aboveplat is an accurate survey and a true representation thereof and correctly shows the exterior boundary lines and location of buildings on said property and the correct measurements thereof.  
January 10, 1968

*George T. Dunham*  
George T. Dunham, Surveyor