


GEORGE T. DUNHAM
SURVEYING & SUBDIVIDING
DELAVER, WISCONSIN

N

Scale - 1" = 20'
o = Iron Pipe

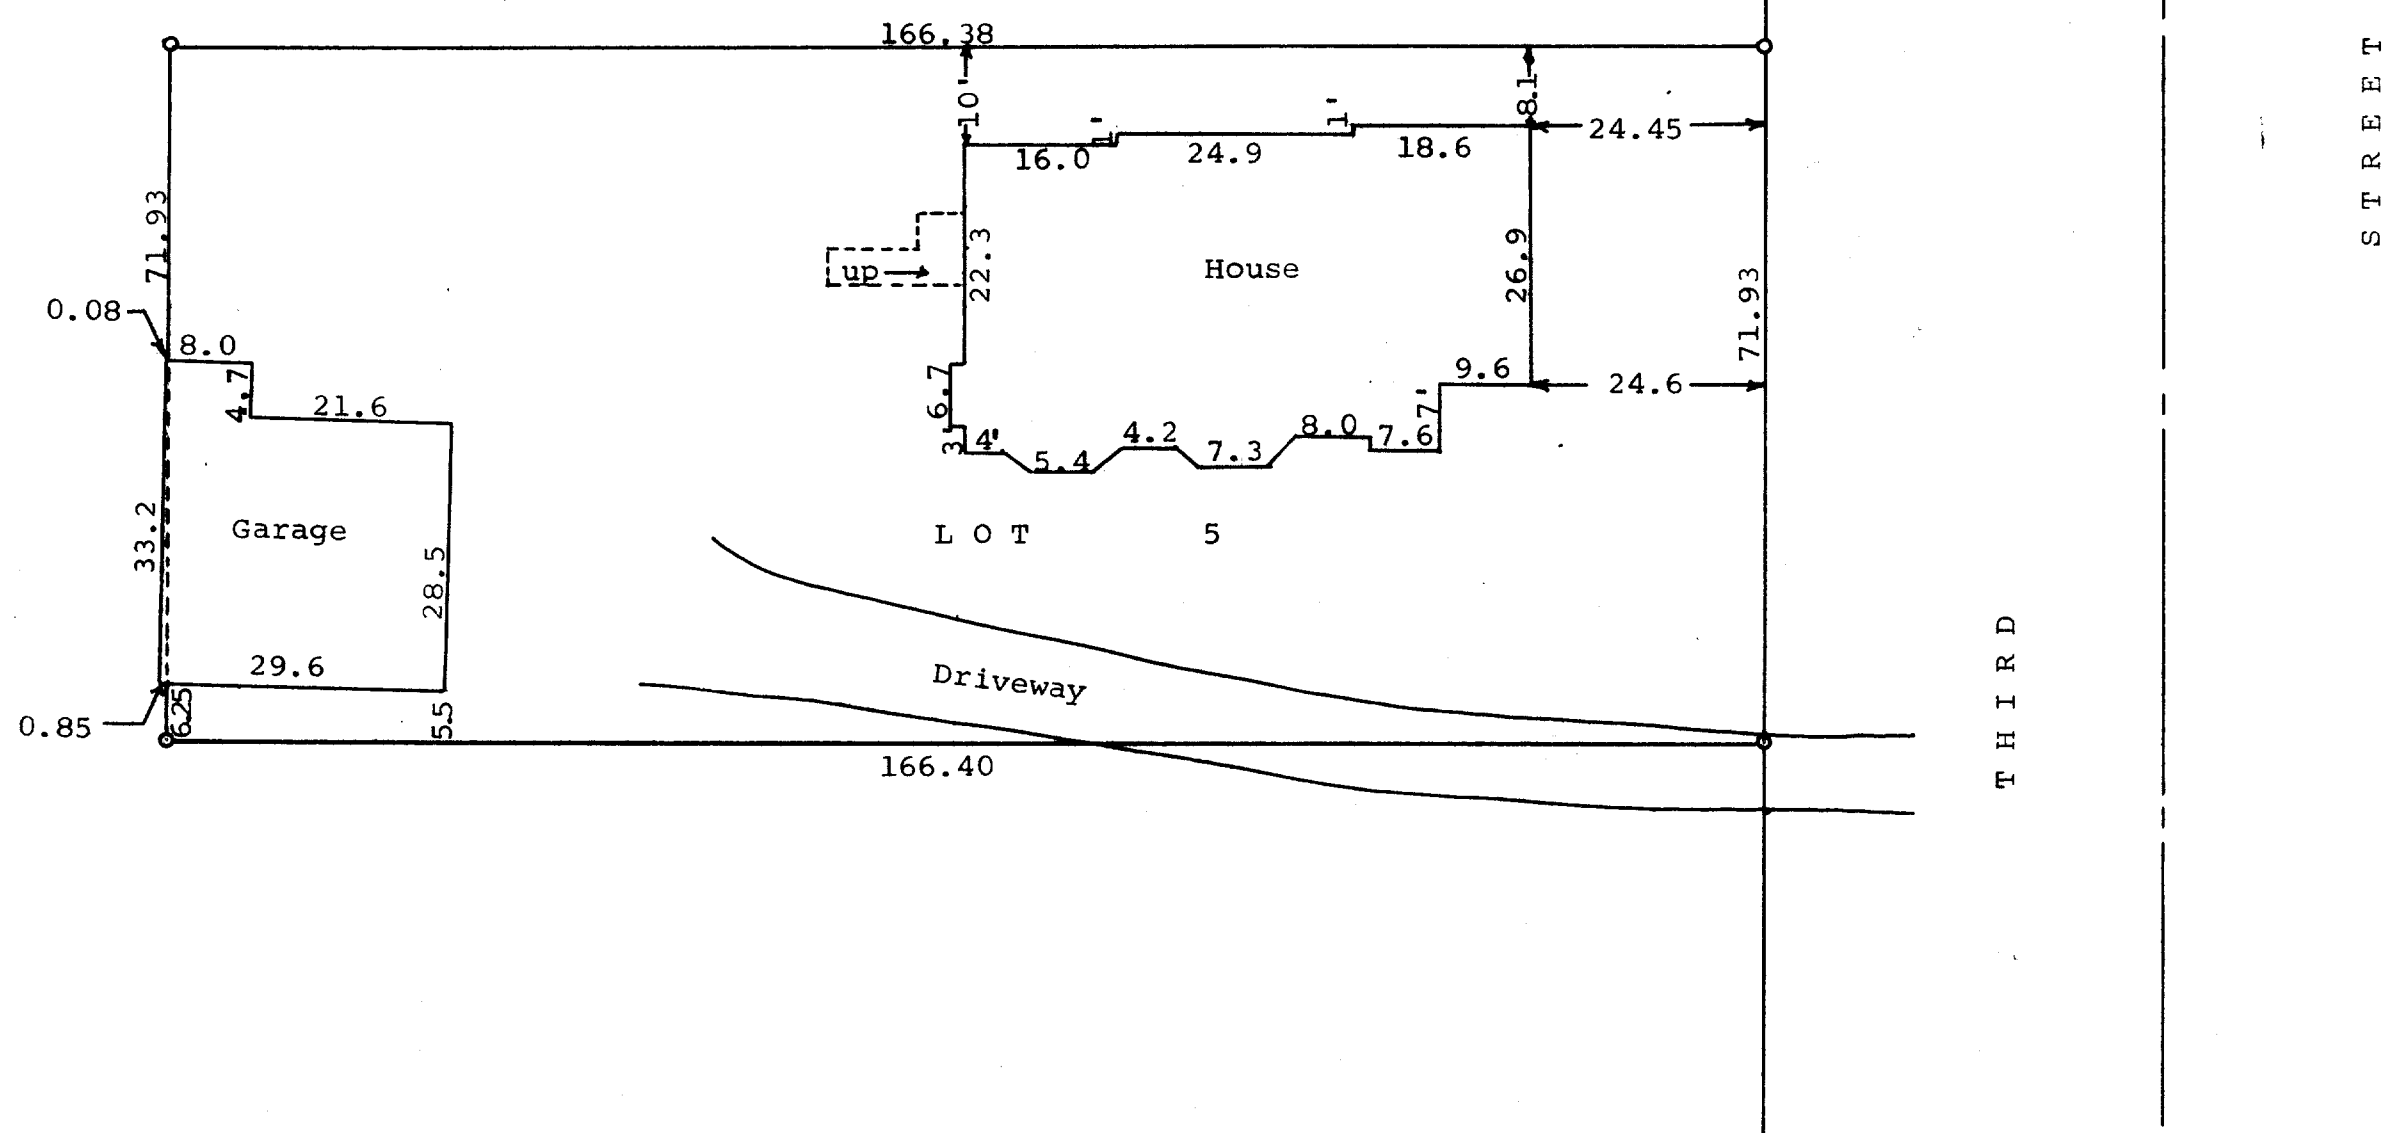

STATE OF WISCONSIN)
WALWORTH COUNTY) SS
I, George T. Dunham, Surveyor, certify that I have surveyed the property described as follows,
Lot 5, Block 17 of the Original Plat of the City of Delavan, Walworth County, Wisconsin
and that the above plat is an accurate survey and a true representation thereof and correctly shows the exterior boundary lines and location of the buildings on said property and the correct measurements thereof.
July 14, 1967

George T. Dunham
George T. Dunham, Surveyor