


GEORGE T. DUNHAM
SURVEYING & SUBDIVIDING
DELAVAN, WISCONSIN

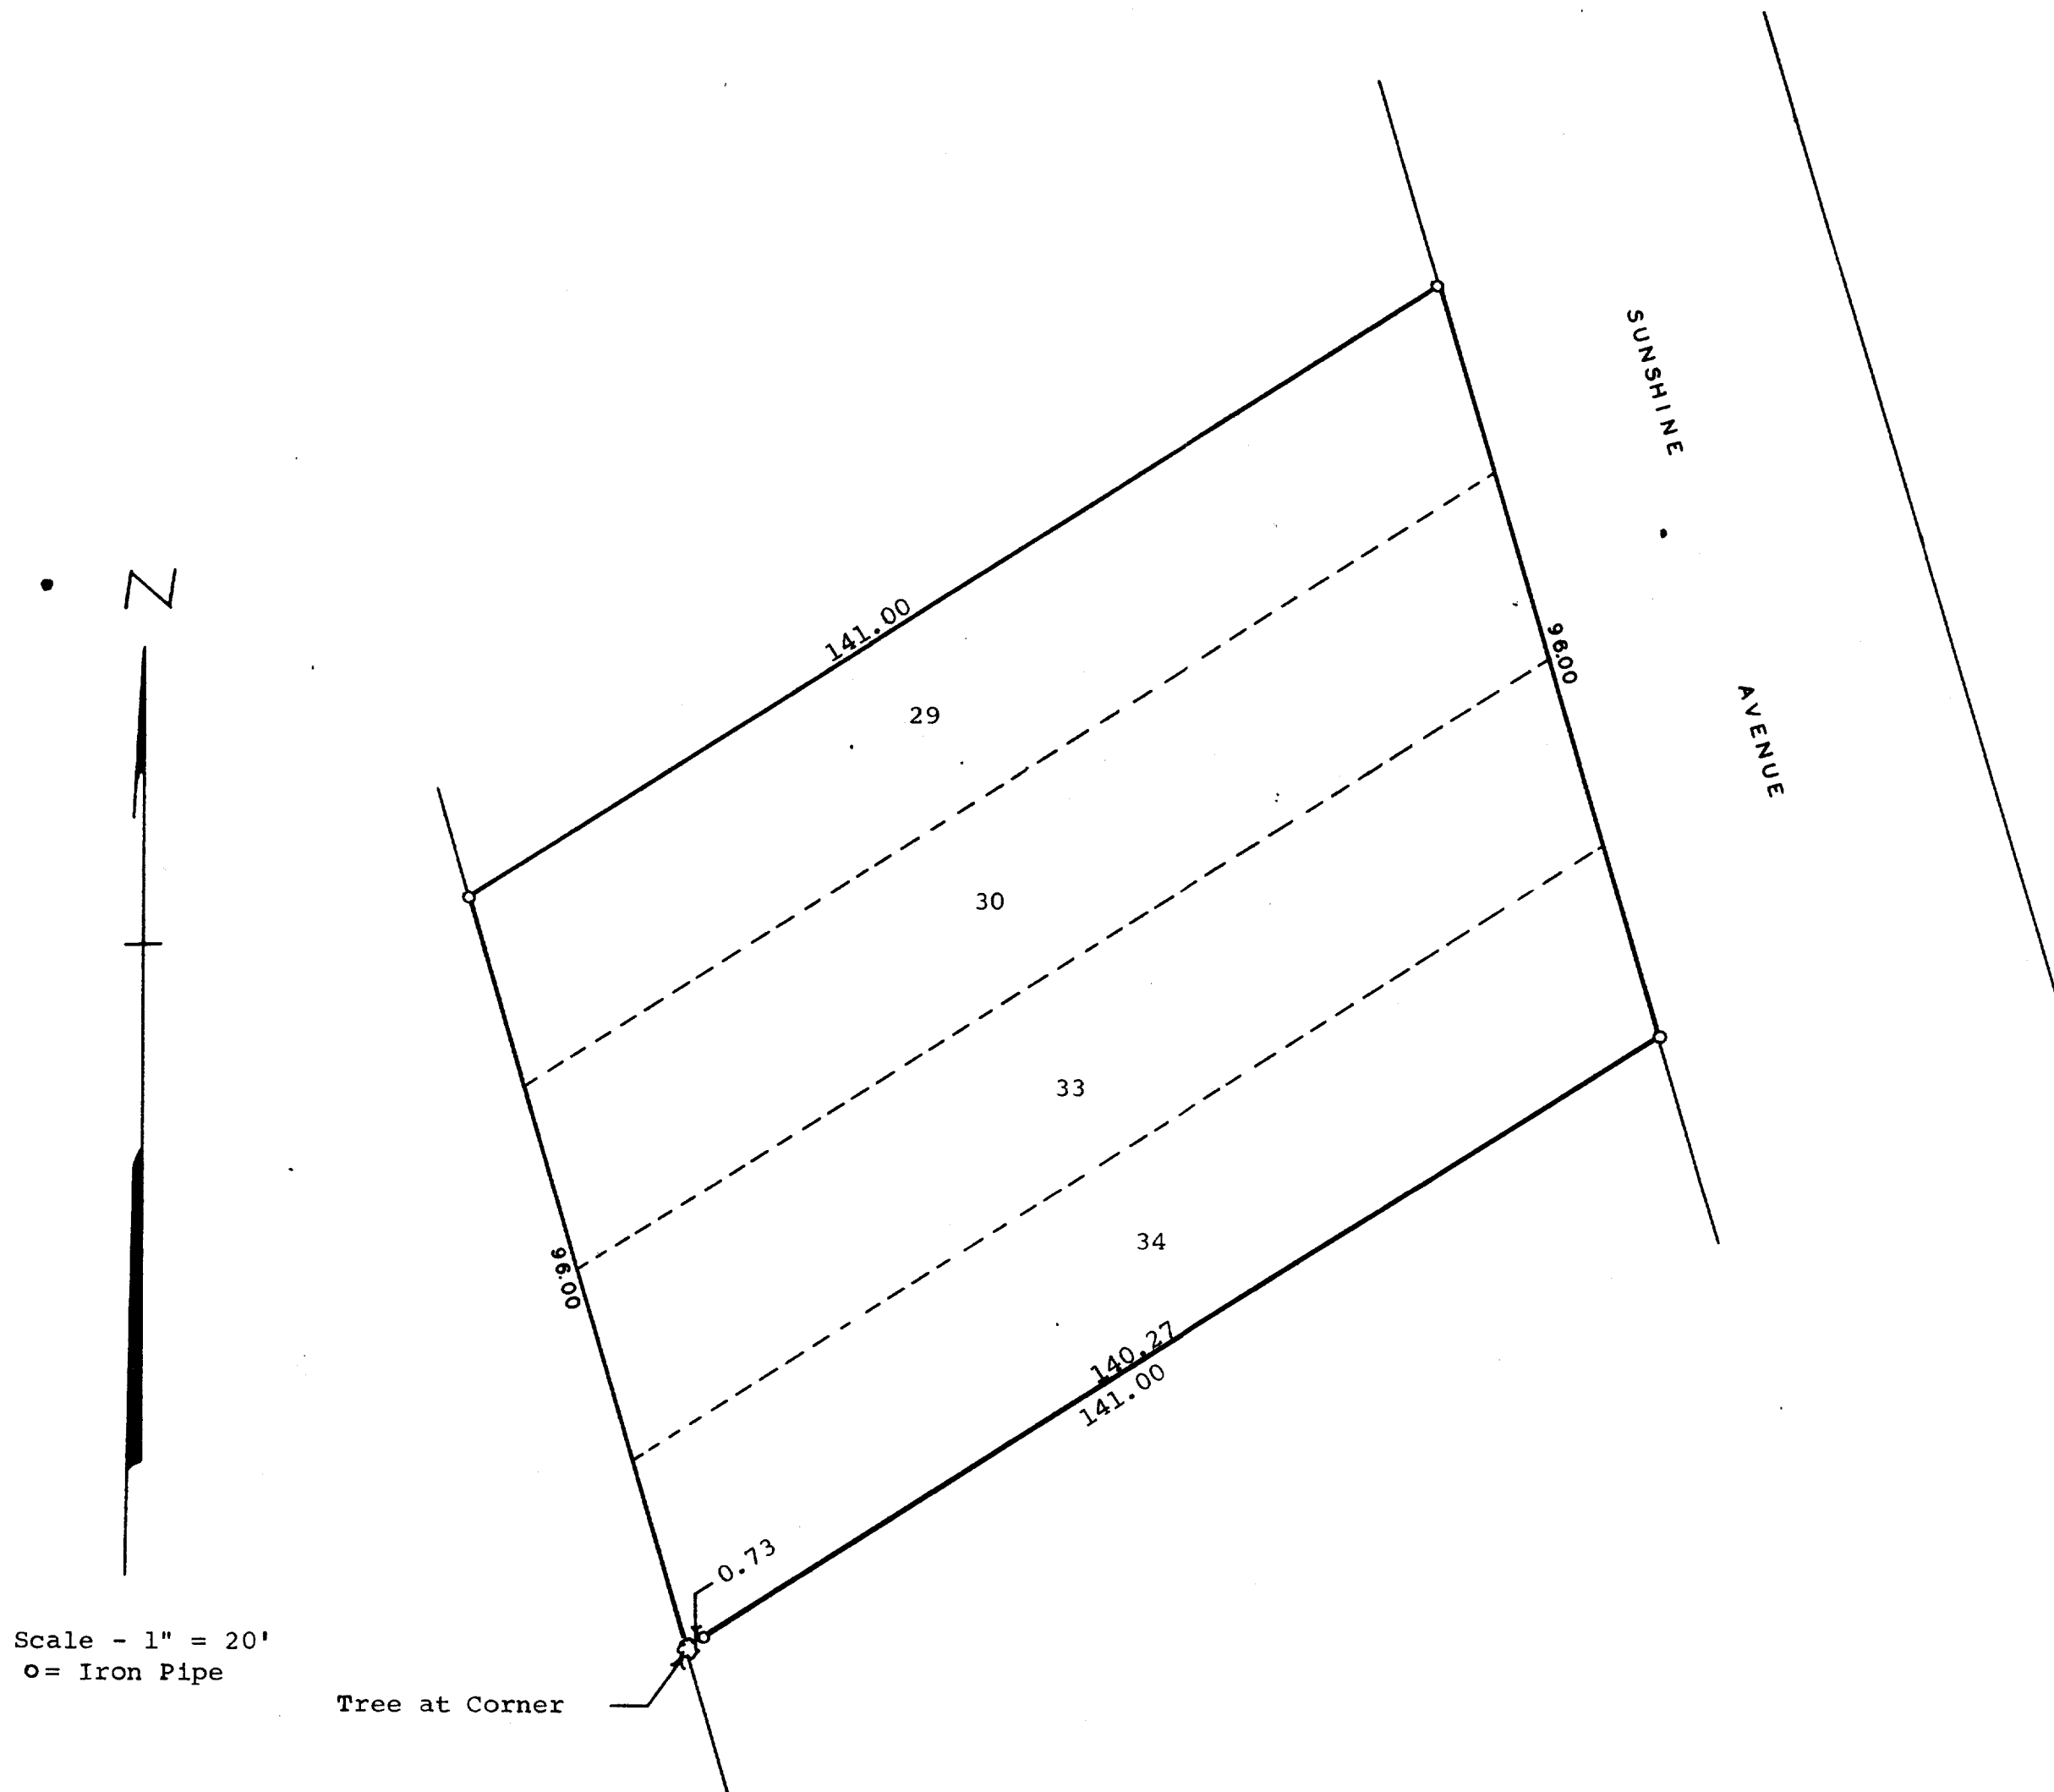

Plat of survey of Lots 29, 30, 33, & 34, Block 1,
Delaview Subdivision, City of Delavan, Walworth
County, Wisconsin.
July 5, 1967

George T. Dunham
George T. Dunham, Surveyor