


N

SCALE-1"=20'

○=IRON PIPE

●=CONC. MONU.

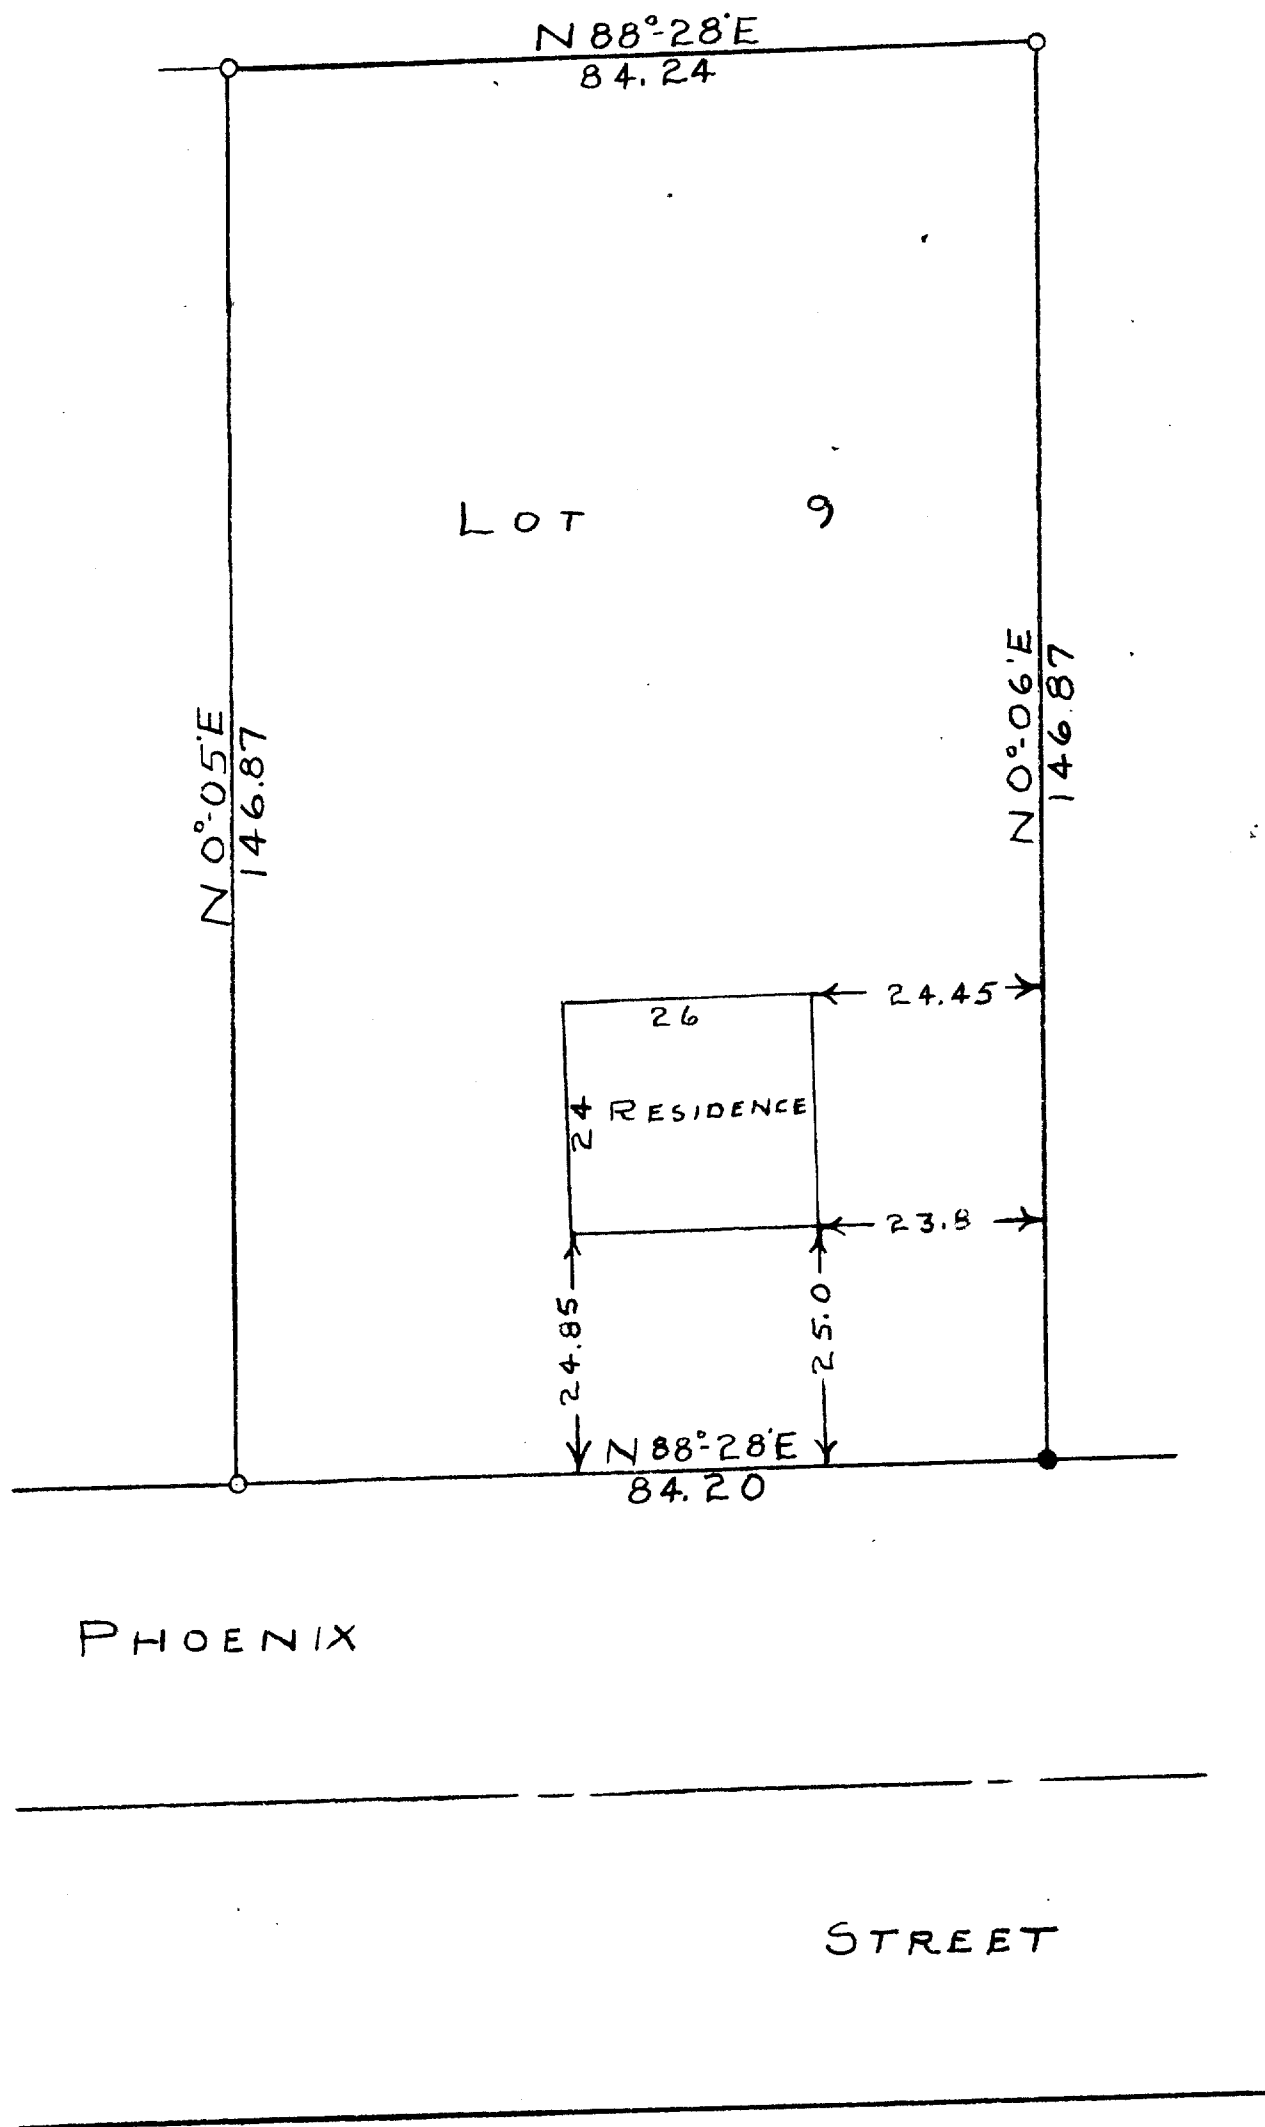

STATE OF WISCONSIN) ss
COUNTY OF WALWORTH)

I, GEORGE T. DUNHAM, DO HEREBY CERTIFY THAT I HAVE SURVEYED
THE PROPERTY DESCRIBED AS FOLLOWS:
LOT 9 OF KNAPP'S SUBDIVISION LOCATED IN THE CITY OF DELAVAN
WALWORTH COUNTY, WISCONSIN
AND THAT THE PLAT SHOWN ABOVE IS A CORRECT REPRESENTATION OF THE
PROPERTY LINES.
JAN. 3, 1956

George T. Dunham
GEORGE T. DUNHAM, SURVEYOR
DELAVAN, WISCONSIN.