


Southeast Corner of Lot 43
Tyrrell's Subdivision

Edwards Street

N

Scale - 1" = 100'
O = Iron Pipe

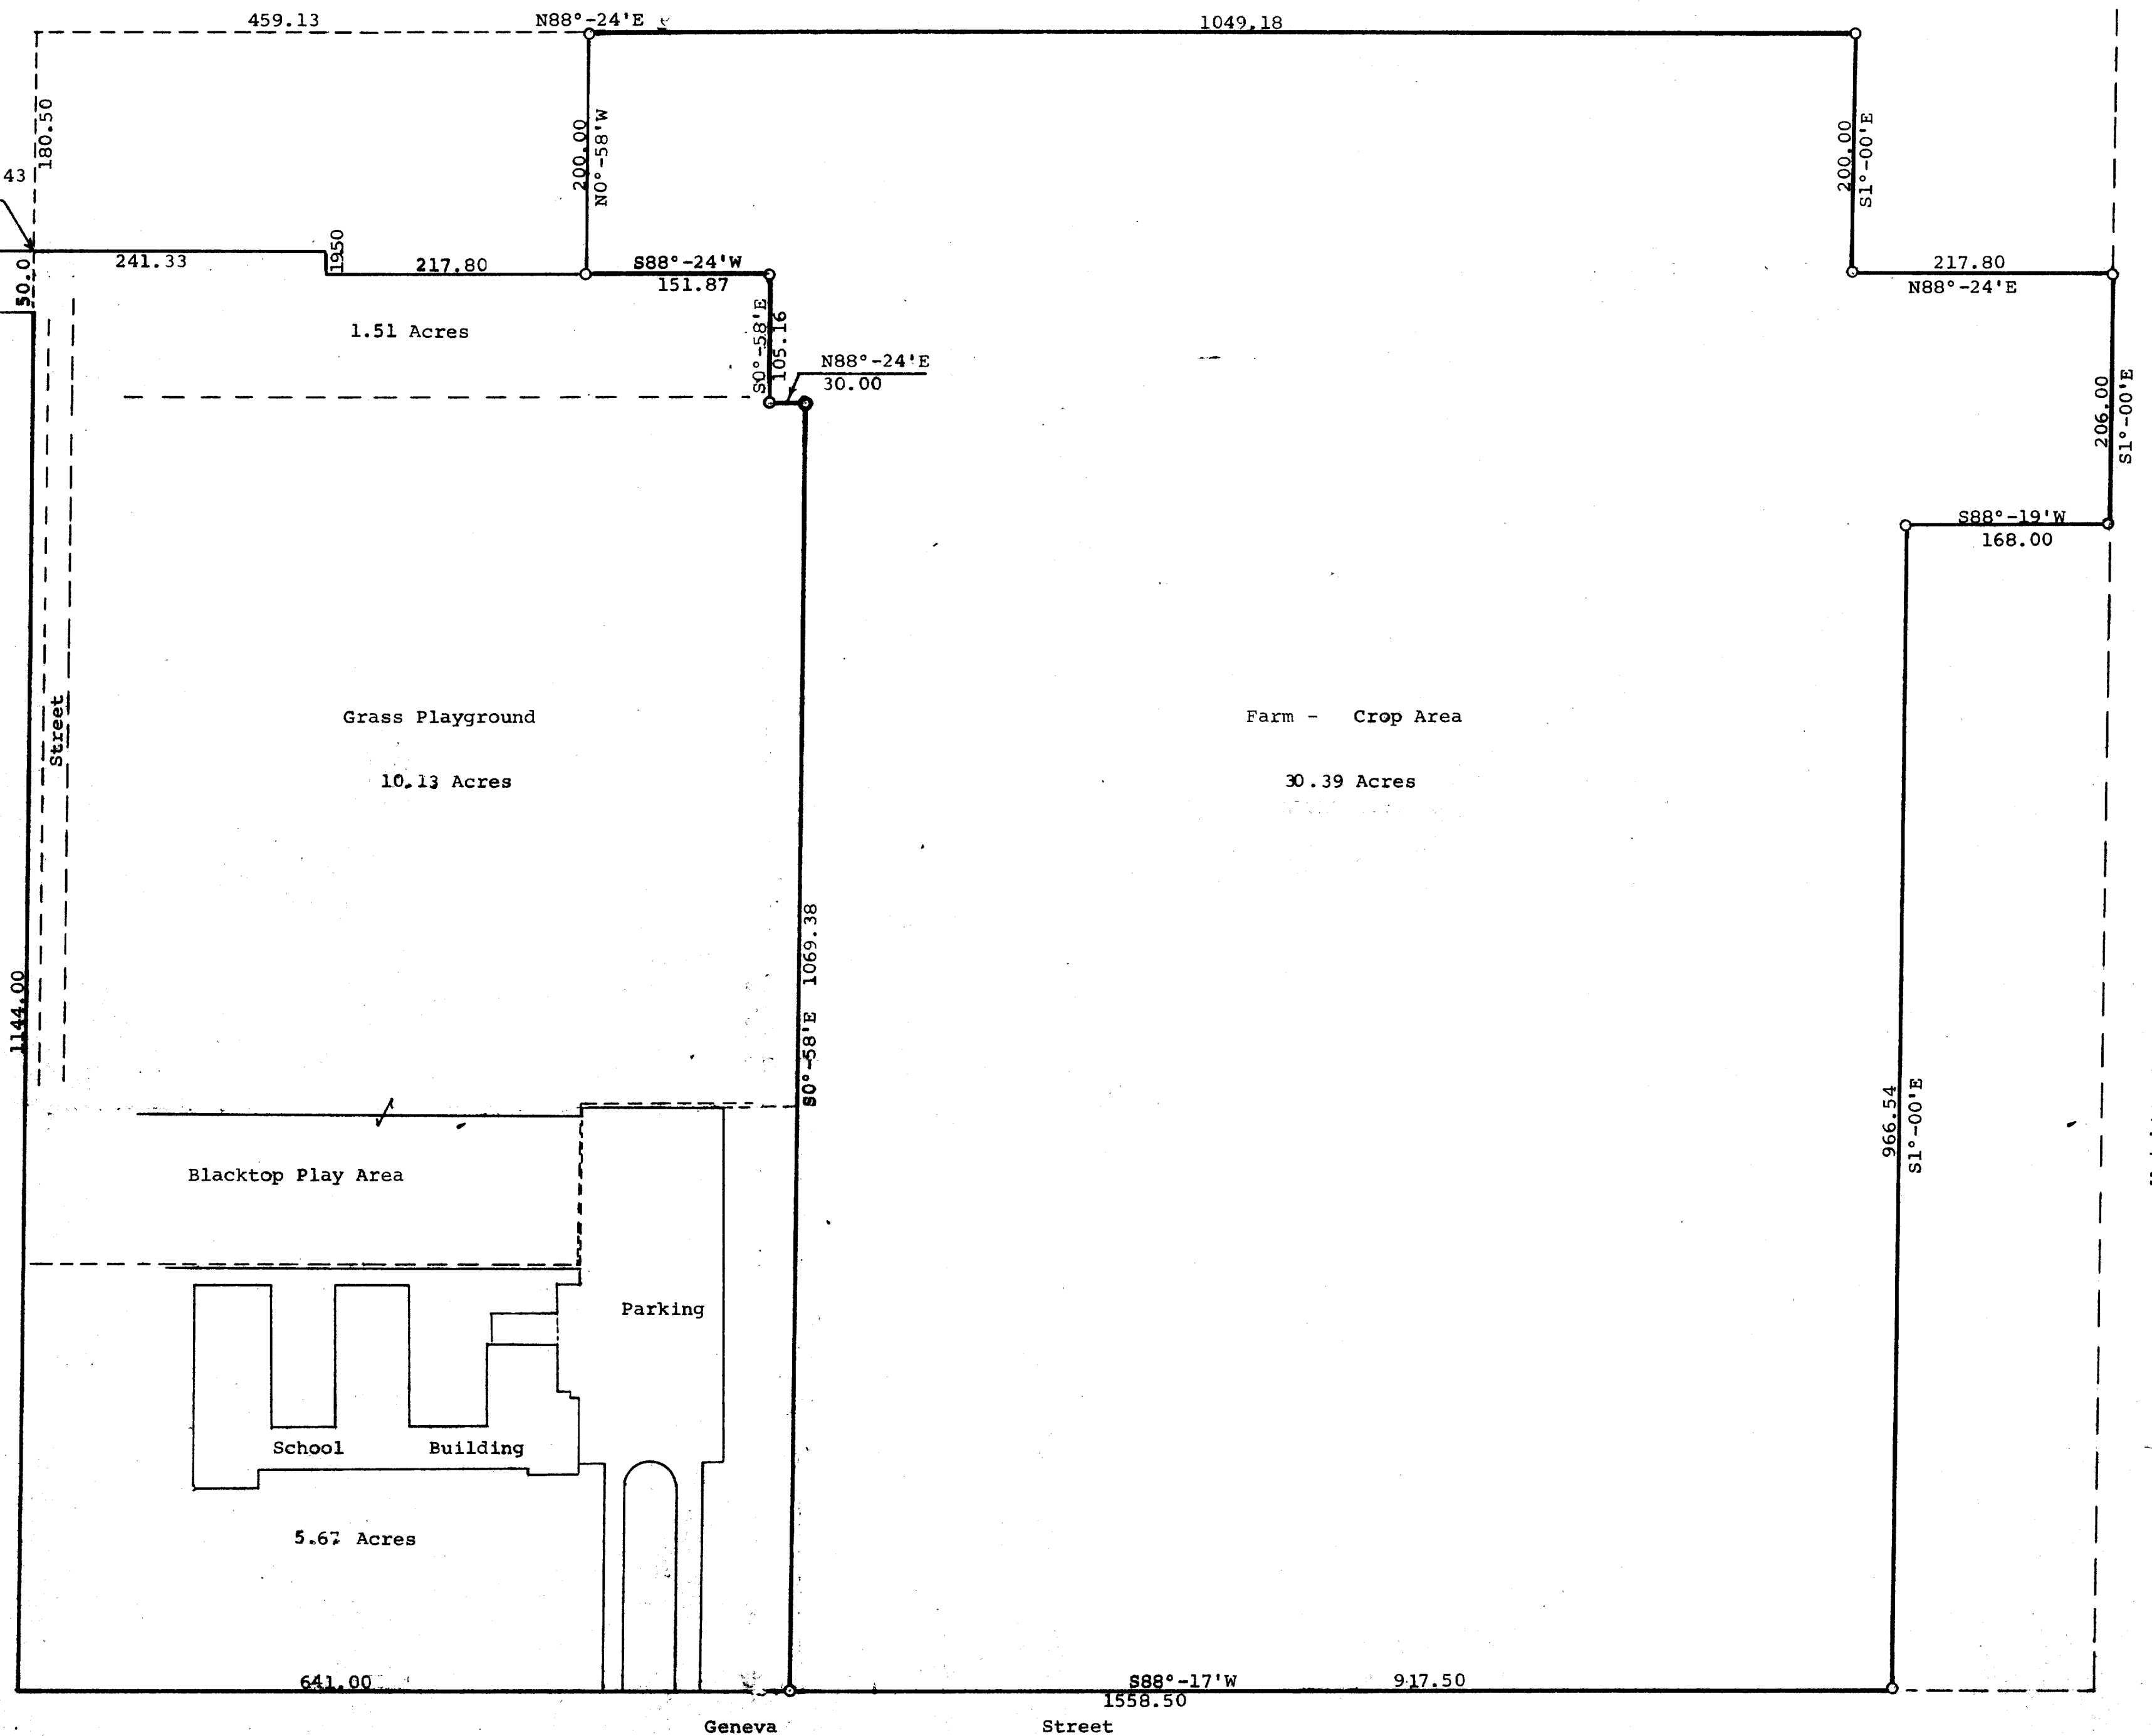

Plat of survey of the Elementary School Property located in the South ½
of Section 17, T 2 N, R 16 E, City of Delavan, Walworth County, Wisconsin.
June 23, 1970
Revised 7/9/70
Revised 7/18/70
Revised 1/4/71

George F. Dunham
George F. Dunham, Surveyor
Delavan, Wisconsin

UP-13 (RVD)