



NORTHEAST CORNER OF
SECTION 17-2-18

PLAT OF PROPERTY OWNED BY STA-RITE PRODUCTS, INC. AND OF THE MAJOR
IMPROVEMENTS LOCATED ON SAID PROPERTY IN THE EAST 1/2 OF SECTION 17,
T.2N. R.1E. CITY OF DELAVAN, WALWORTH COUNTY, WISCONSIN
APRIL 23, 1968
GEORGE T. DONHAM, SURVEYOR
DELAVAN, WISCONSIN

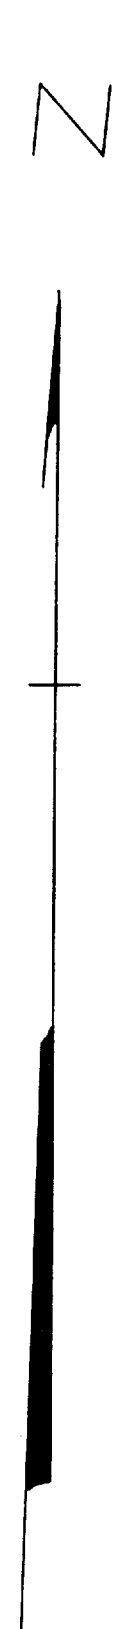

SCALE - 1"=60'
● - HYDRANT
○ - VALVE
□ - GAS PUMP

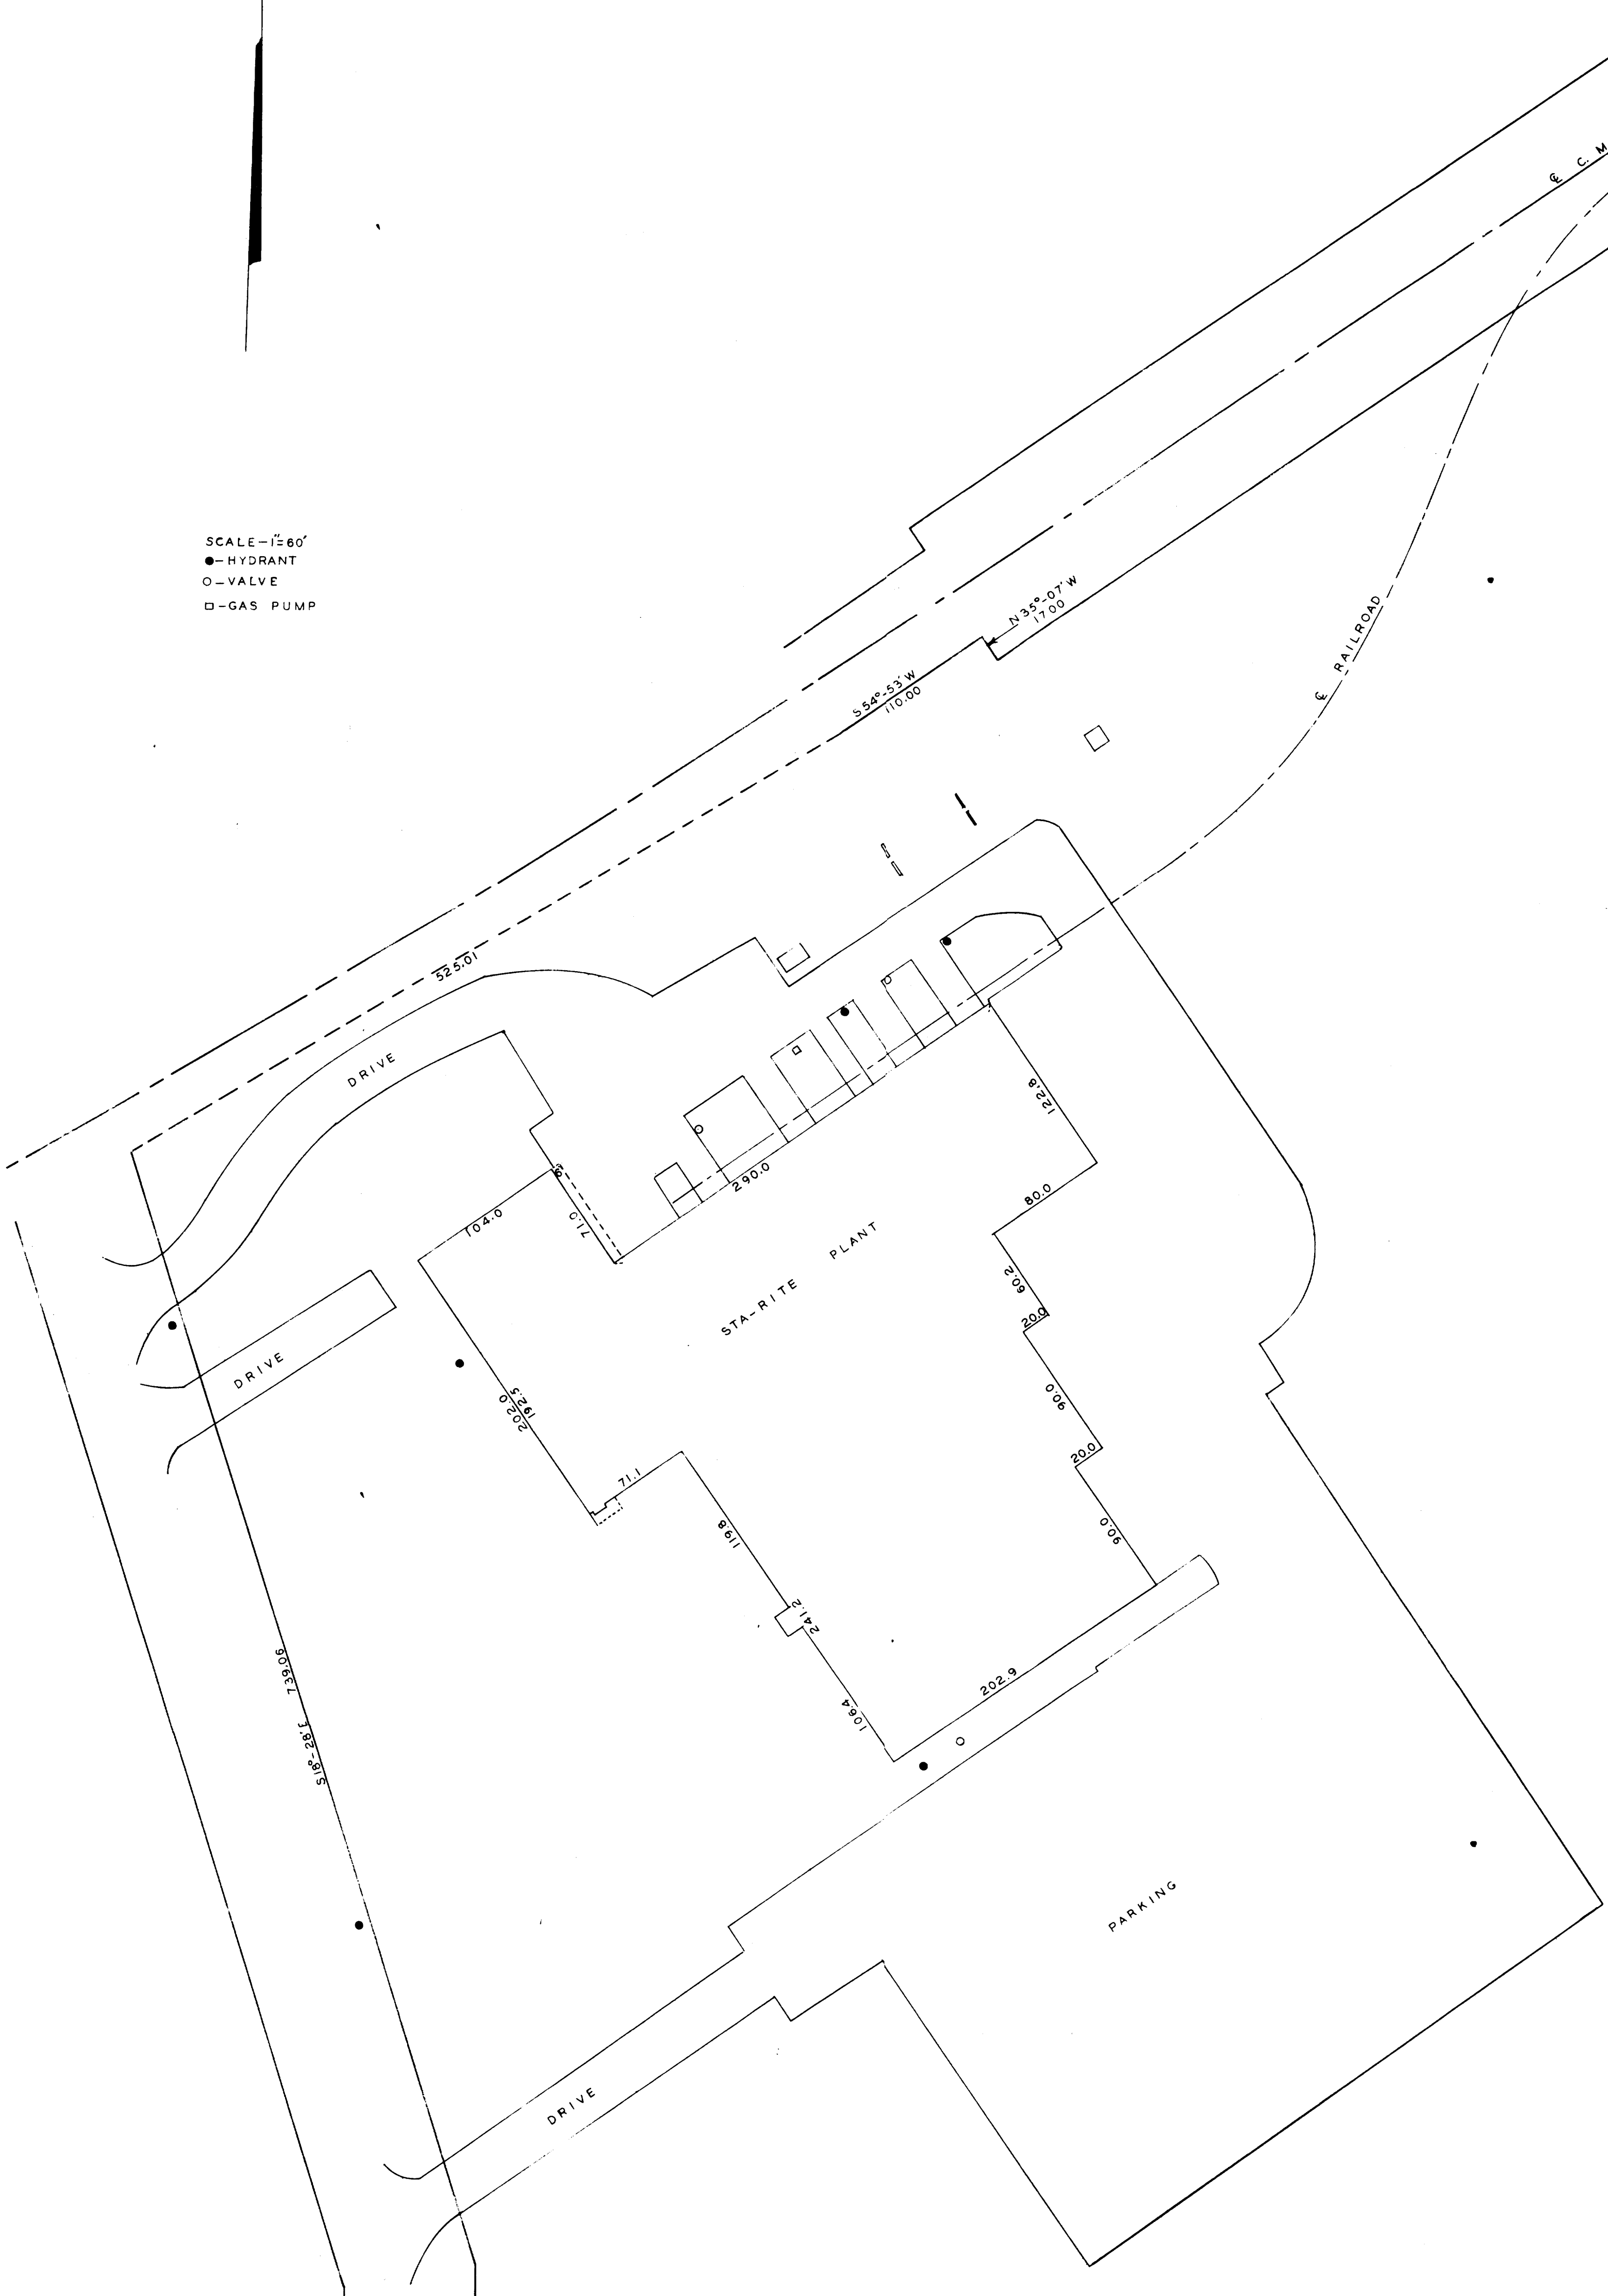

STREET

WRIGHT

S 1° 30' E 162.79
162.79

33.00

STATE TRUNK

N 80° 31' E 151.00

HIGHWAY NO. 50

252.41
28.24
280.65

33.00

N 86° 02' E
92.22

N 0° 54' W 3582.58
EAST LINE OF SECTION 17