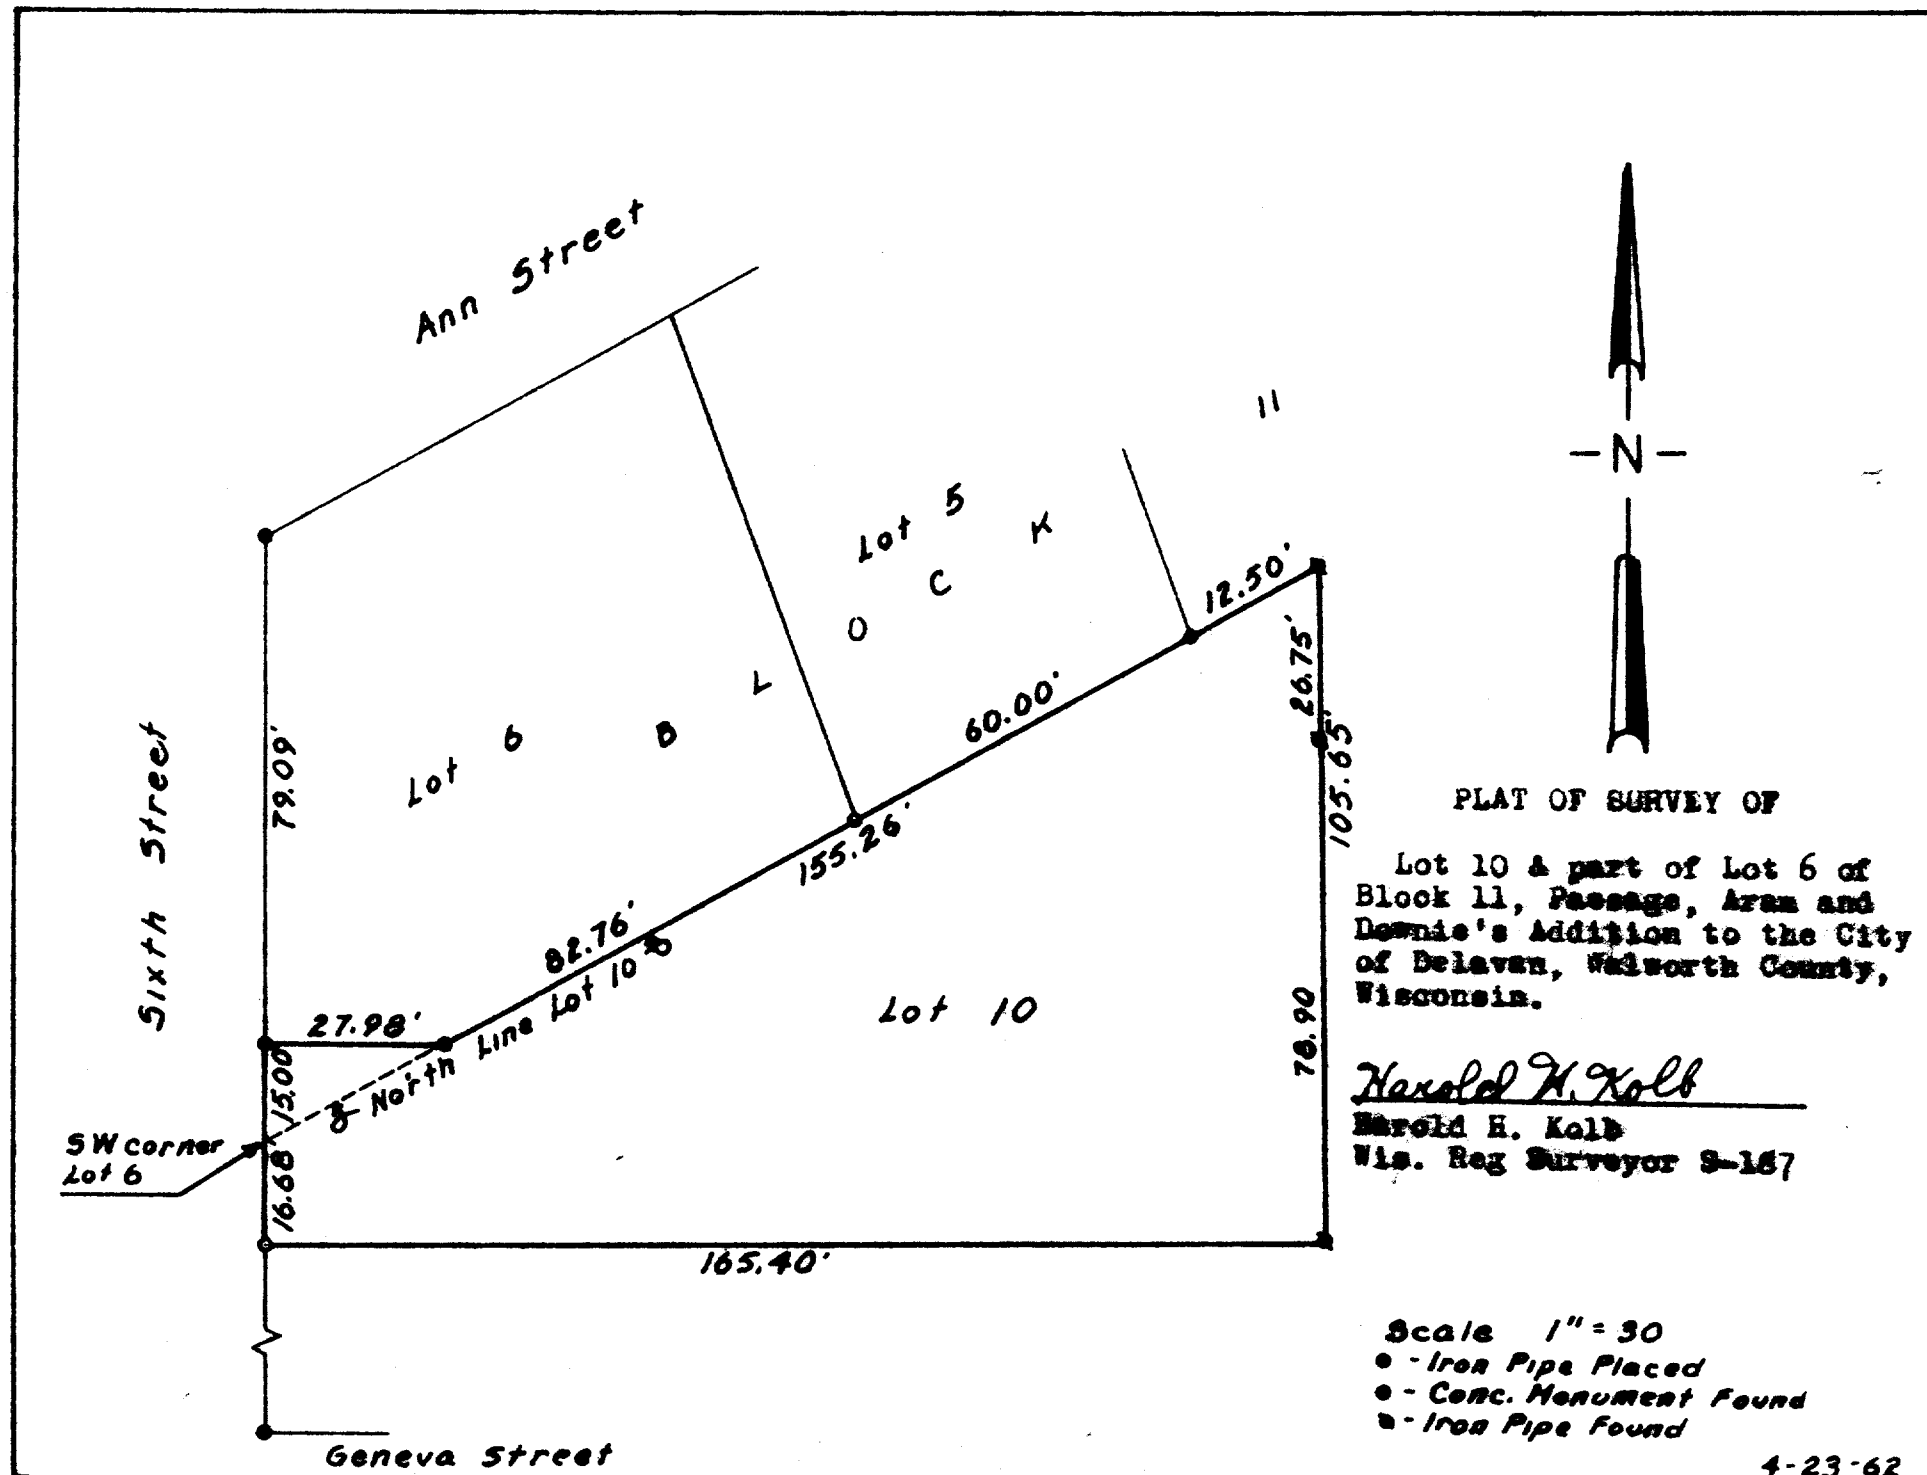


PLAT OF SURVEY OF

Lot 10 & part of Lot 6 of Block 11, Passage, Aram and Downie's Addition to the City of Delavan, Walworth County, Wisconsin.

Harold H. Kolb
 Harold H. Kolb
 Wis. Reg. Surveyor S-167