


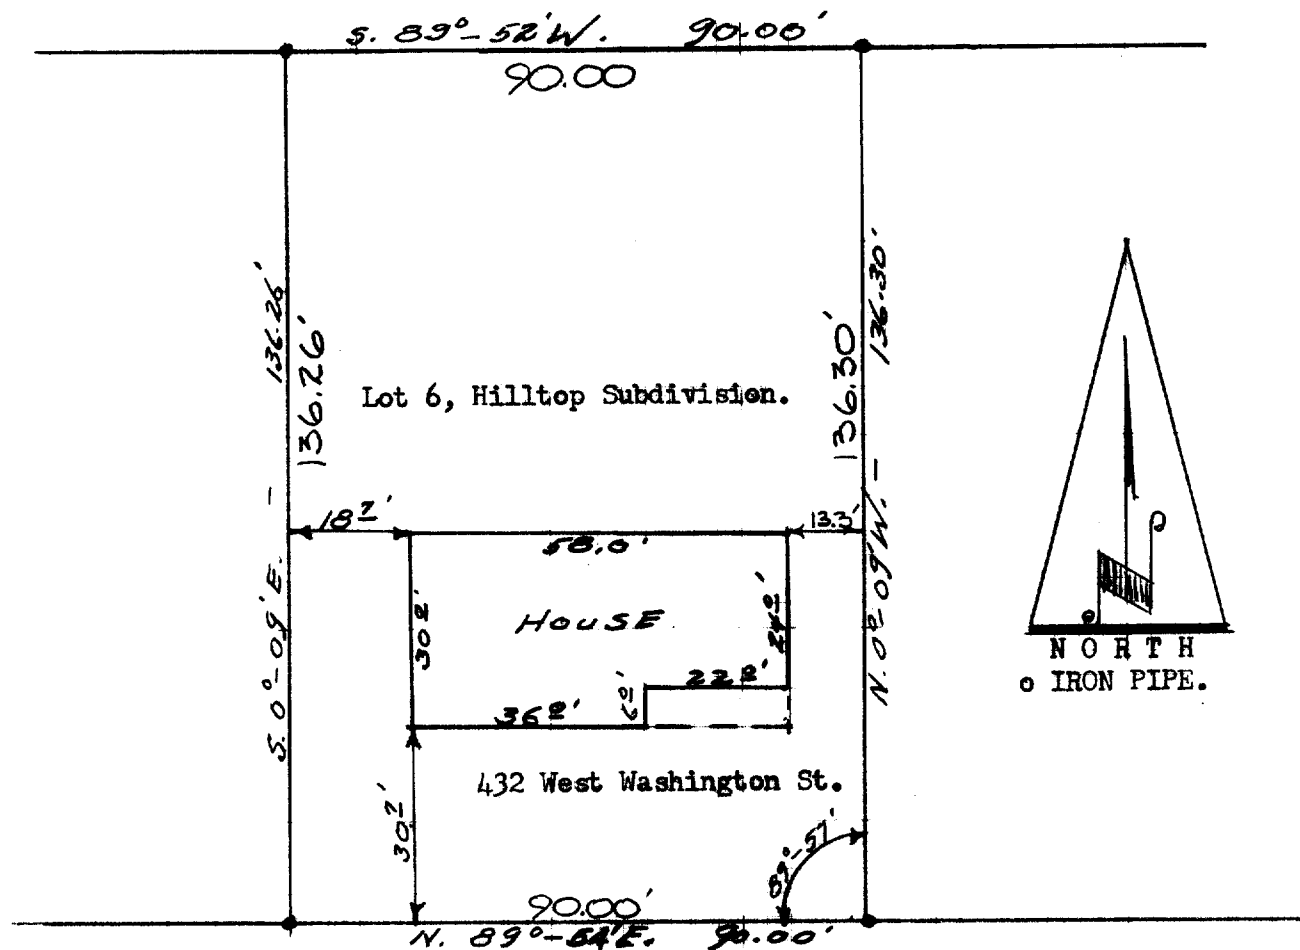

DESCRIPTION: Lot 6, Hilltop Subdivision in the City of Delavan Walworth County Wisconsin.

CERTIFICATE: I, hereby certify that I have surveyed the above mentioned property and that the hereon portrayed is an accurate survey and a true representation thereof and correctly shows the exterior boundary lines and the location of buildings and other improvements thereon.

Dated: November 4th 1965.

James F. Biagi, MS 272
Elkhorn, Wisconsin.

