


GEORGE T. DUNHAM
SURVEYING & SUBDIVIDING
DELAVER, WISCONSIN

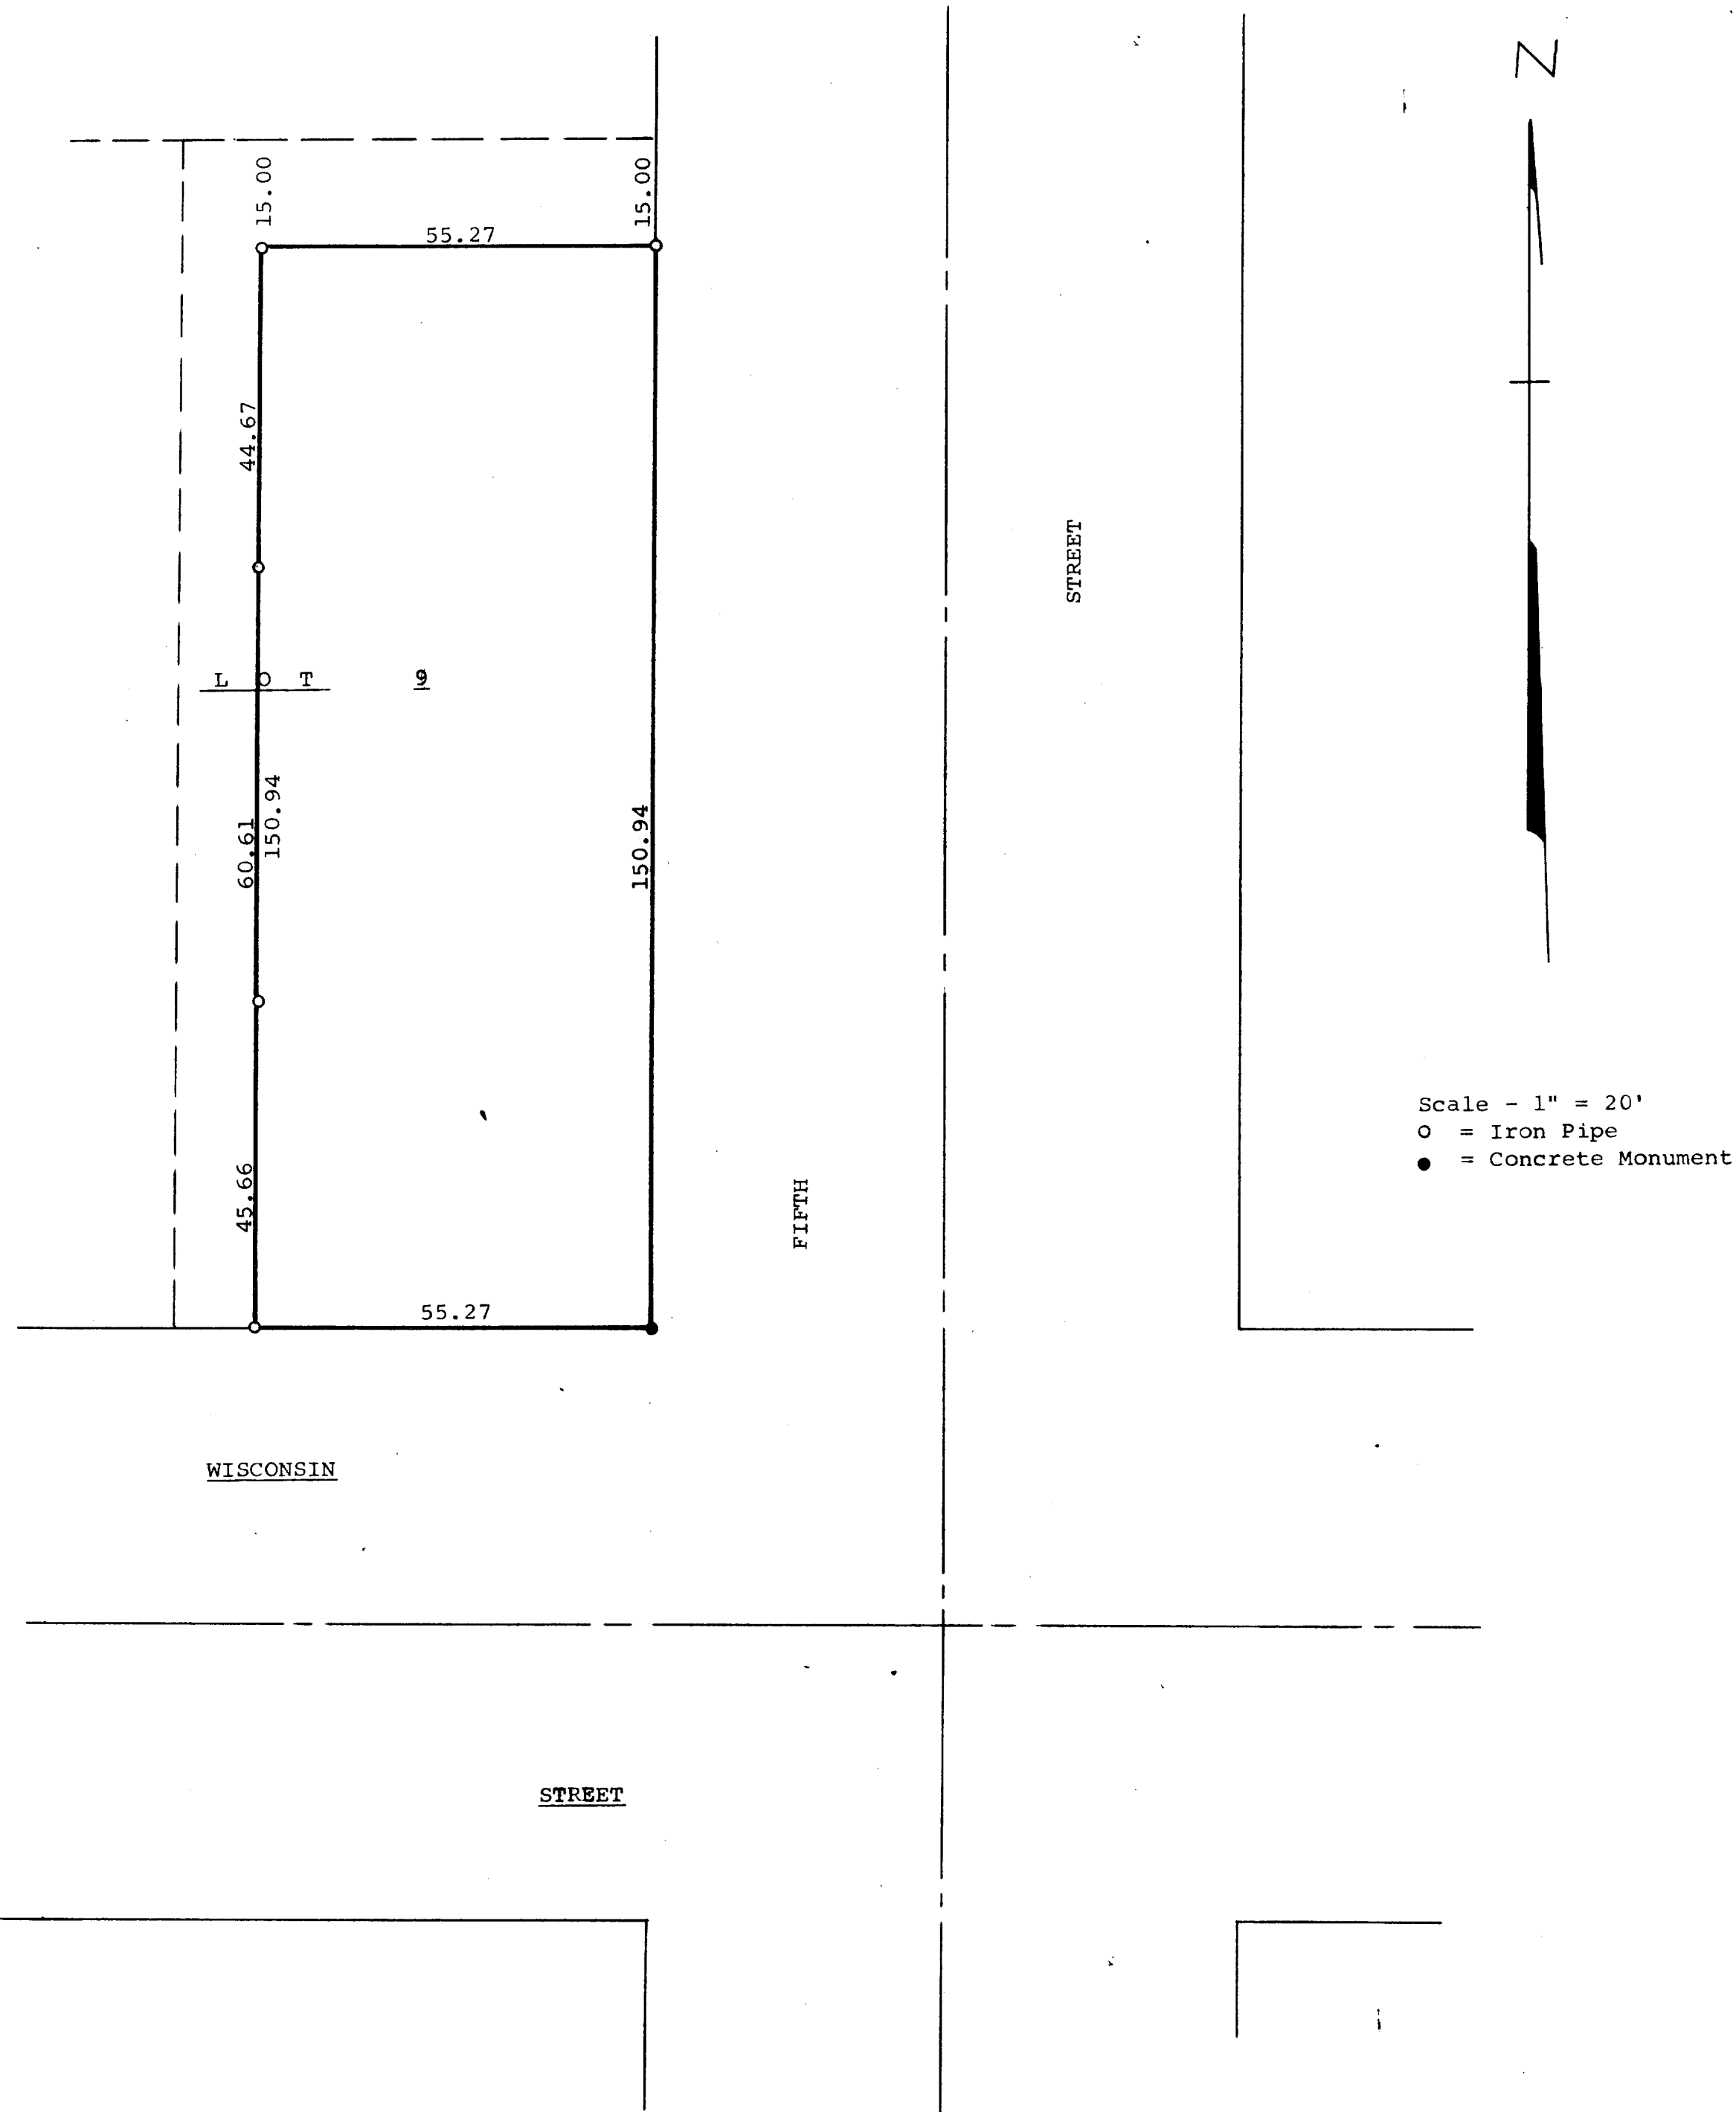

Plat of survey of part of Lot 9, Block 2 of Passage, Aram,
and Downie Addition to the City of Delavan, Walworth County,
Wisconsin,
October 14, 1970

George T. Dunham
George T. Dunham, Surveyor