

GEORGE T. DUNHAM
SURVEYING & SUBDIVIDING
DELAVAN, WISCONSIN

N

Scale - 1" = 20'
○ = Iron Pipe
X = Cross in Concrete



STATE OF WISCONSIN) SS
COUNTY OF WALWORTH)

I, George T. Dunham, Surveyor, certify that I have surveyed the property described as follows,

A strip of land of uniform width of 6 feet off the West side of Lot 1, and a strip of land of the uniform width of 23 feet off the East side of Lot 2, all in Block 4 of Larnard's Subdivision of Latimer's Addition to the City of Delavan, Walworth County, Wisconsin,

and that the above plat is an accurate survey and a true representation thereof and correctly shows the exterior boundary lines and location of buildings on said property and the correct measurements thereof.
November 16, 1971

George T. Dunham
George T. Dunham, Surveyor

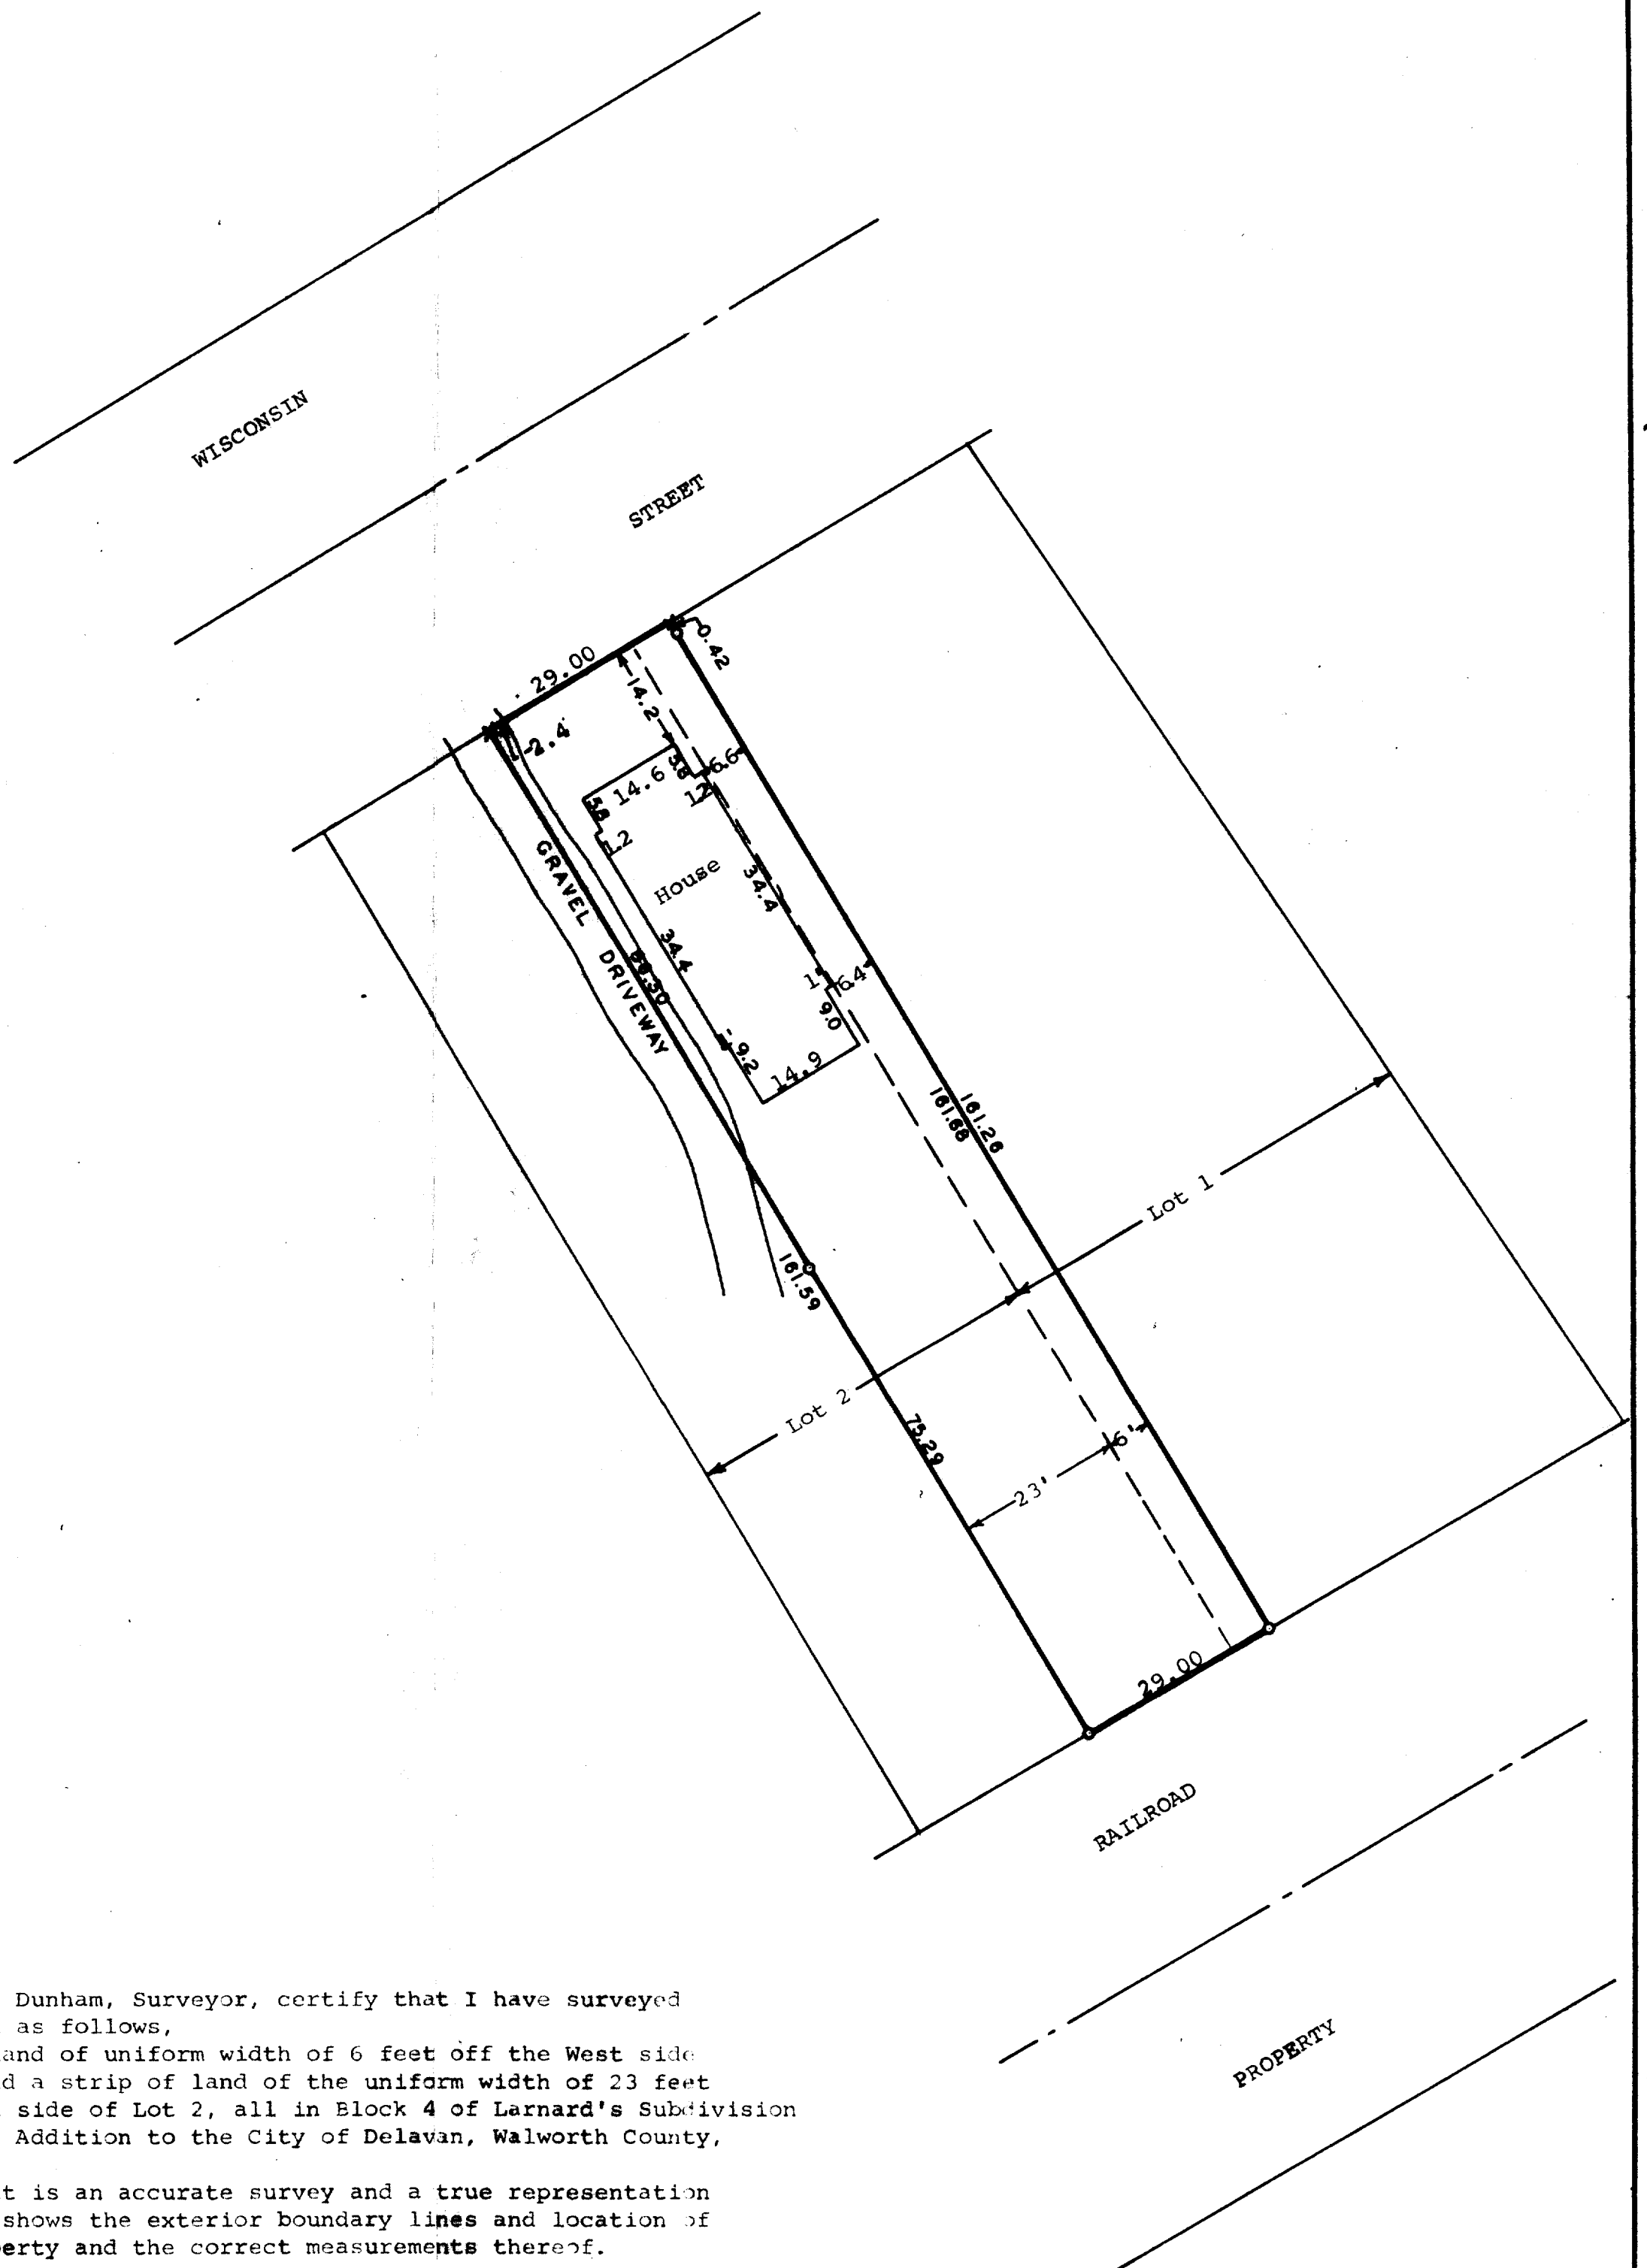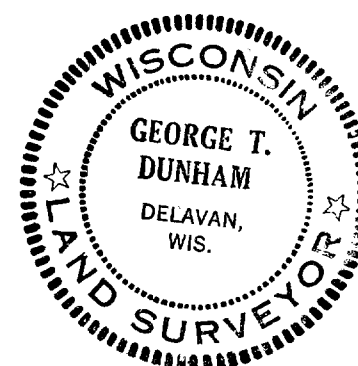

2-451 ✓