


GEORGE T. DUNHAM
SURVEYING & SUBDIVIDING
DELAVAN, WISCONSIN



Scale - 1" = 20'
○ = Iron Pipe
● = Concrete Monument

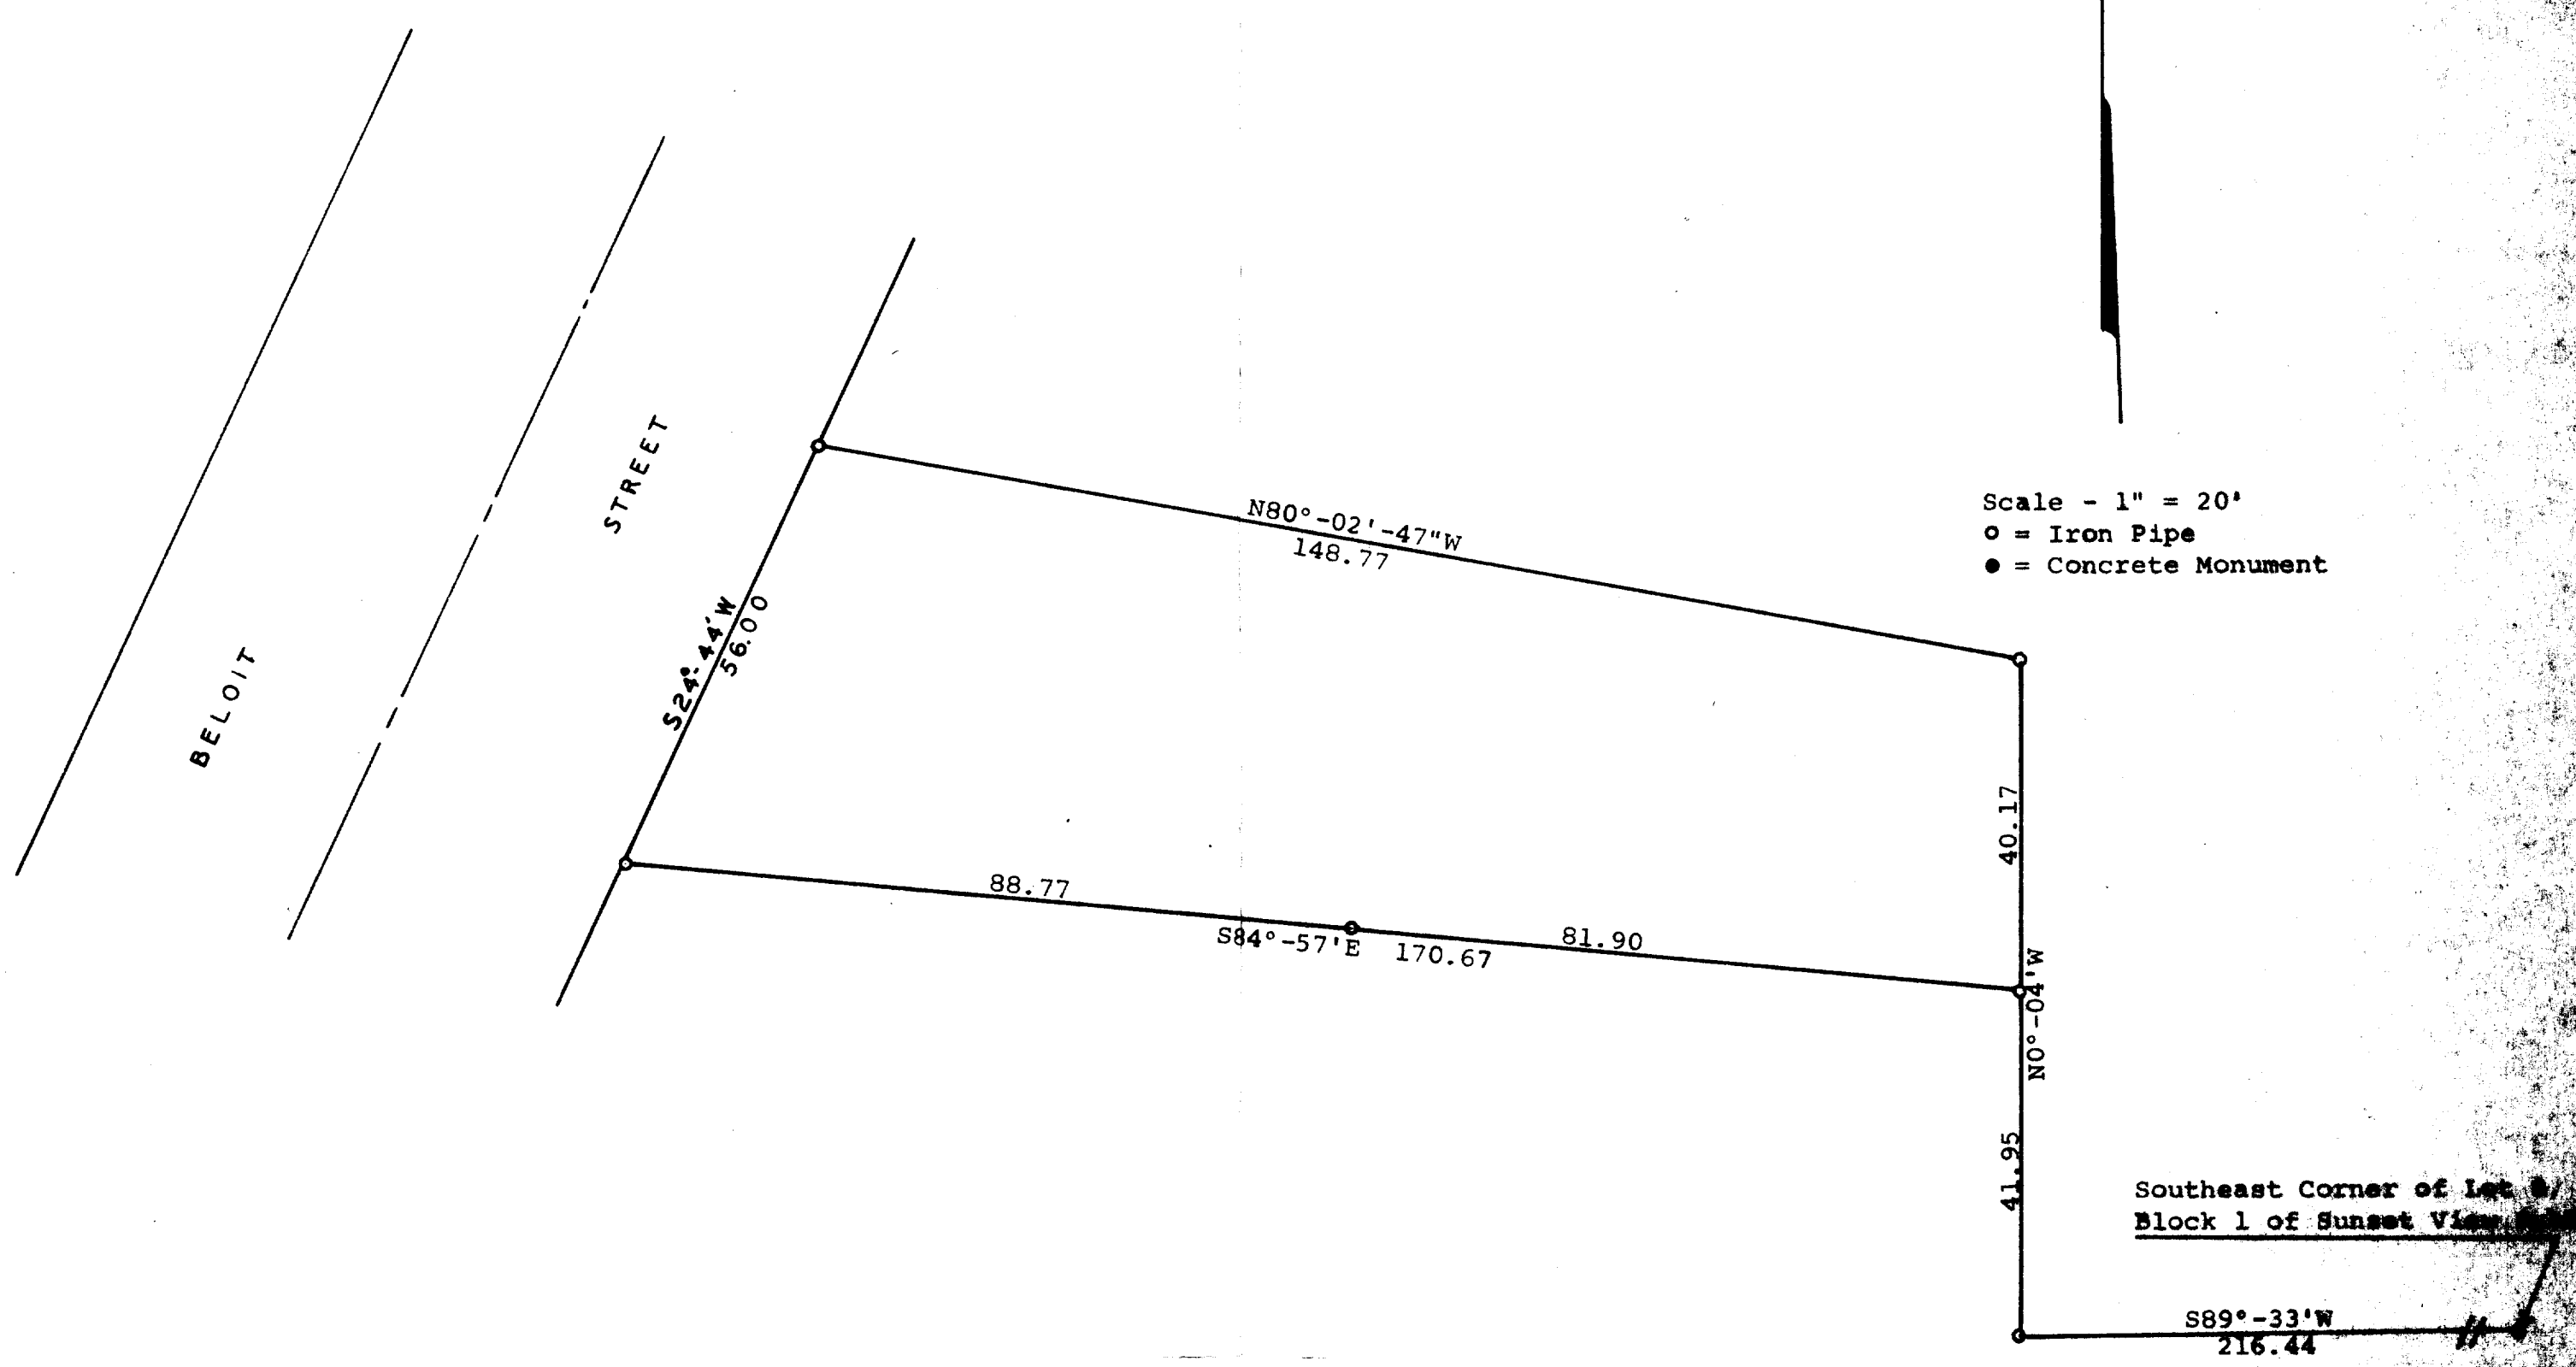

Plat of survey of a parcel of land located in
the Southwest $\frac{1}{4}$ of Section 18, T 2 N, R 16 E,
City of Delavan, Walworth County, Wisconsin.
September 14, 1971

George T. Dunham
George T. Dunham, Surveyor

