


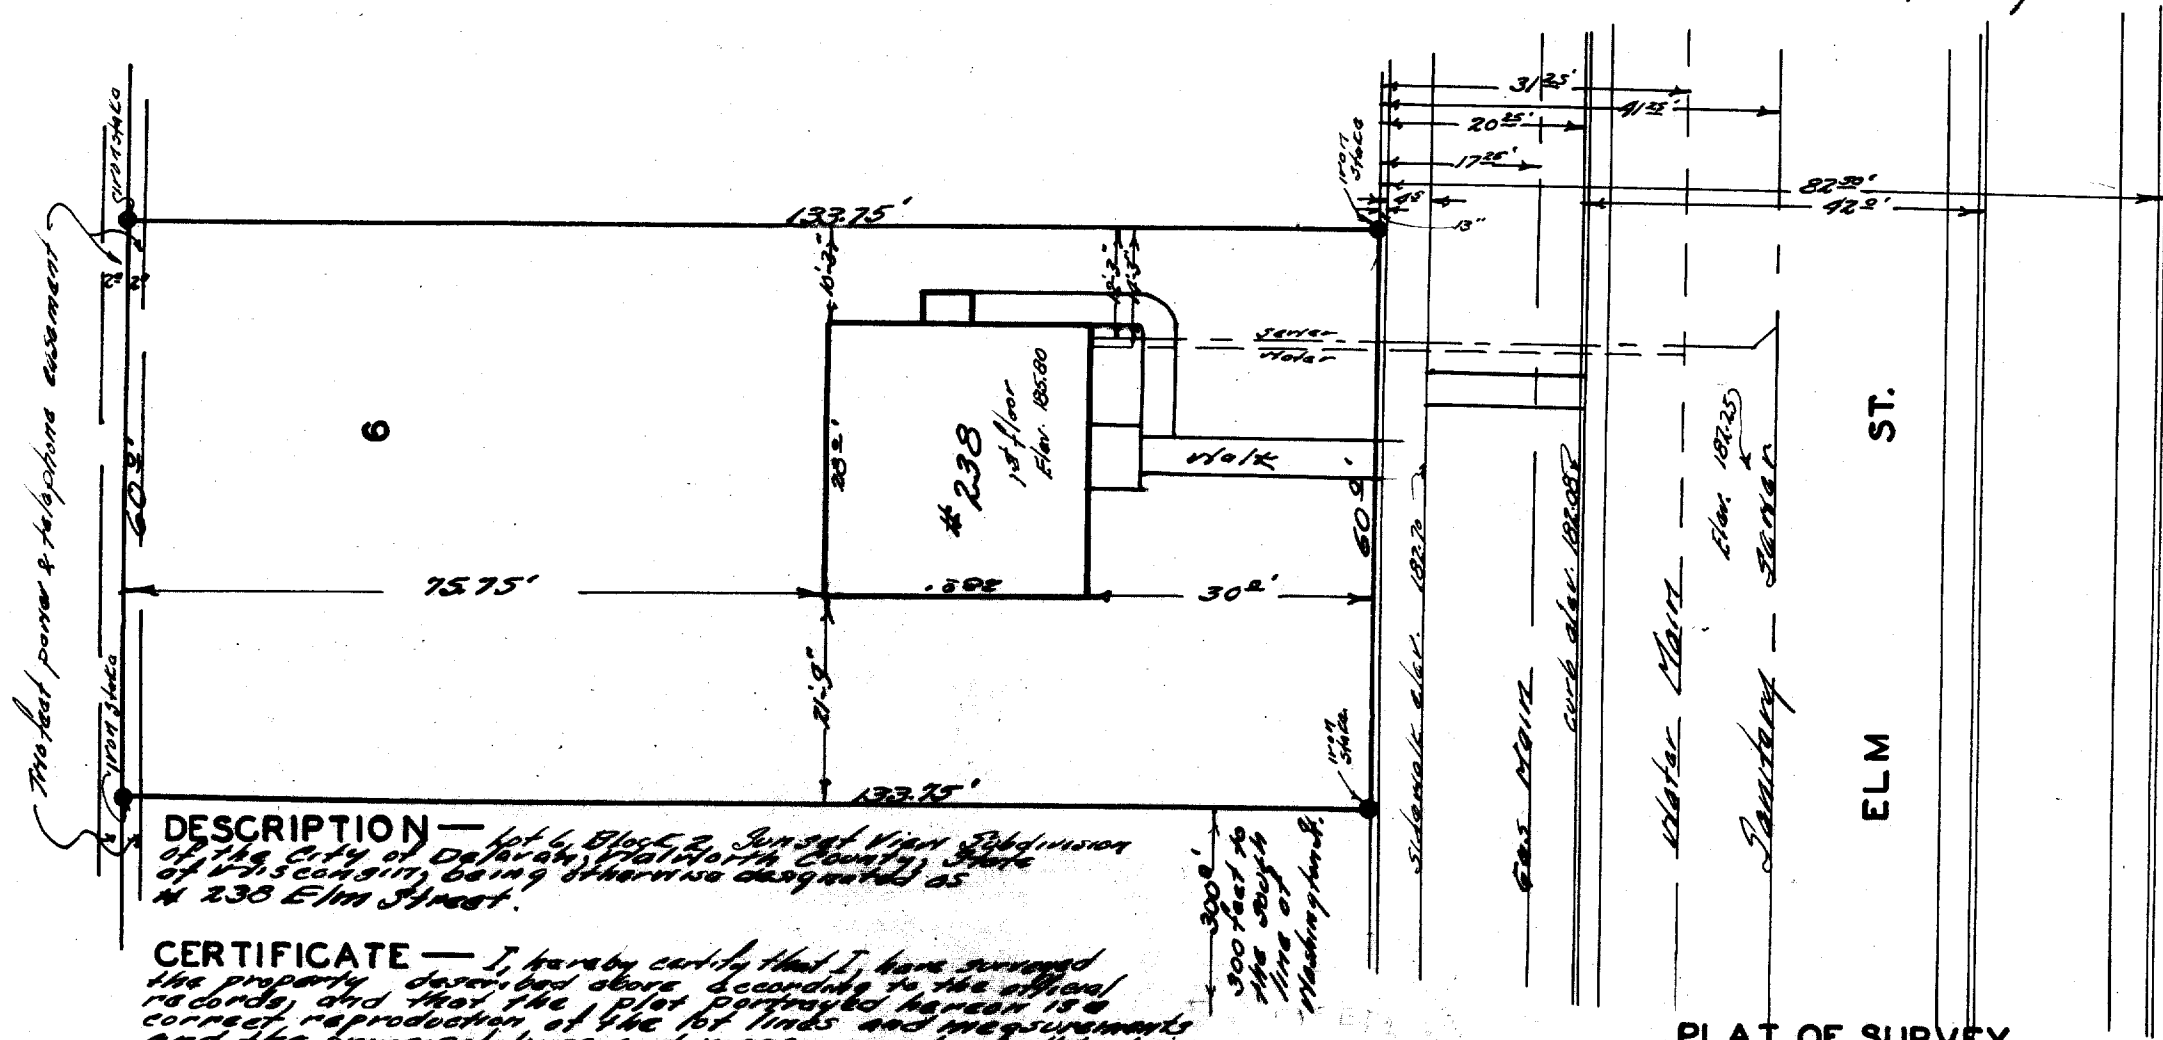

DESCRIPTION — Lot 6, Block 2, Sunset View Subdivision of the City of Delmar, Delaware, containing 1/4 acre of land, being otherwise designated as N 238 Elm Street.

CERTIFICATE — I hereby certify that I have surveyed the property described above according to the official records, and that the plot portrayed hereon is a correct reproduction of the lot lines and measurements and the principal lines and measurements of all buildings and other structures.

Signed this 28th day of May 1943

Joseph M. Biggi
Elkhorn Wis.

PLAT OF SURVEY
OF
LOT 6 BLOCK 2
SUNSET VIEW SUBDIVISION
DELAWARE WIS.

2-47B