


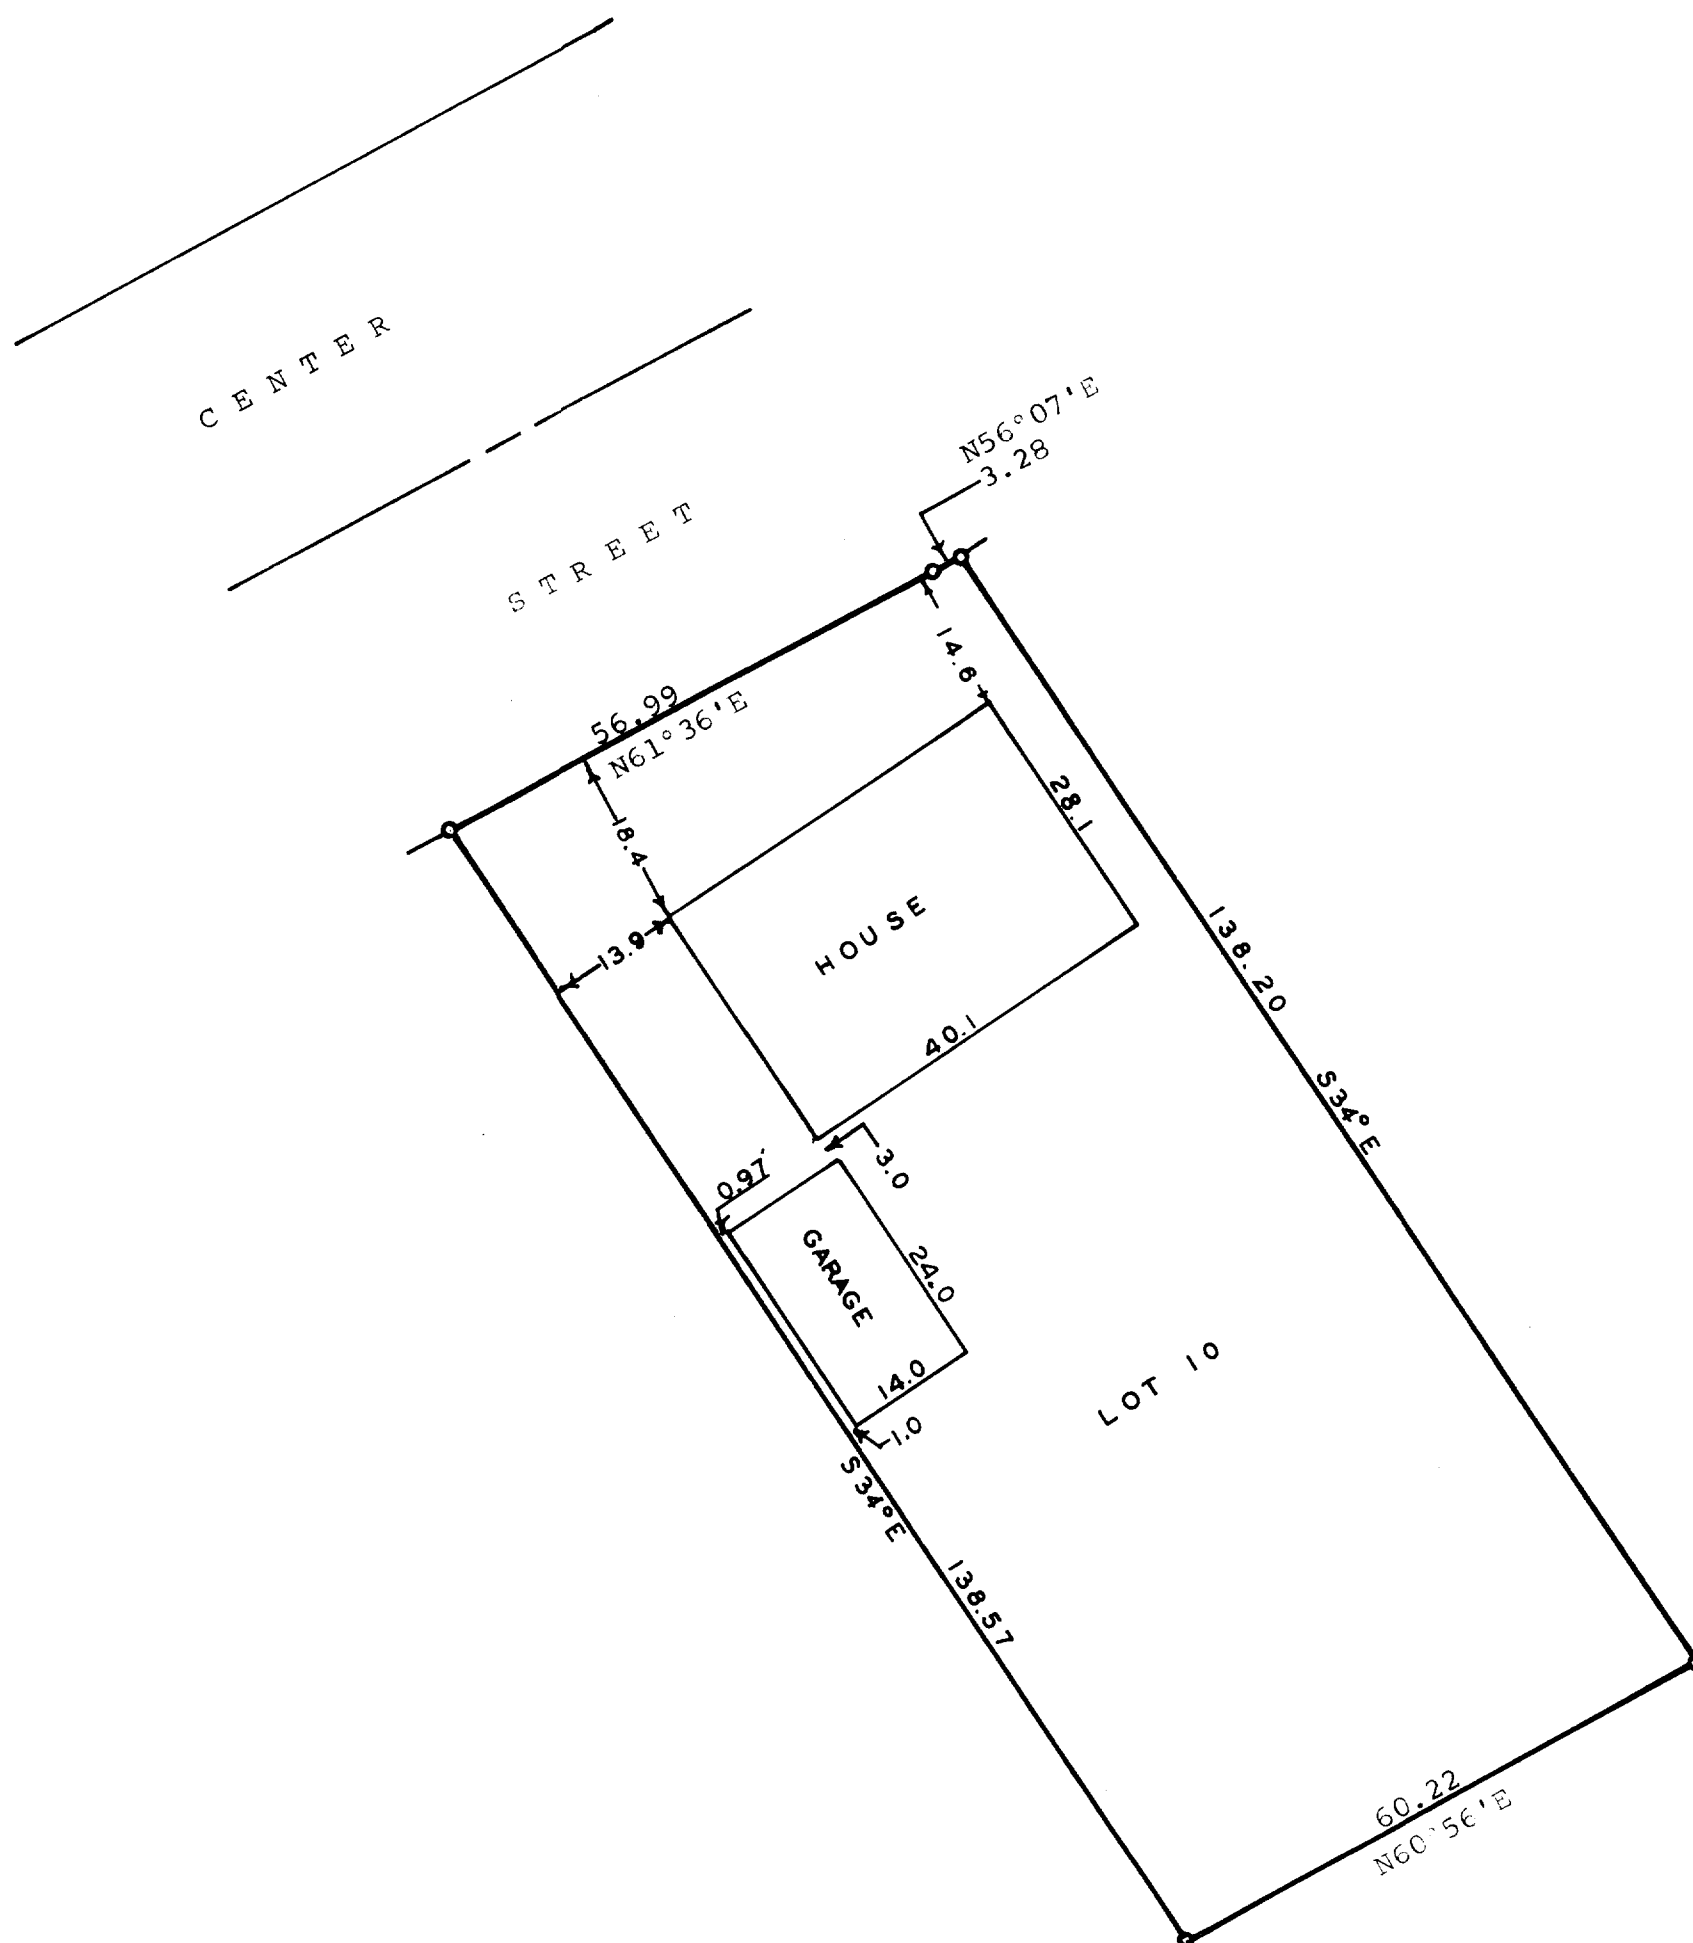

Scale - 1" = 20'
● = Iron Pipe



STATE OF WISCONSIN)
COUNTY OF WALWORTH) SS

I, George T. Dunham, Surveyor, certify that I have surveyed the property described as follows,
Lot 10 of Center Court Subdivision, a subdivision located in Section 17, T 2 N, R 16 E, Walworth County Wisconsin

and that the above plat is an accurate survey and a true representation thereof and correctly shows the exterior boundary lines and the location of the house on said property and the correct measurements thereof.

July 20, 1973

George T. Dunham
George T. Dunham, Surveyor

