


GEORGE T. DUNHAM  
SURVEYING & SUBDIVIDING  
DELAVAN, WISCONSIN

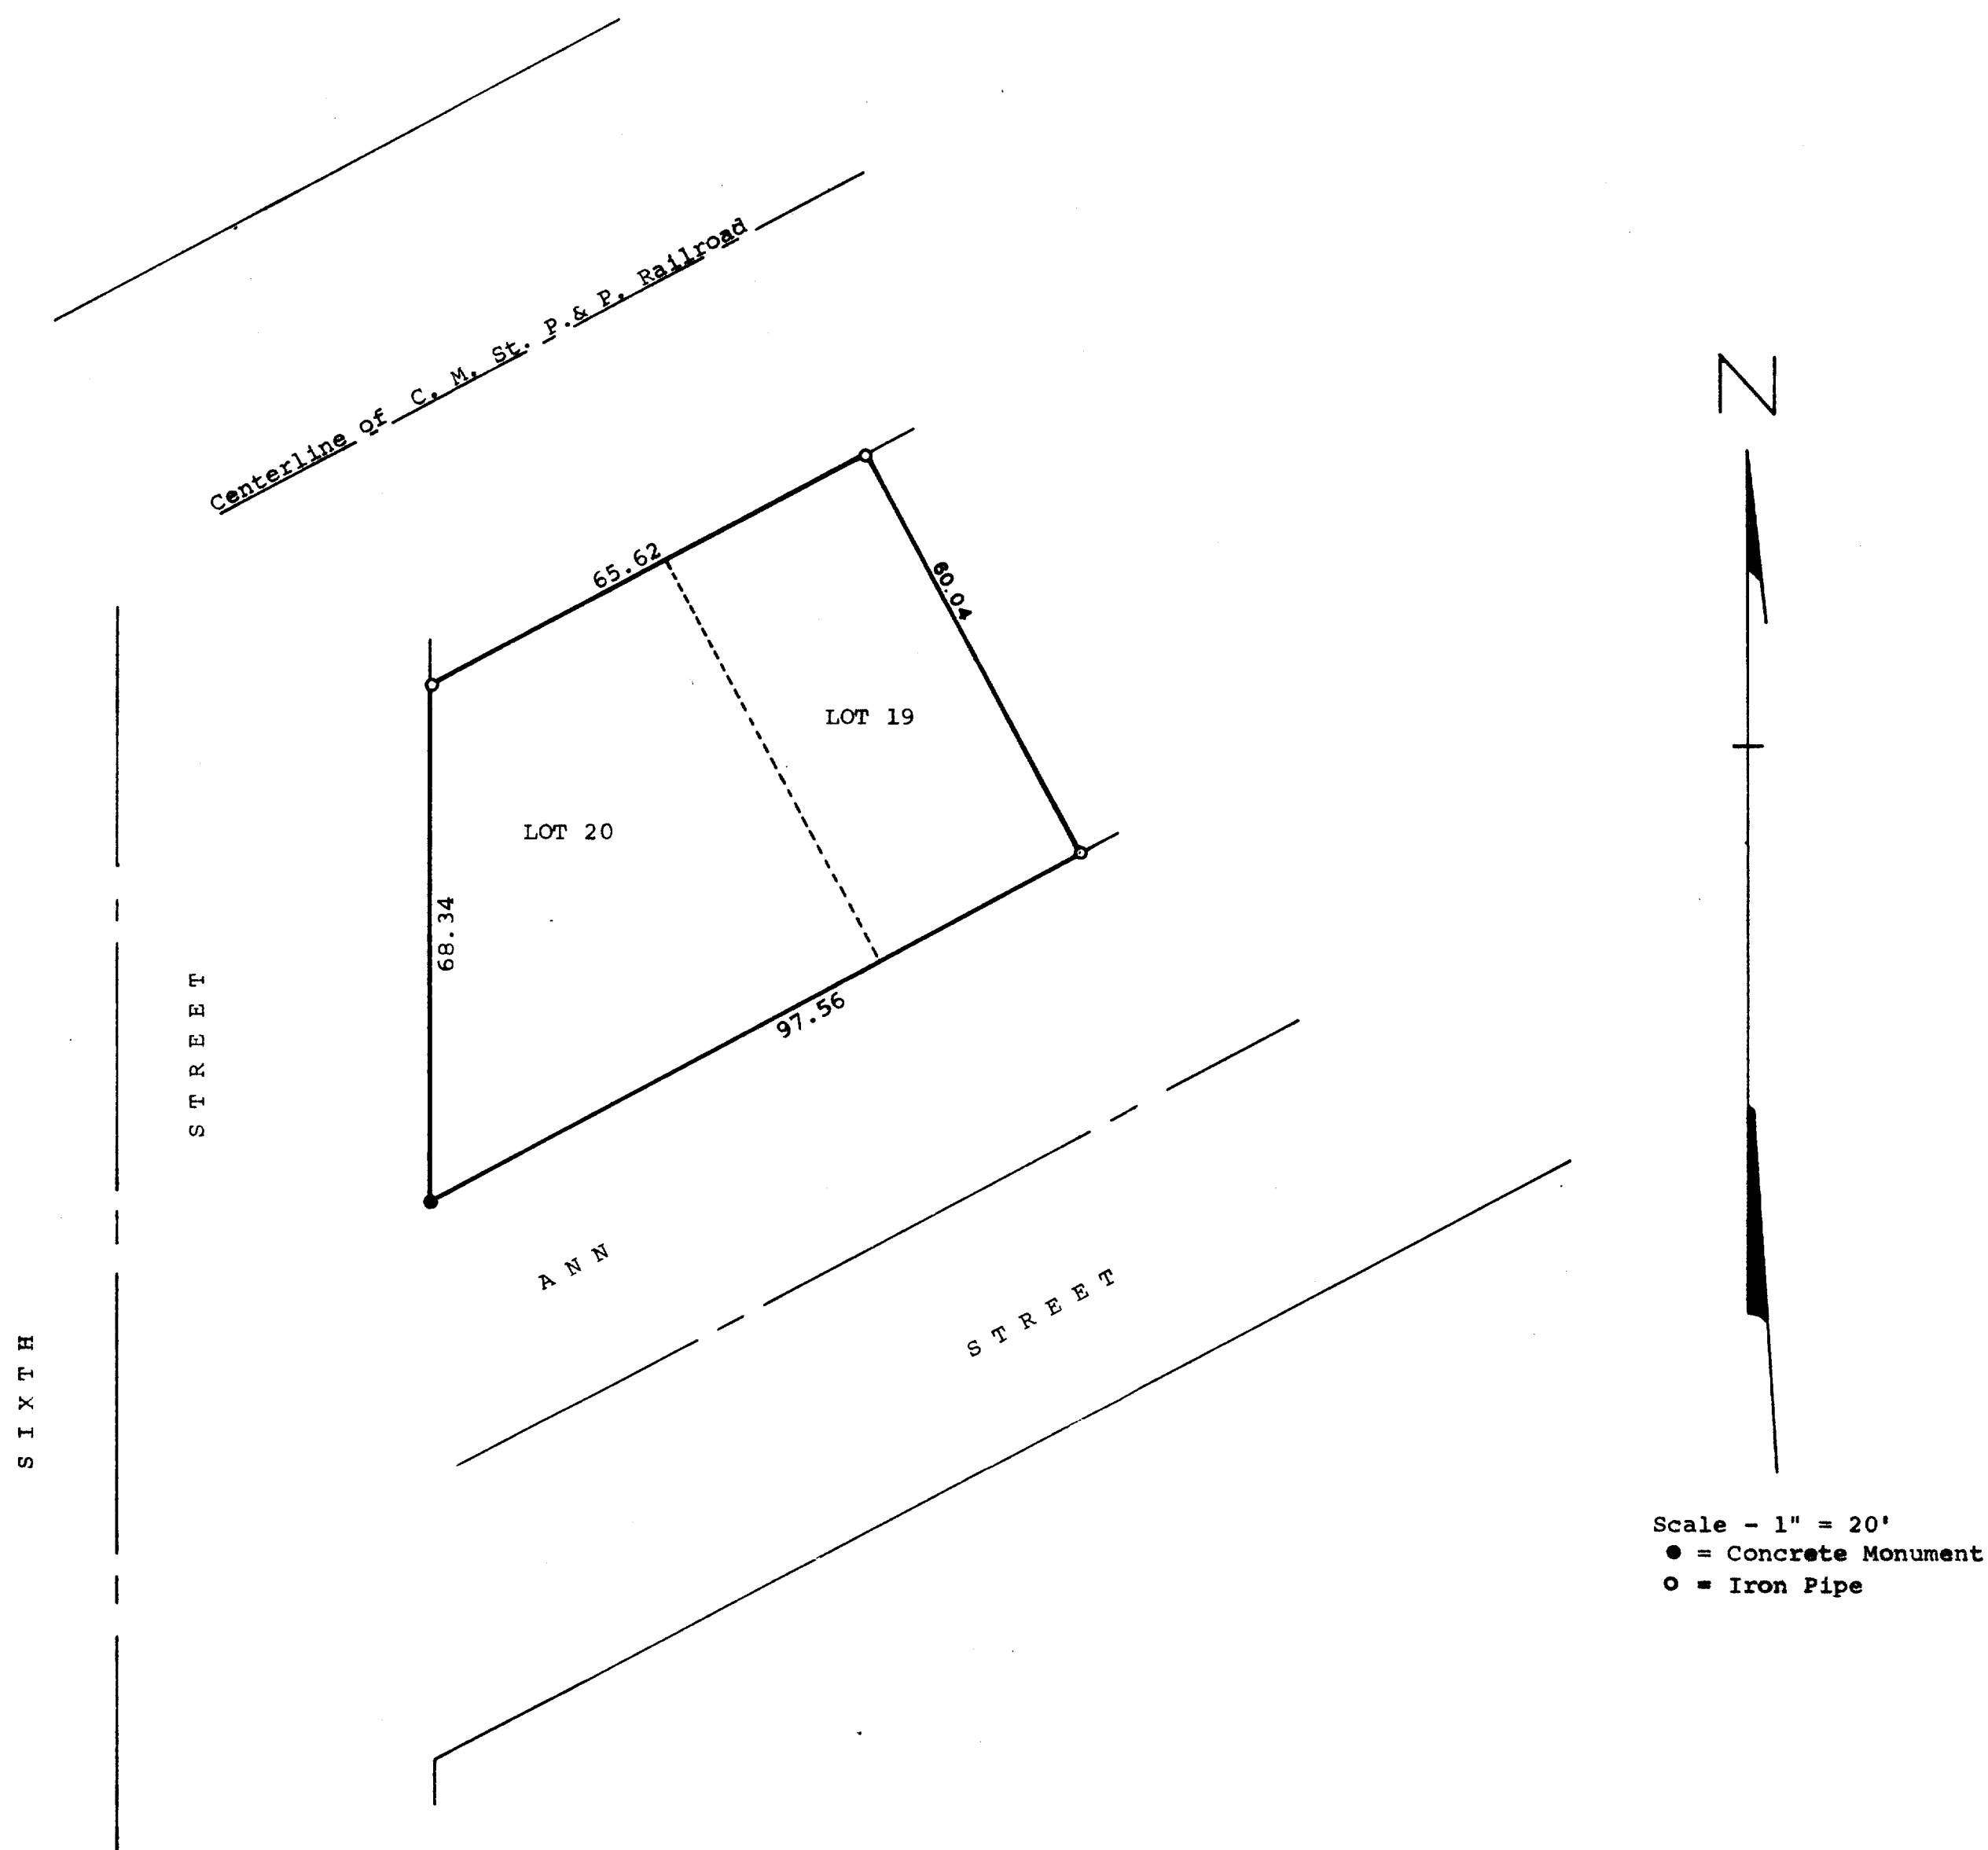

Plat of survey of Lots 19 and 20 in Block 10 of  
Passage, Aram & Downie Addition to the City of  
Delavan, Walworth County, Wisconsin.  
April 9, 1974

*George T. Dunham*  
George T. Dunham, Surveyor

