


N

SCALE - 1" = 20'

○ = IRON PIPE

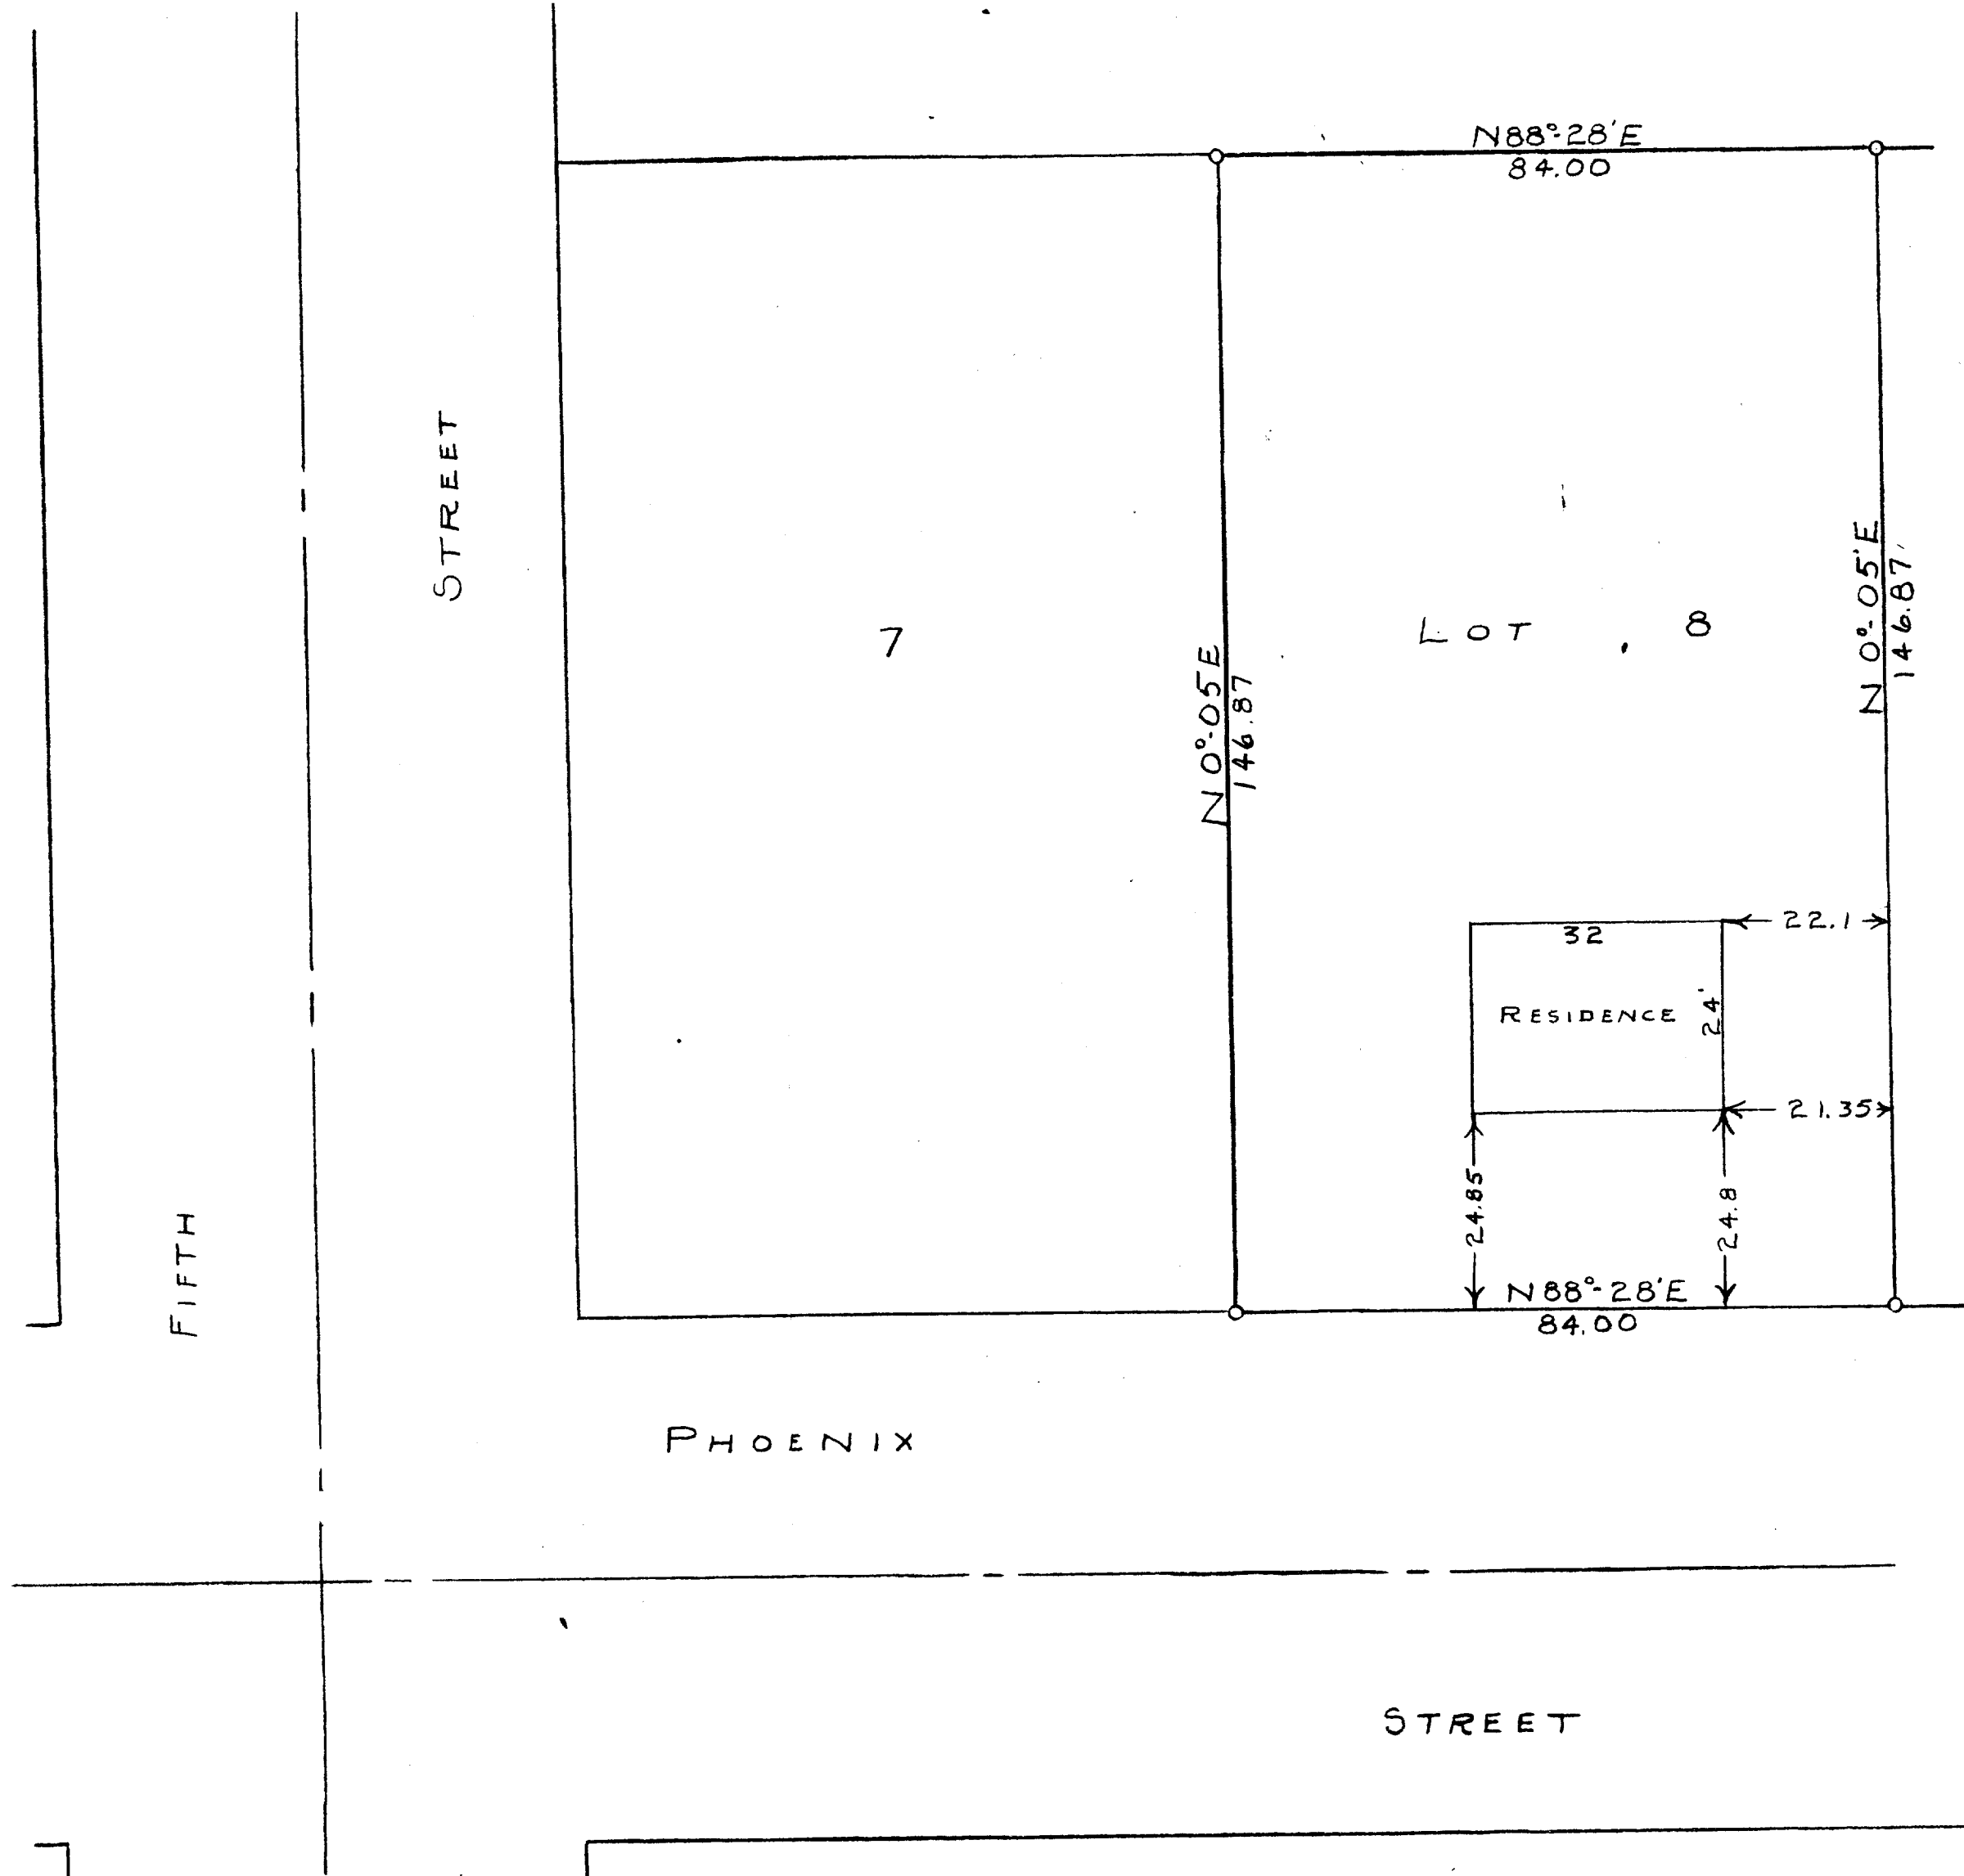

STATE OF WISCONSIN
COUNTY OF WALWORTH

I, GEORGE T. DUNHAM, DO HEREBY CERTIFY THAT I HAVE SURVEYED THE
PROPERTY DESCRIBED AS FOLLOWS:

LOT 8 OF KNAPP'S SUBDIVISION LOCATED IN THE CITY OF DELAVAN
WALWORTH COUNTY, WISCONSIN

AND THAT THE PLAT SHOWN ABOVE IS A CORRECT REPRESENTATION OF THE
PROPERTY LINES.

JAN. 3, 1956

George T. Dunham
GEORGE T. DUNHAM, SURVEYOR
DELAVAN, WISCONSIN

2-5 ✓

XK-8