


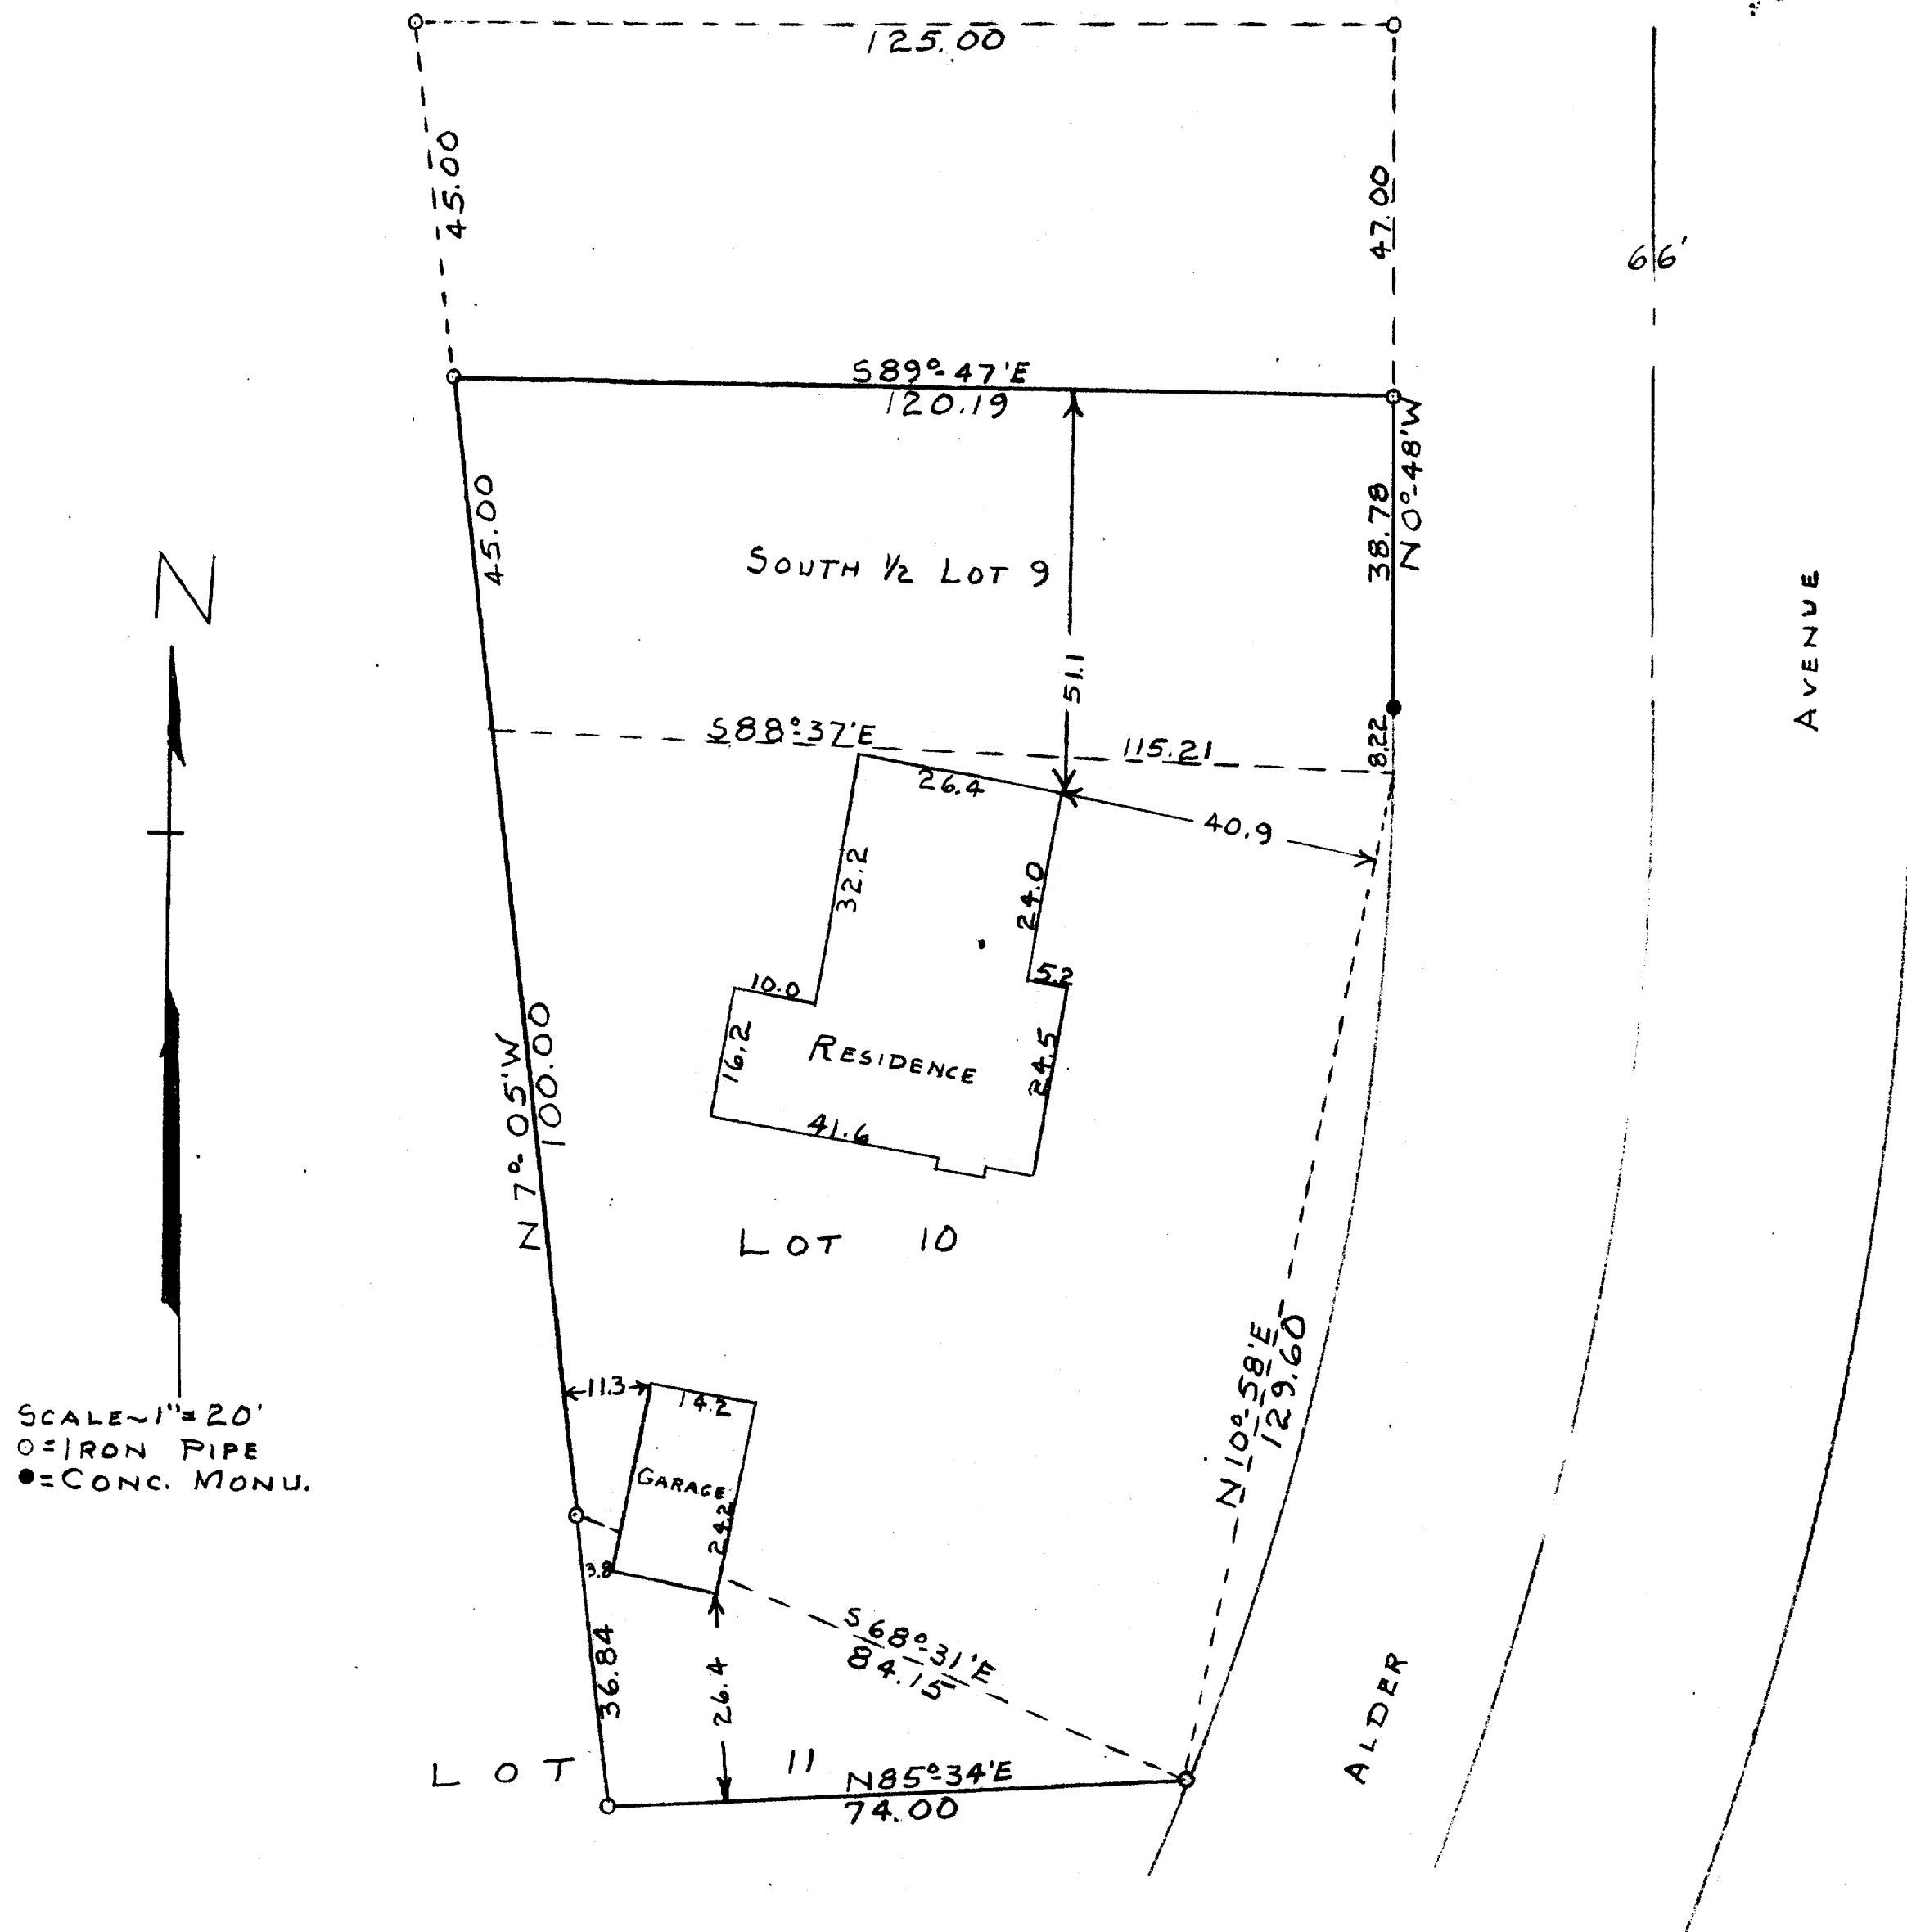

STATE OF WISCONSIN)
COUNTY OF WALWORTH)

I, GEORGE T. DUNHAM, DO HEREBY CERTIFY THAT I HAVE SURVEYED THE
PROPERTY DESCRIBED AS FOLLOWS:

THE SOUTH 1/2 OF LOT 9; LOT 10; AND THAT PART OF LOT 11 DESCRIBED
AS BEGINNING AT THE MOST EASTERLY CORNER OF SAID LOT 11; THENCE
N 68° 31' W 84.15 FEET TO THE MOST NORTHERLY CORNER OF SAID LOT 11;
THENCE S 7° 05' E 36.84 FEET; THENCE N 85° 34' E 74.00 FEET TO THE PLACE
OF BEGINNING; ALL IN BLOCK 3, ALLYNHURST SUBDIVISION, CITY OF
DELAHAN, WALWORTH COUNTY, WISCONSIN

AND THAT THE ABOVE PLAT IS A CORRECT REPRESENTATION OF THE PROPERTY
LINES
MAY 11, 1956

George T. Dunham
GEORGE T. DUNHAM, SURVEYOR
DELAHAN, WISCONSIN