


PLAT OF SURVEY

OF

LOT 77 TURTLE CREEK SUBDIVISION
LOCATED IN SW 1/4 OF SE 1/4, SECTION 13,
TOWNSHIP 2 N, RANGE 15 E, WALNORTH
COUNTY, WISCONSIN

(Handwritten note: 1/4 Section 13, T2N, R15E, S13)

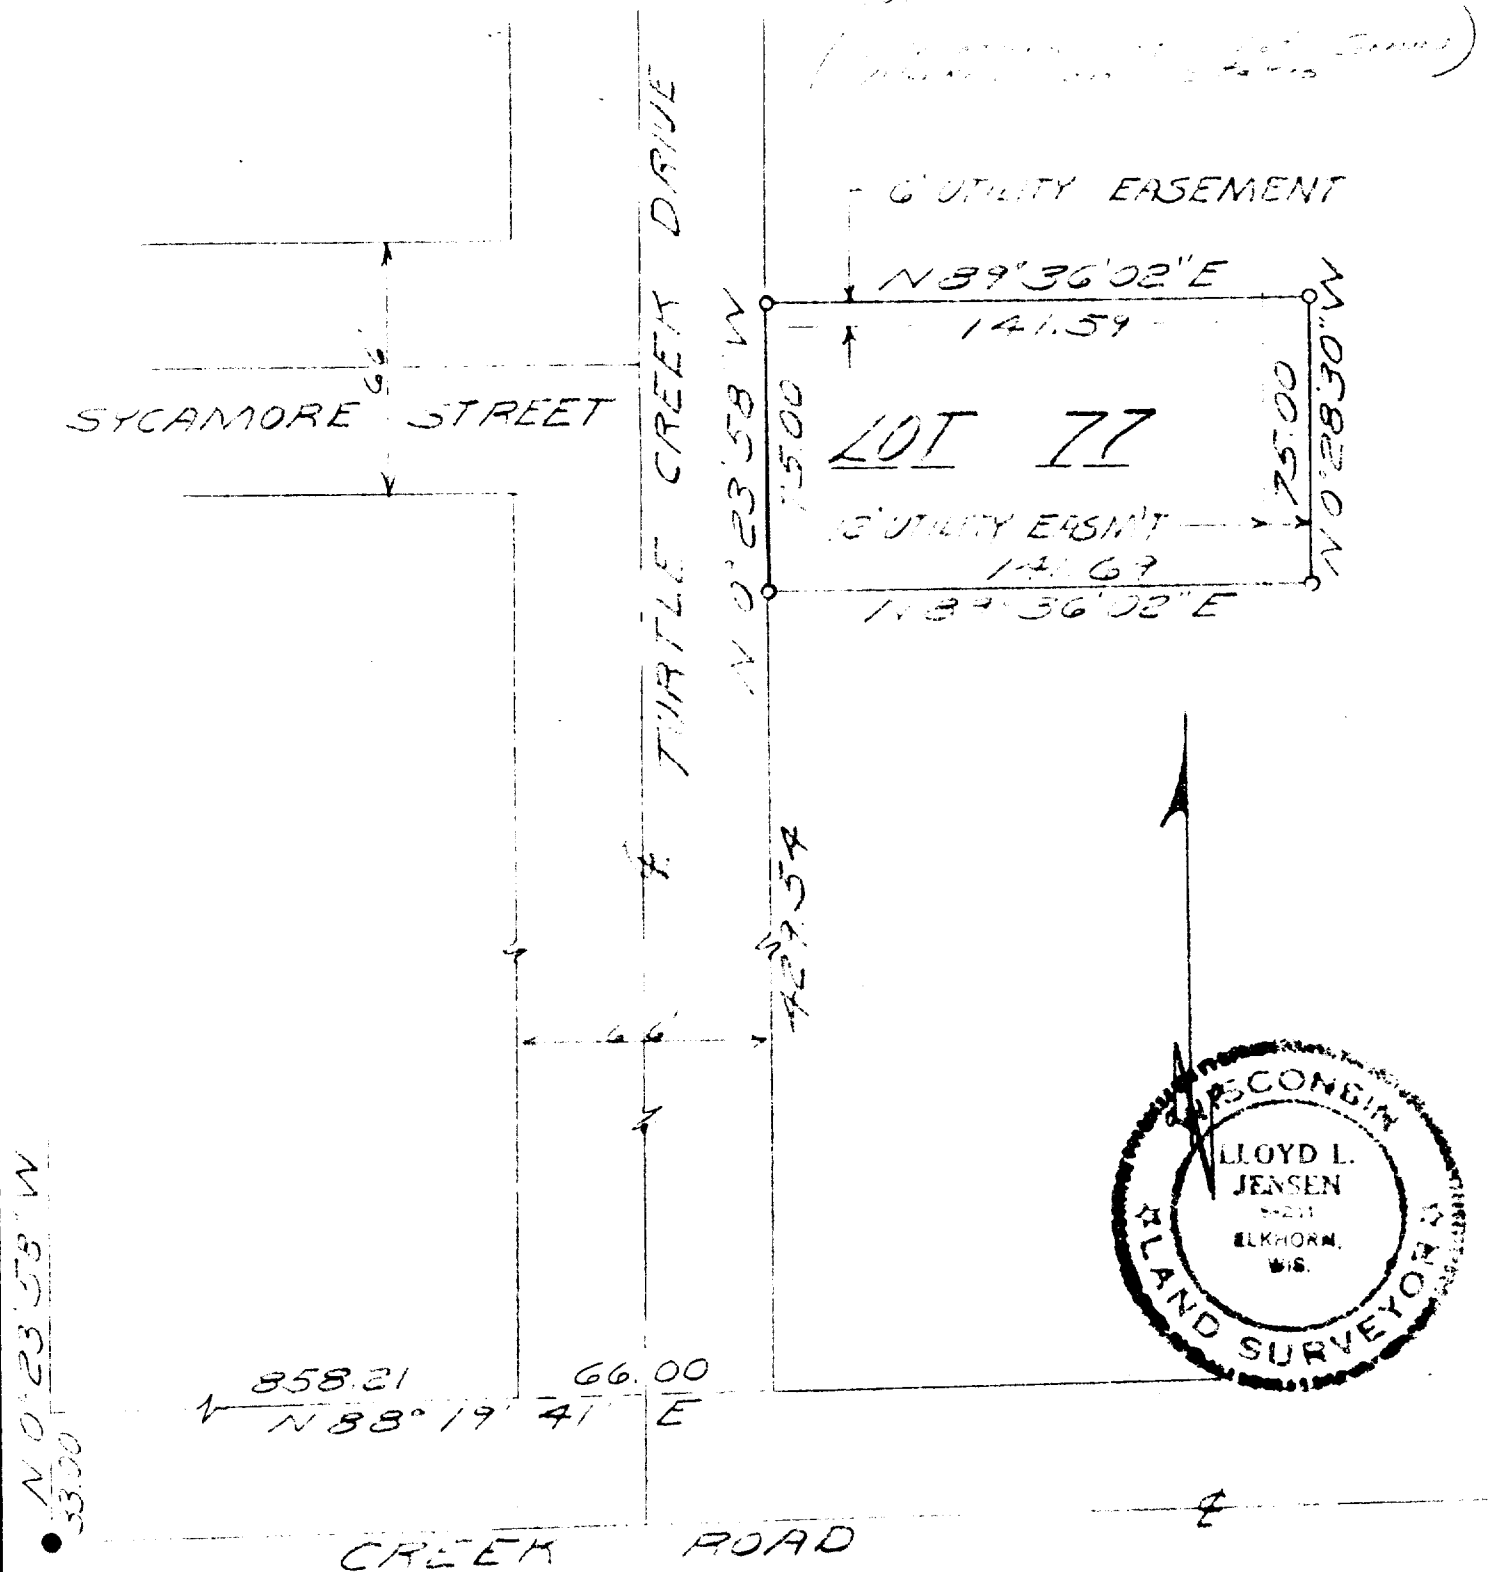

SURVEY AND PLAT BY

SOUTH 1/4 CORNER
SECTION 13, T. 2N, R. 15E. **JENSEN & JOHNSON, INC.**
CIVIL ENGINEERS AND SURVEYORS

Elkhorn, Wisconsin

LEGEND

- — Iron Pipe Set 1' O.D.
- — Concrete Monument
- Scale 1" = 50'

WE CERTIFY: That we have surveyed the above described property and that the plat shown hereon is an accurate survey and a true representation thereof and correctly shows the exterior boundary lines and all divisions of said property.

Date May 1975

(Signature of Lloyd L. Jensen)
LLOYD L. JENSEN,

Wisconsin Registered Land Surveyor, No. S-211