


GEORGE T. DUNHAM
SURVEYING & SUBDIVIDING
DEHAVAN, WISCONSIN

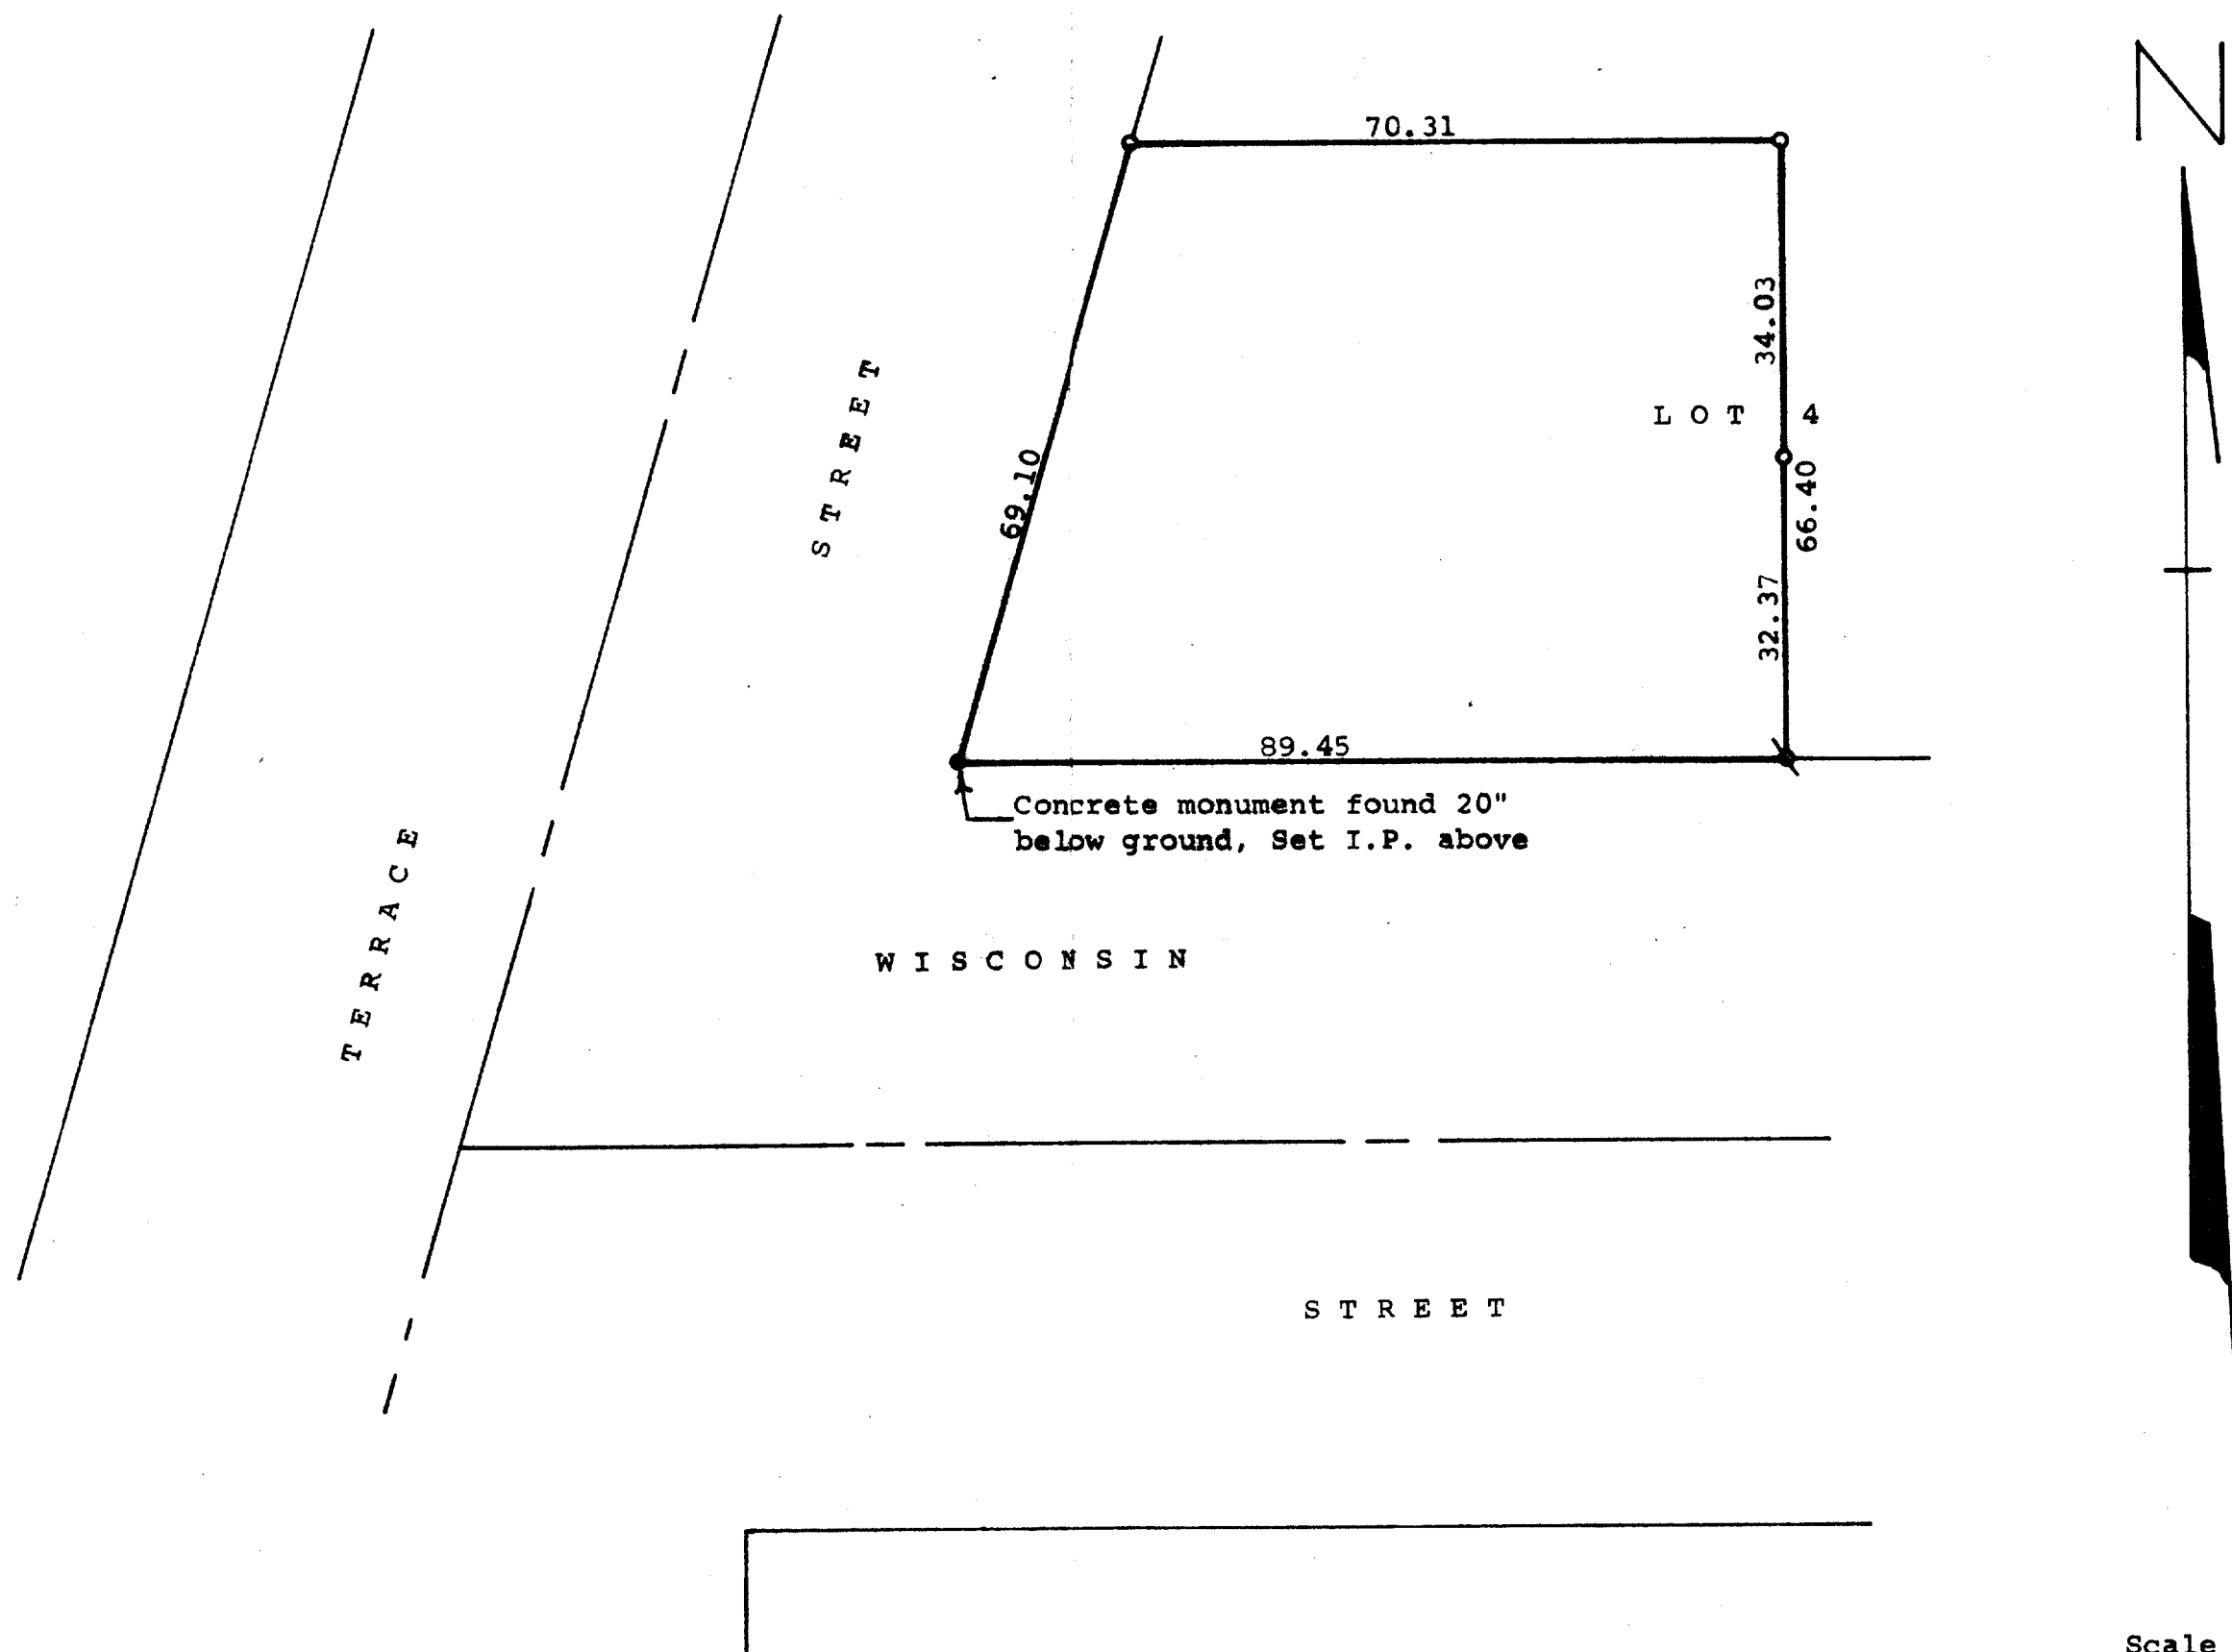

Scale - 1" = 20'
 X = Iron Pipe Found
 o = Iron Pipe Set
 ● = Concrete Monument

Plat of survey of part of Lot 4, Block 16 of the City of Delavan, Walworth County, Wisconsin, described as follows: Beginning at a concrete monument at the southwest corner of Lot 4, Block 16 of the City of Delavan; thence N16°04'E along the west line of Lot 4, Block 16, 69.10 feet; thence East parallel with the south line of said Lot 4, 70.31 feet; thence South parallel with the east line of said Lot 4, 66.40 feet; thence West along the south line of said Lot 4, 89.45 feet to the place of beginning.
 April 29, 1975

George T. Dunham
 George T. Dunham, Surveyor

