



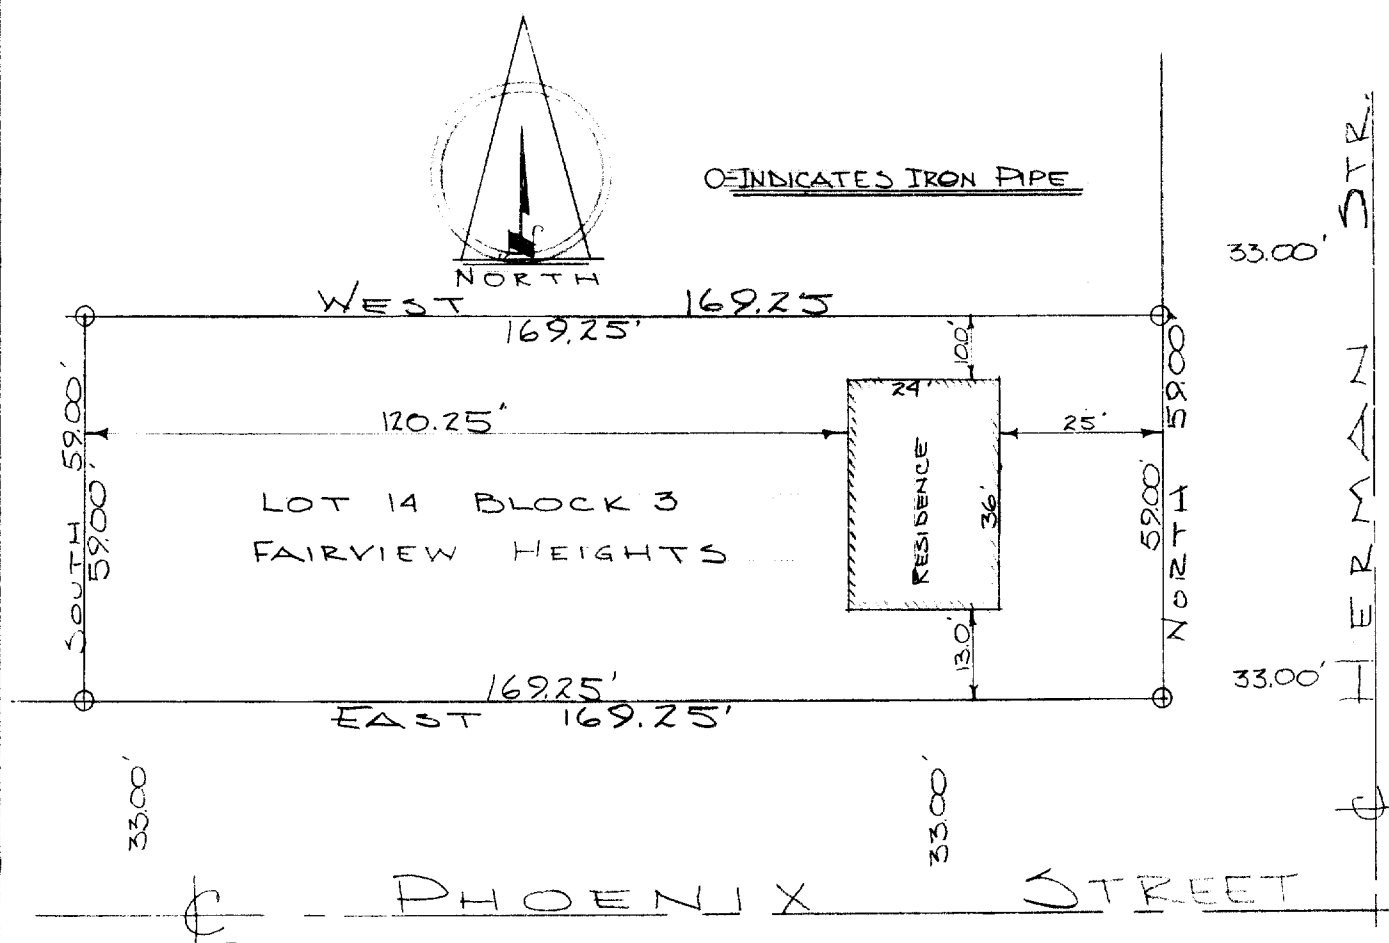

DESCRIPTION: Lot 14 of Block 3 in Fairview Heights Subdivision
located in the City of Delavan, Walworth County, Wisconsin.

CERTIFICATE: I, James F. Biagi, surveyor do hereby certify that I
have surveyed the property hereon described, and that
the location of the improvements are as shown.

September 17, 1963.

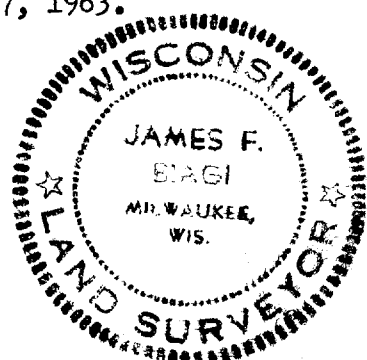

James F. Biagi
James F. Biagi RLS 272