


GEORGE T. DUNHAM
SURVEYING & SUBDIVIDING
DELAVER, WISCONSIN

ELM

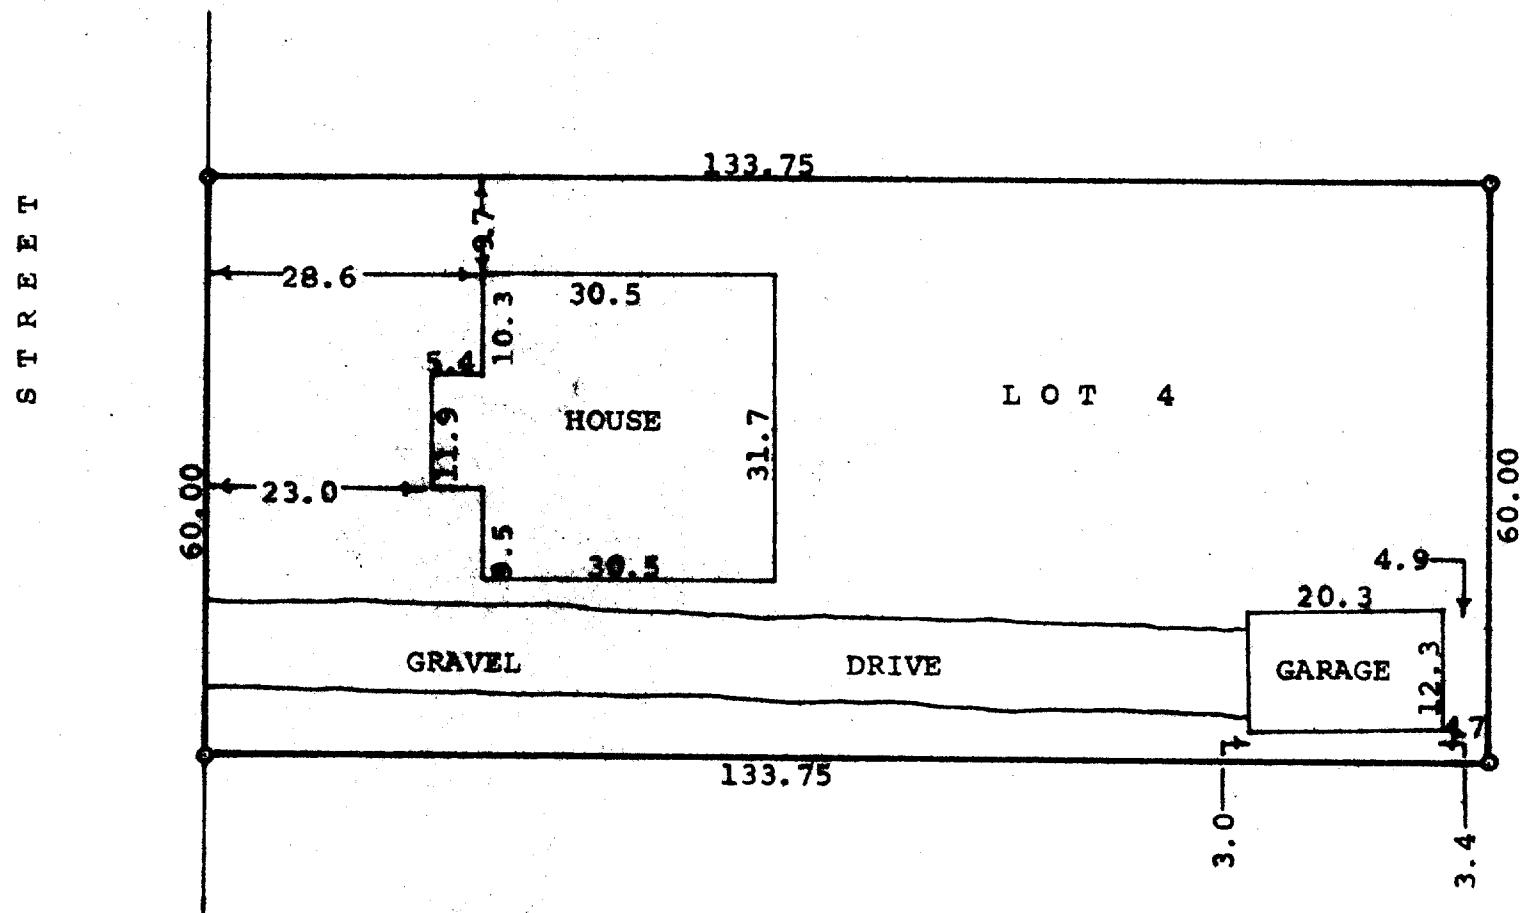

Scale - 1" = 20'
o = Iron Pipe Found

STATE OF WISCONSIN)
COUNTY OF WAUKESHA) ss

I, George T. Dunham, Surveyor, certify that I have surveyed the property described as follows:

Lot 4, Block 2 of Sunset View Subdivision located in the City of Delavan, Walworth County, Wisconsin, and the above map is a true representation thereof and shows the size and location of the property, its exterior boundaries, the location and dimensions of all structures thereon, fences, apparent easements and roadways and visible encroachments, if any. This survey is made for the exclusive use of the present owners of the property, and also those who purchase, mortgage, or guarantee the title thereto within one (1) year from date hereof; and as to them I warrant the accuracy of said survey and map.

August 25, 1975

George T. Dunham
George T. Dunham, Surveyor

