


4-67

SOUTH SIXTH STREET

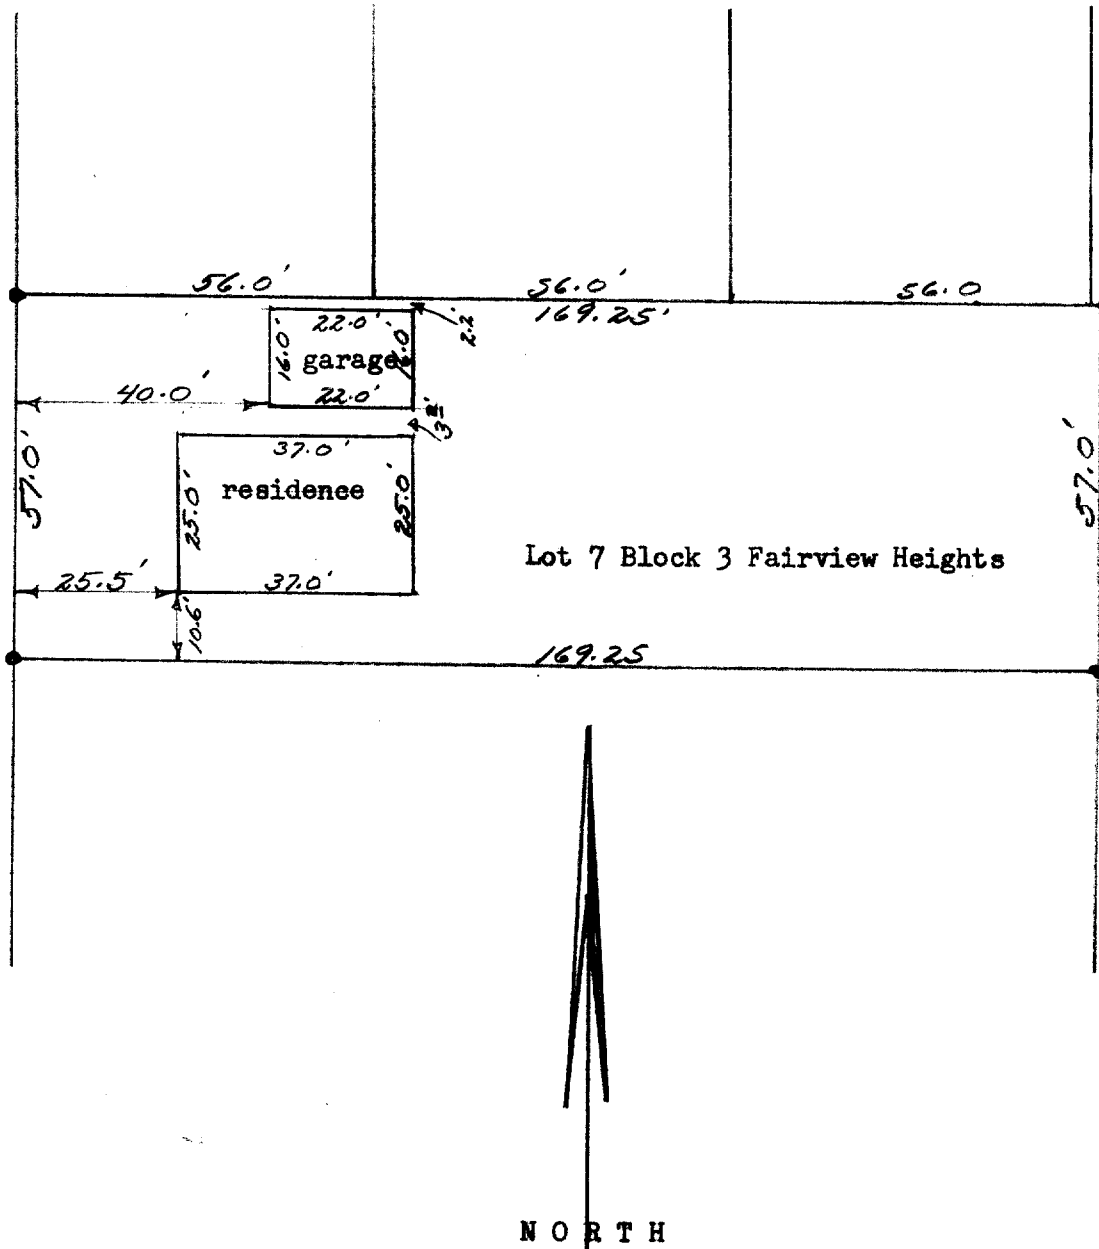


DESCRIPTION: Lot 7 Block 3 Fairview Heights in the City of Delavan, Walworth County, Wisconsin.

CERTIFICATE: I, hereby certify that I have surveyed the above mentioned property and that the hereon portrayed is an accurate survey and a true representation thereof and correctly shows the exterior boundary lines and the location of the buildings and the other improvements thereof.

Dated: January 25th 1967.

James E. Blagden, S. 272
Ellenhorn, Wisconsin

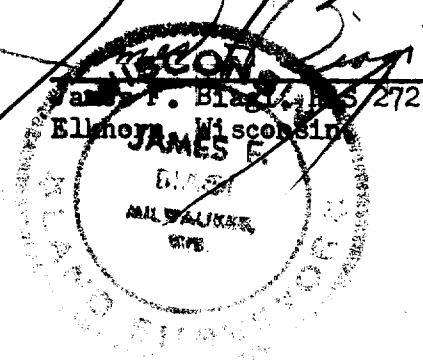

XFH-27

2-518