


GEORGE T. DUNHAM
SURVEYING & ENGINEERING
DELAVER, WISCONSIN

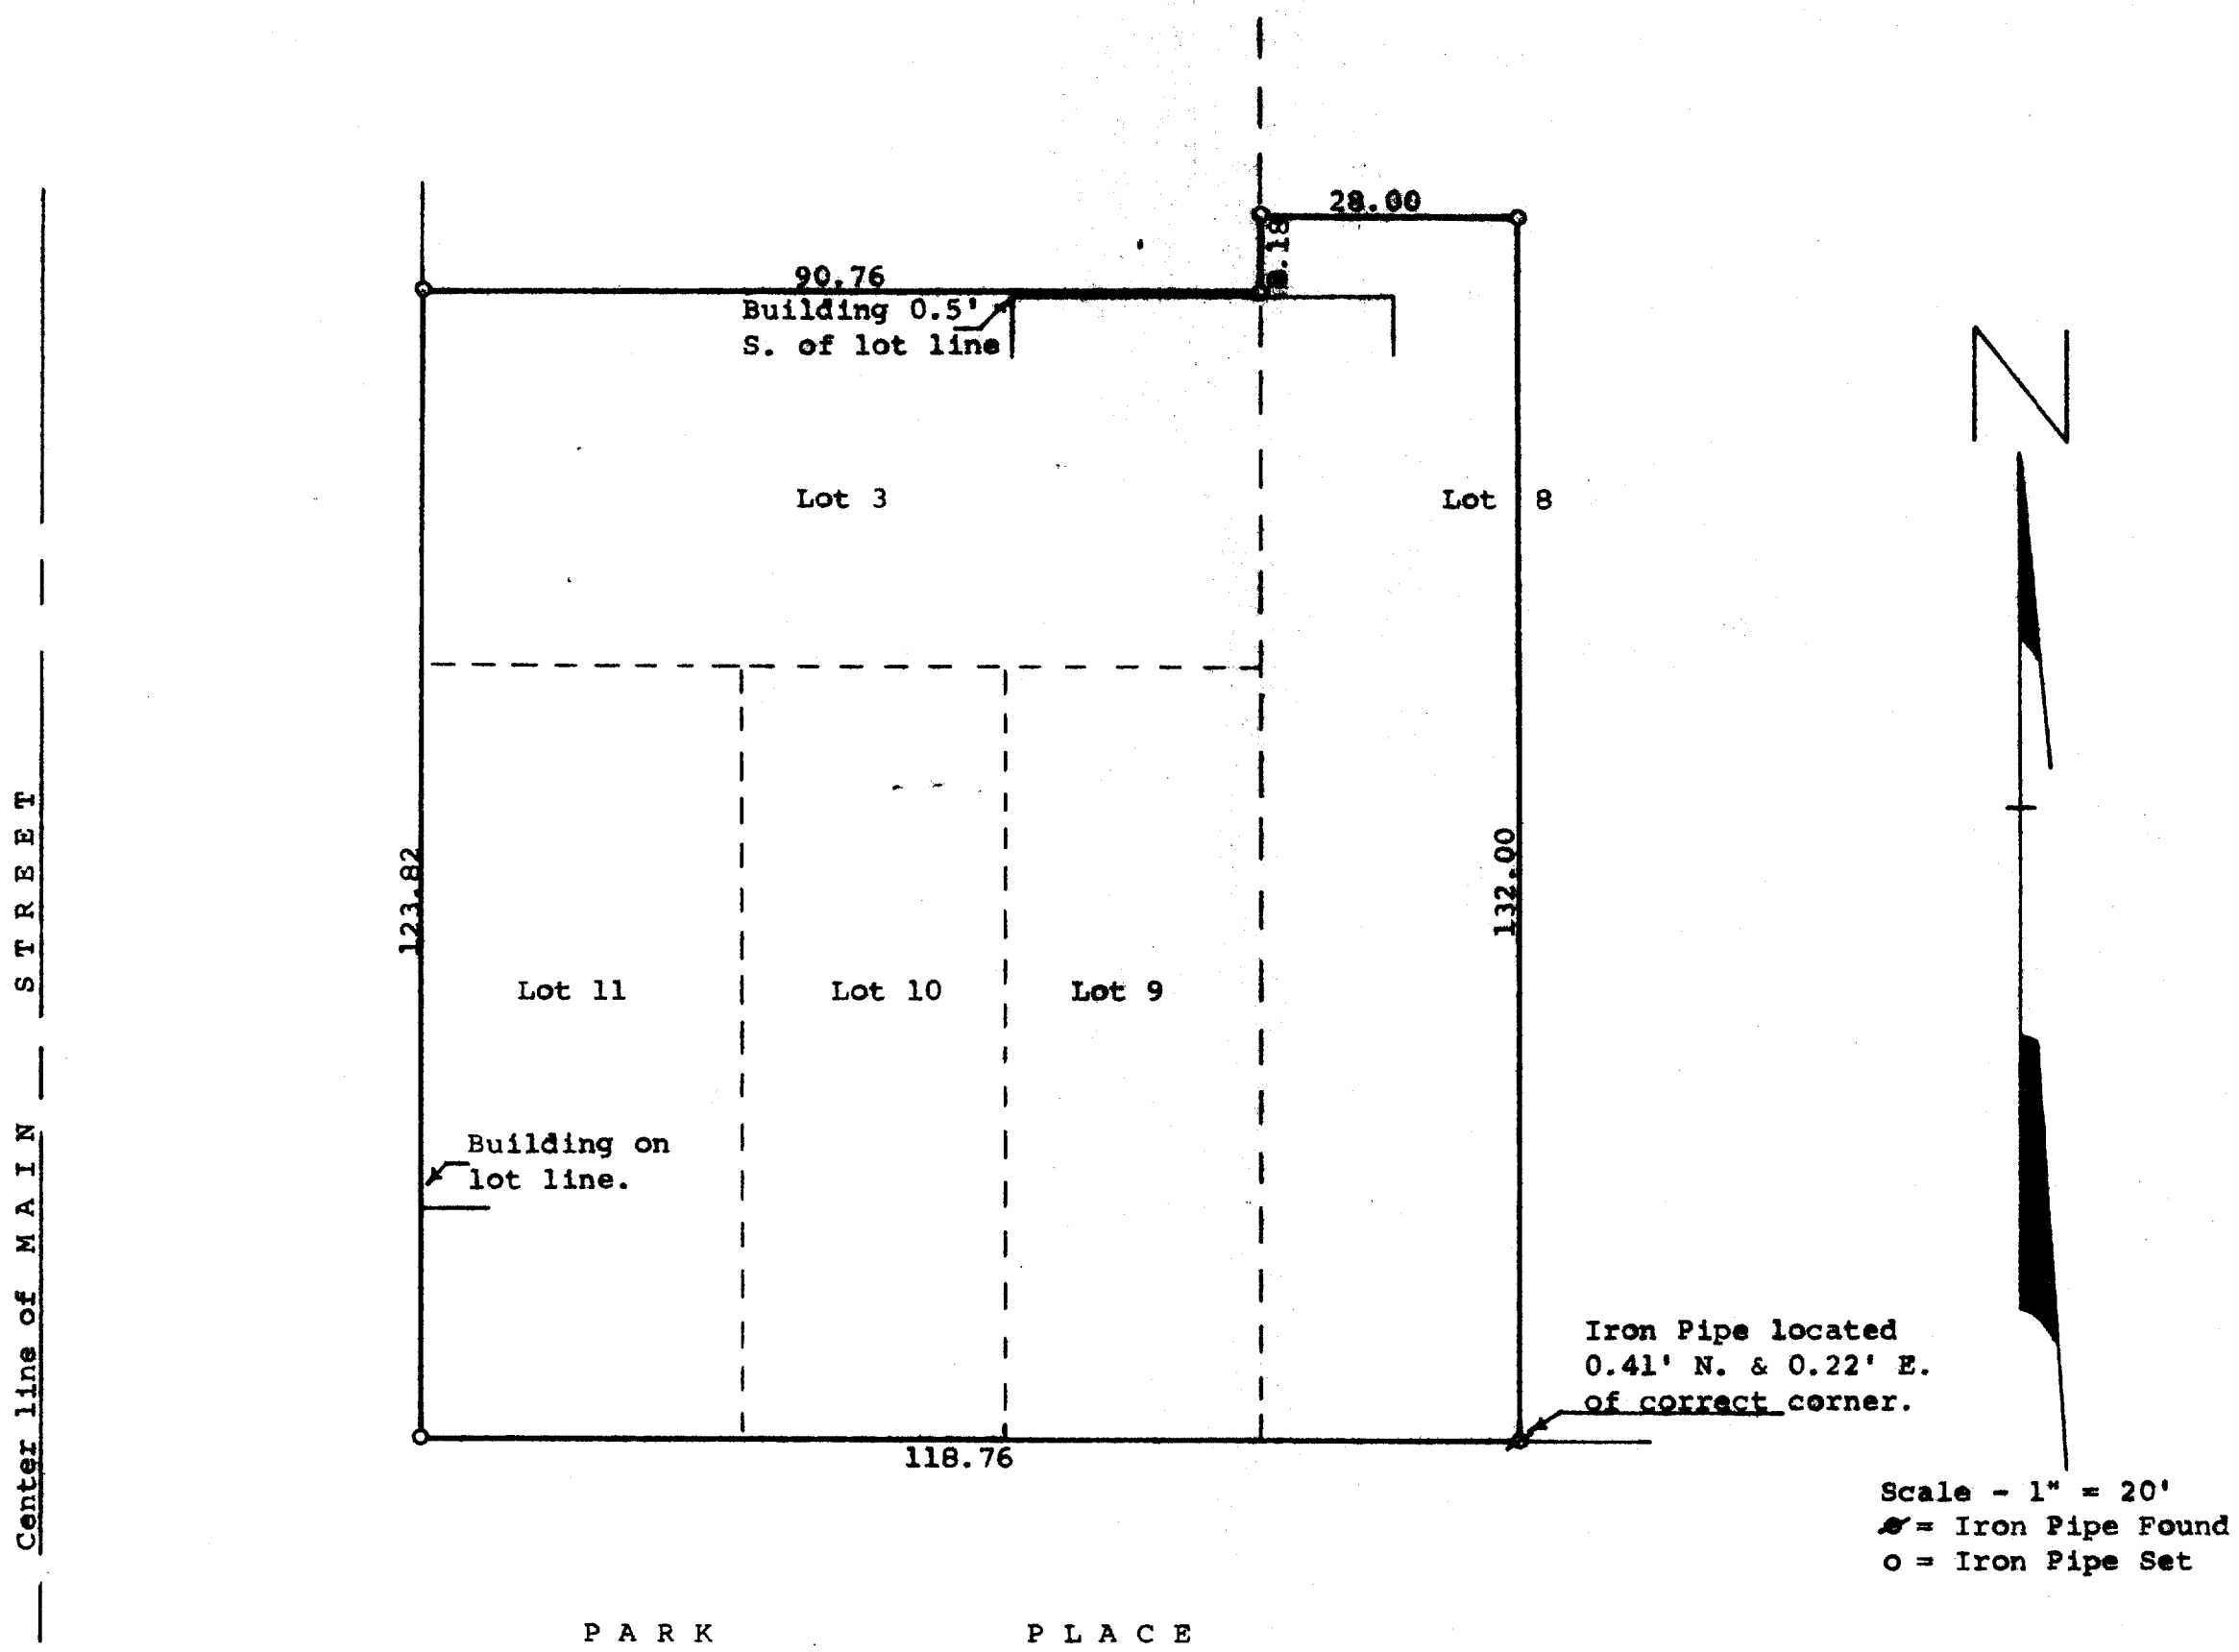

Plat of survey of Lots 9, 10, and 11 and part of
Lots 3 & 8, Block 8 of the Original Plat of the
Village (now City) of Delavan, Walworth County,
Wisconsin.
August 24, 1976

George T. Dunham
George T. Dunham, Surveyor

