


HAROLD H. KOLB
REGISTERED PROFESSIONAL LAND SURVEYOR
LAKE GENEVA, WISCONSIN

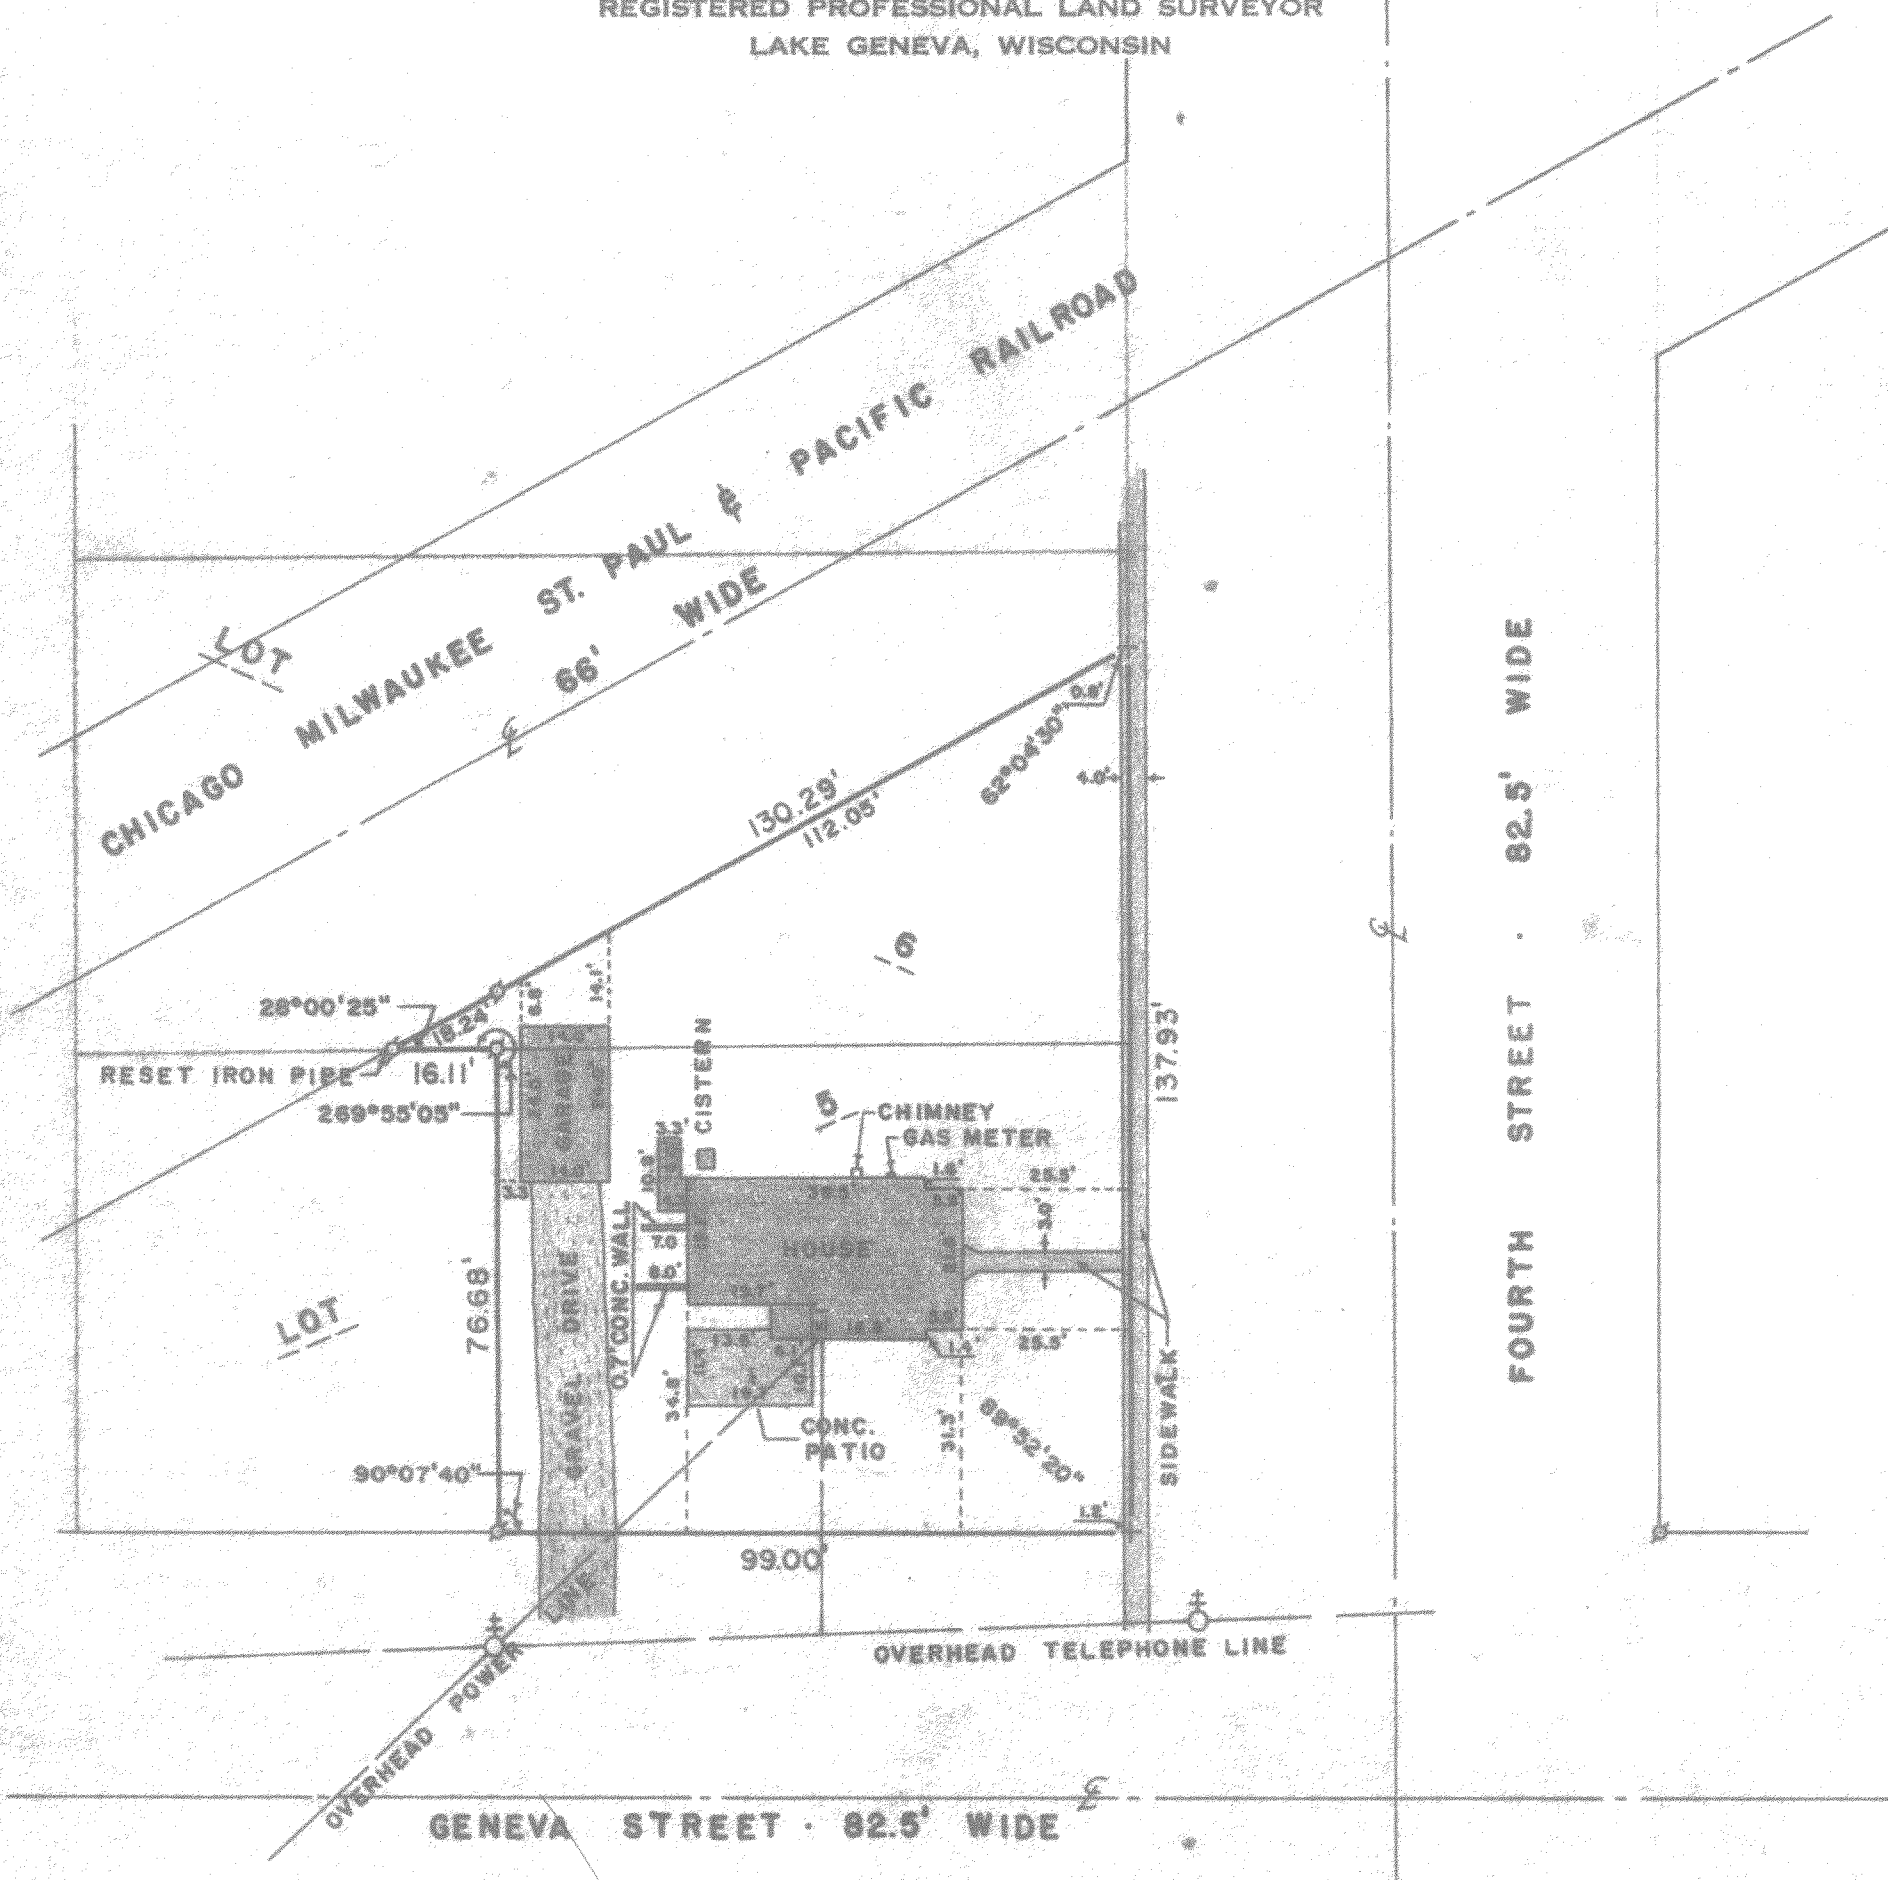

PLAT OF SURVEY OF

The East 99.00 feet of Lot 5 and that part of Lot 6 lying South of the Chicago, Milwaukee, St. Paul & Pacific Railroad right-of-way, Block 26, Ann Phoenix Addition to the City of Delavan, Walworth County, Wisconsin.

Ordered by: Hedlund Realty
39 N. Wisconsin
Elkhorn, WI.


Owner: Ronald Johnson

I have surveyed the above described property, and the above map is a true representation thereof and shows the size and location of the property, its exterior boundaries, the location and dimensions of all visible structures thereon, fences, apparent easements, roadways and visible encroachments.

This survey is made for the exclusive use of the present owners of the property; also those who purchase, mortgage or guarantee the title thereto, within one year from date hereof.



- LEGEND**
- φ — IRON PIPE FOUND
 - — IRON PIPE PLACED
 - — CONCRETE MONUMENT
 - + — CUT CROSS

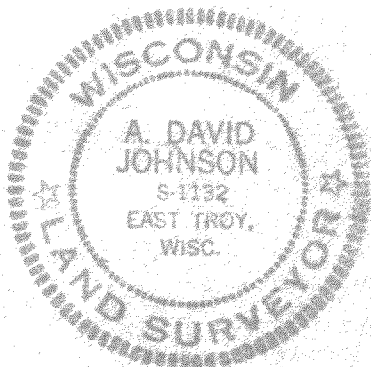

I, A. DAVID JOHNSON, DO HEREBY CERTIFY THAT I HAVE SURVEYED THE PROPERTY HEREON DESCRIBED ACCORDING TO THE OFFICIAL RECORDS, AND THAT THE PLAT HEREON IS A CORRECT REPRESENTATION OF THE LOT LINES.

A. David Johnson
A. DAVID JOHNSON
WISCONSIN REGISTERED LAND SURVEYOR, 5-1132
DATE DECEMBER 3, 1976

2-538