


DUNHAM SURVEYING, S.C.
SURVEYING & SUBDIVIDING
DELAVAN, WISCONSIN 53115

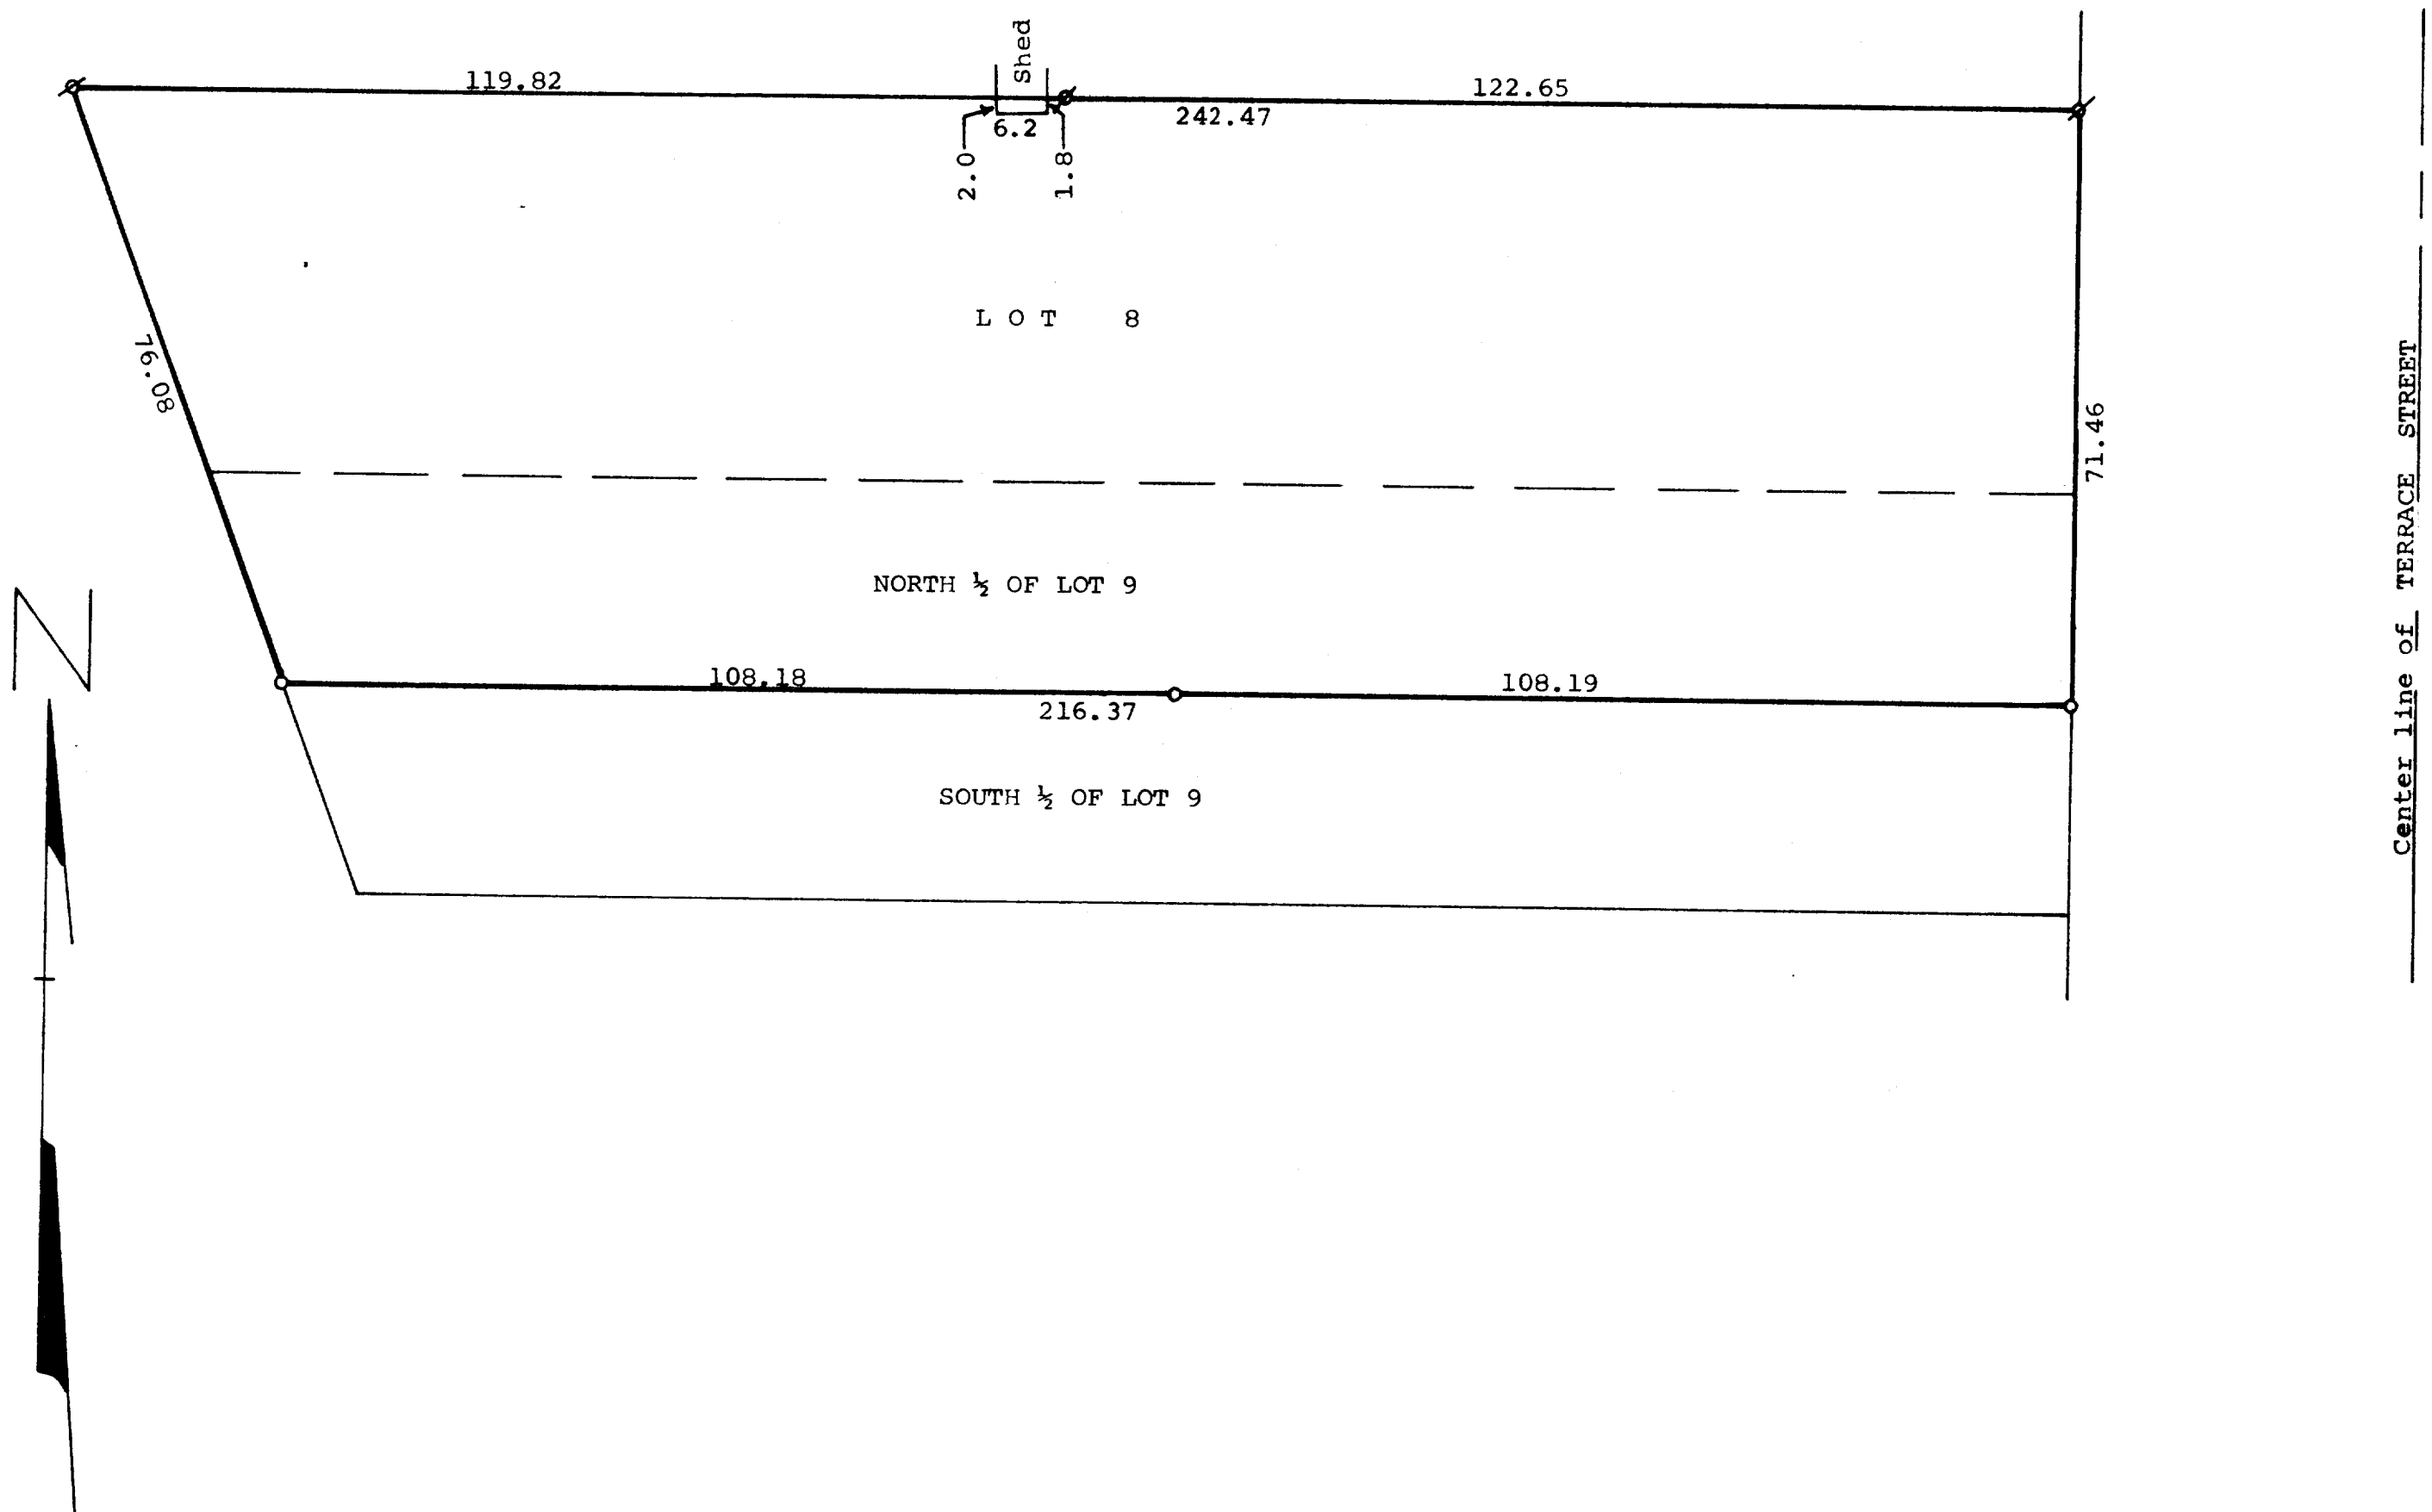

Scale - 1" = 20'
X = Iron Pipe Found
O = Iron Pipe Set

Plat of survey of a parcel of land described as follows:
Lot 8 and the North 1/2 of Lot 9 of L. E. Downie's Addition
to the Village (now City) of Delavan, Walworth County,
Wisconsin.
August 1, 1977

James M. Dunham
James M. Dunham, Surveyor

