


BRADLEY

AVENUE

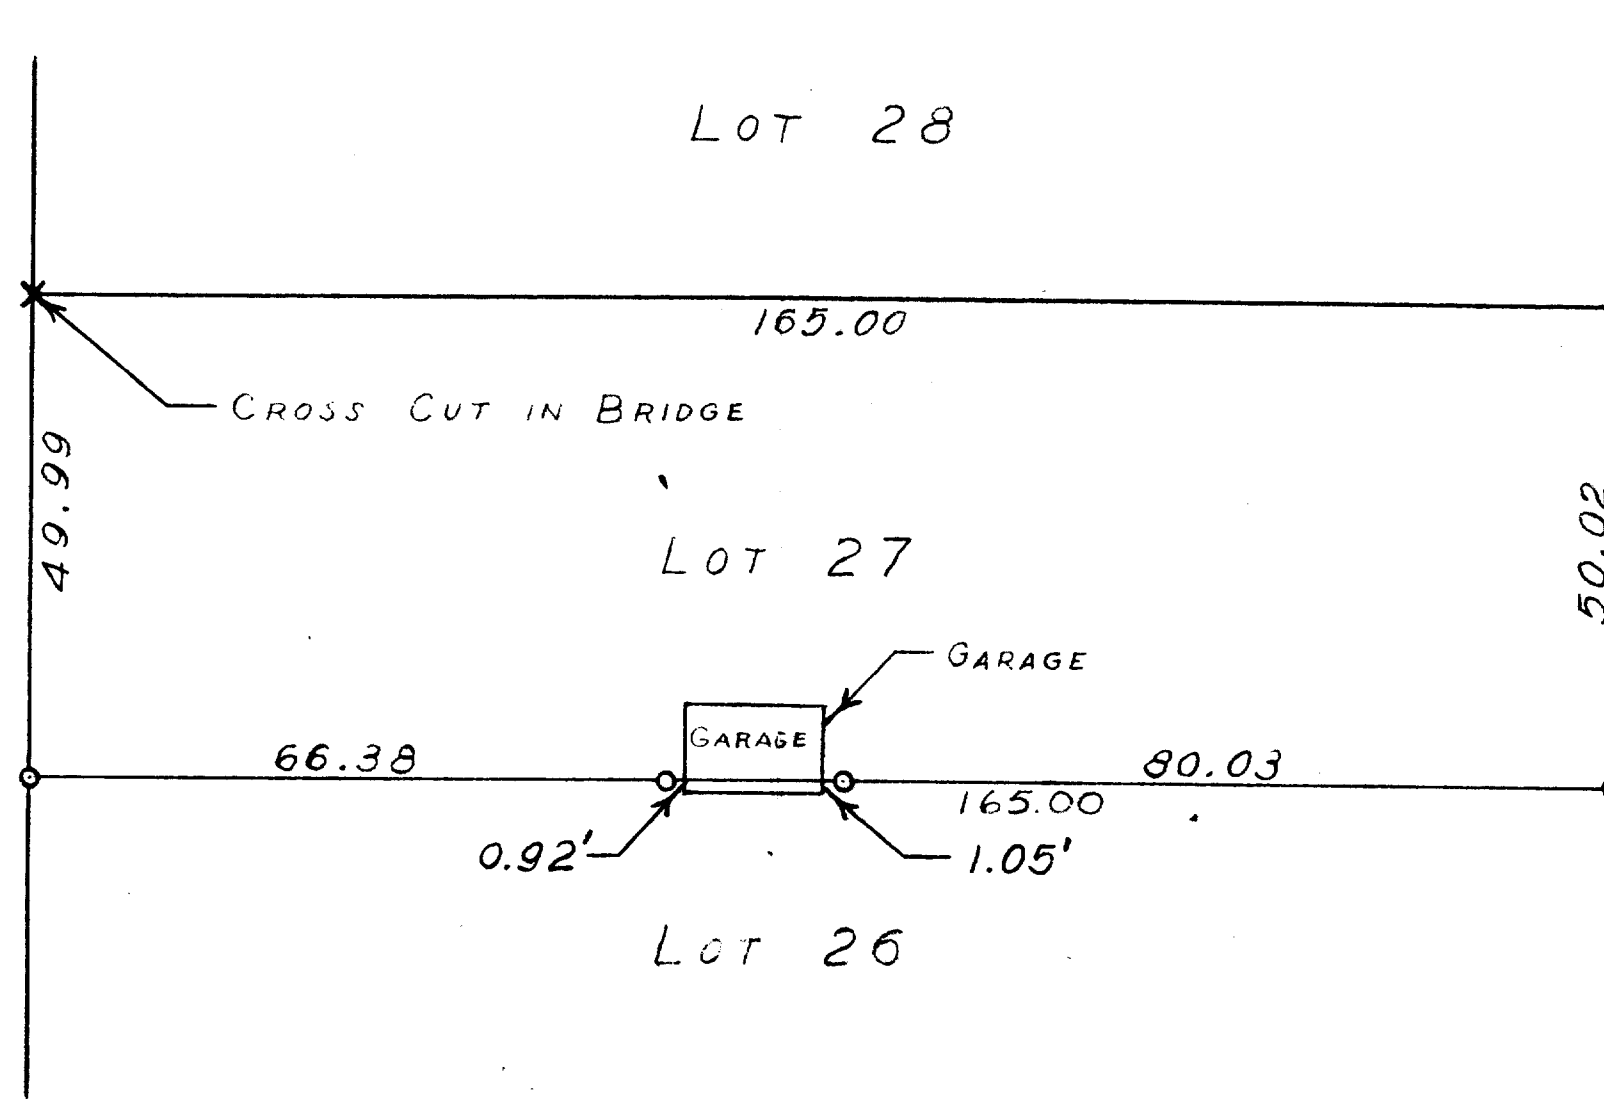

SCALE ~ 1" = 20'
O = IRON PIPE

PLAT OF SURVEY OF LOT 27, TYRRELLS SUBDIVISION, CITY OF
DELAHAN, WALWORTH COUNTY, WISCONSIN
MAY 24, 1954

George T. Dunham
GEORGE T. DUNHAM, SURVEYOR
DELAHAN, WISCONSIN

2-56