


DUNHAM SURVEYING, S.C.
SURVEYING & SUBDIVIDING
DELAVAN, WISCONSIN 53115

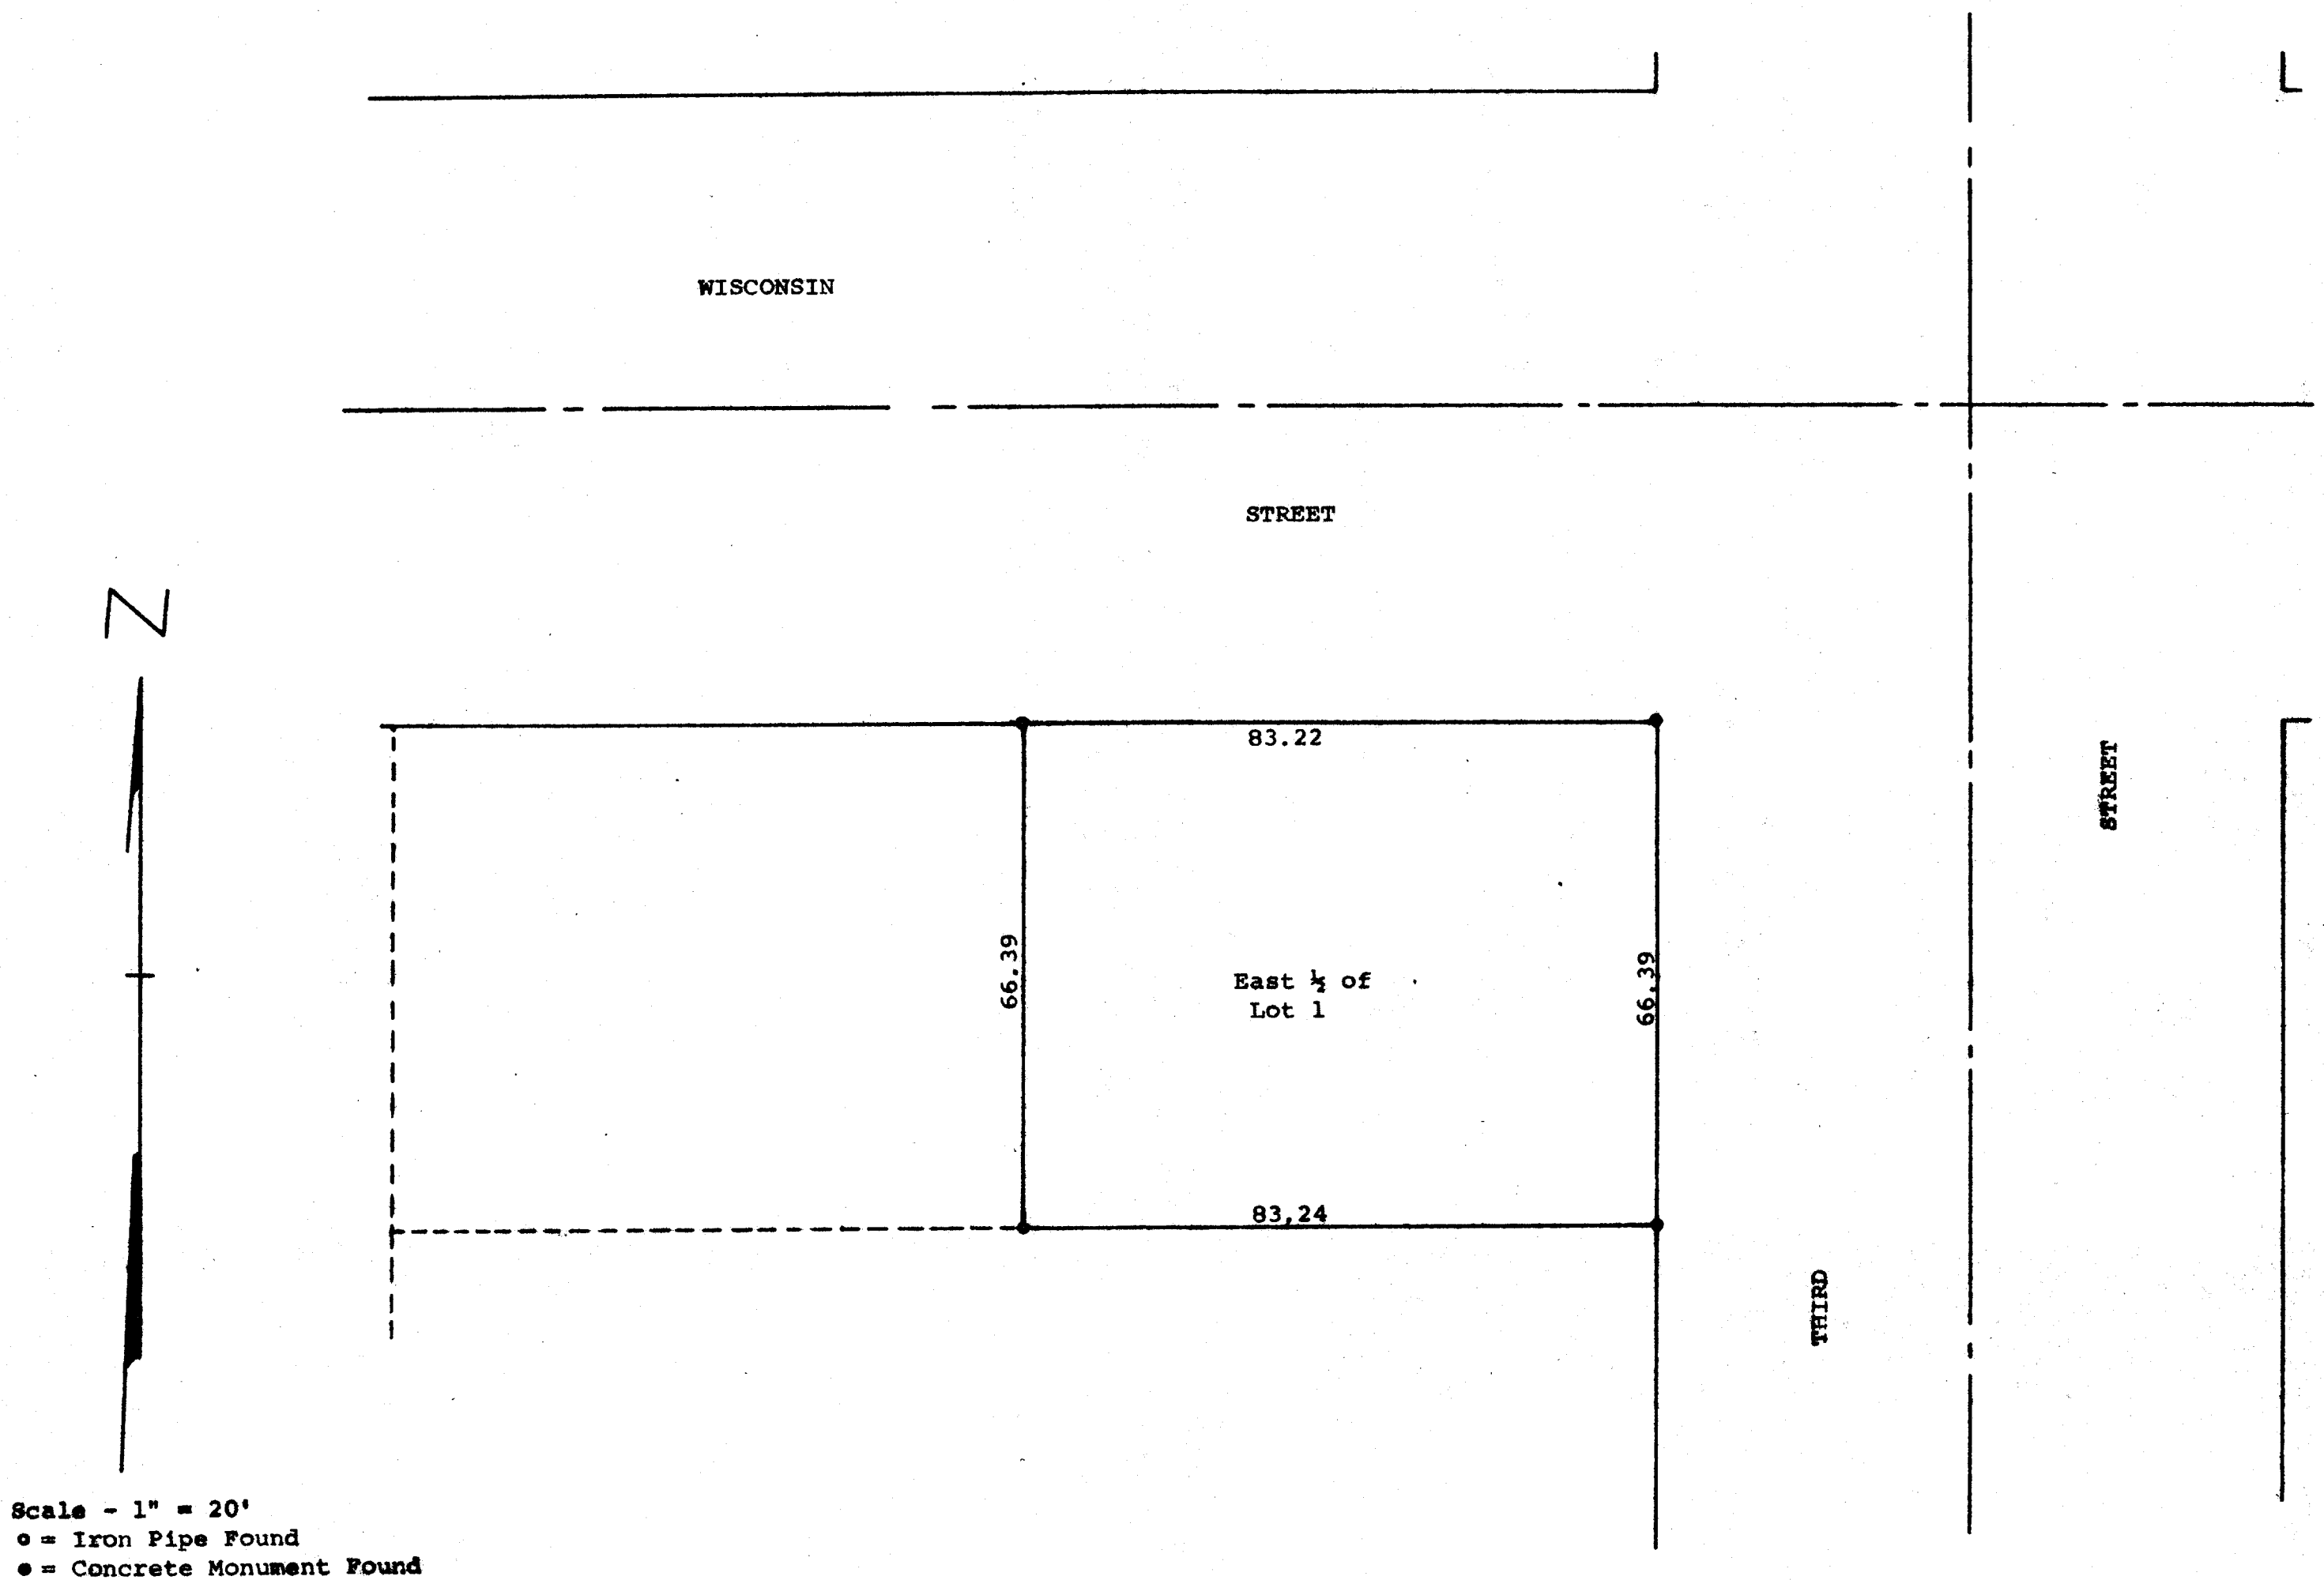

Plat of survey of a parcel of land described as follows:
The East 1/2 of Lot 1, Block 20 of the Original Plat of the
Village (Now City) of Delavan, Walworth County, Wisconsin.
July 1, 1977

George T. Dunham
George T. Dunham, Surveyor

