


N
 SCALE=1"=20'
 O=IRON PIPE
 ●=CONC. MONU.

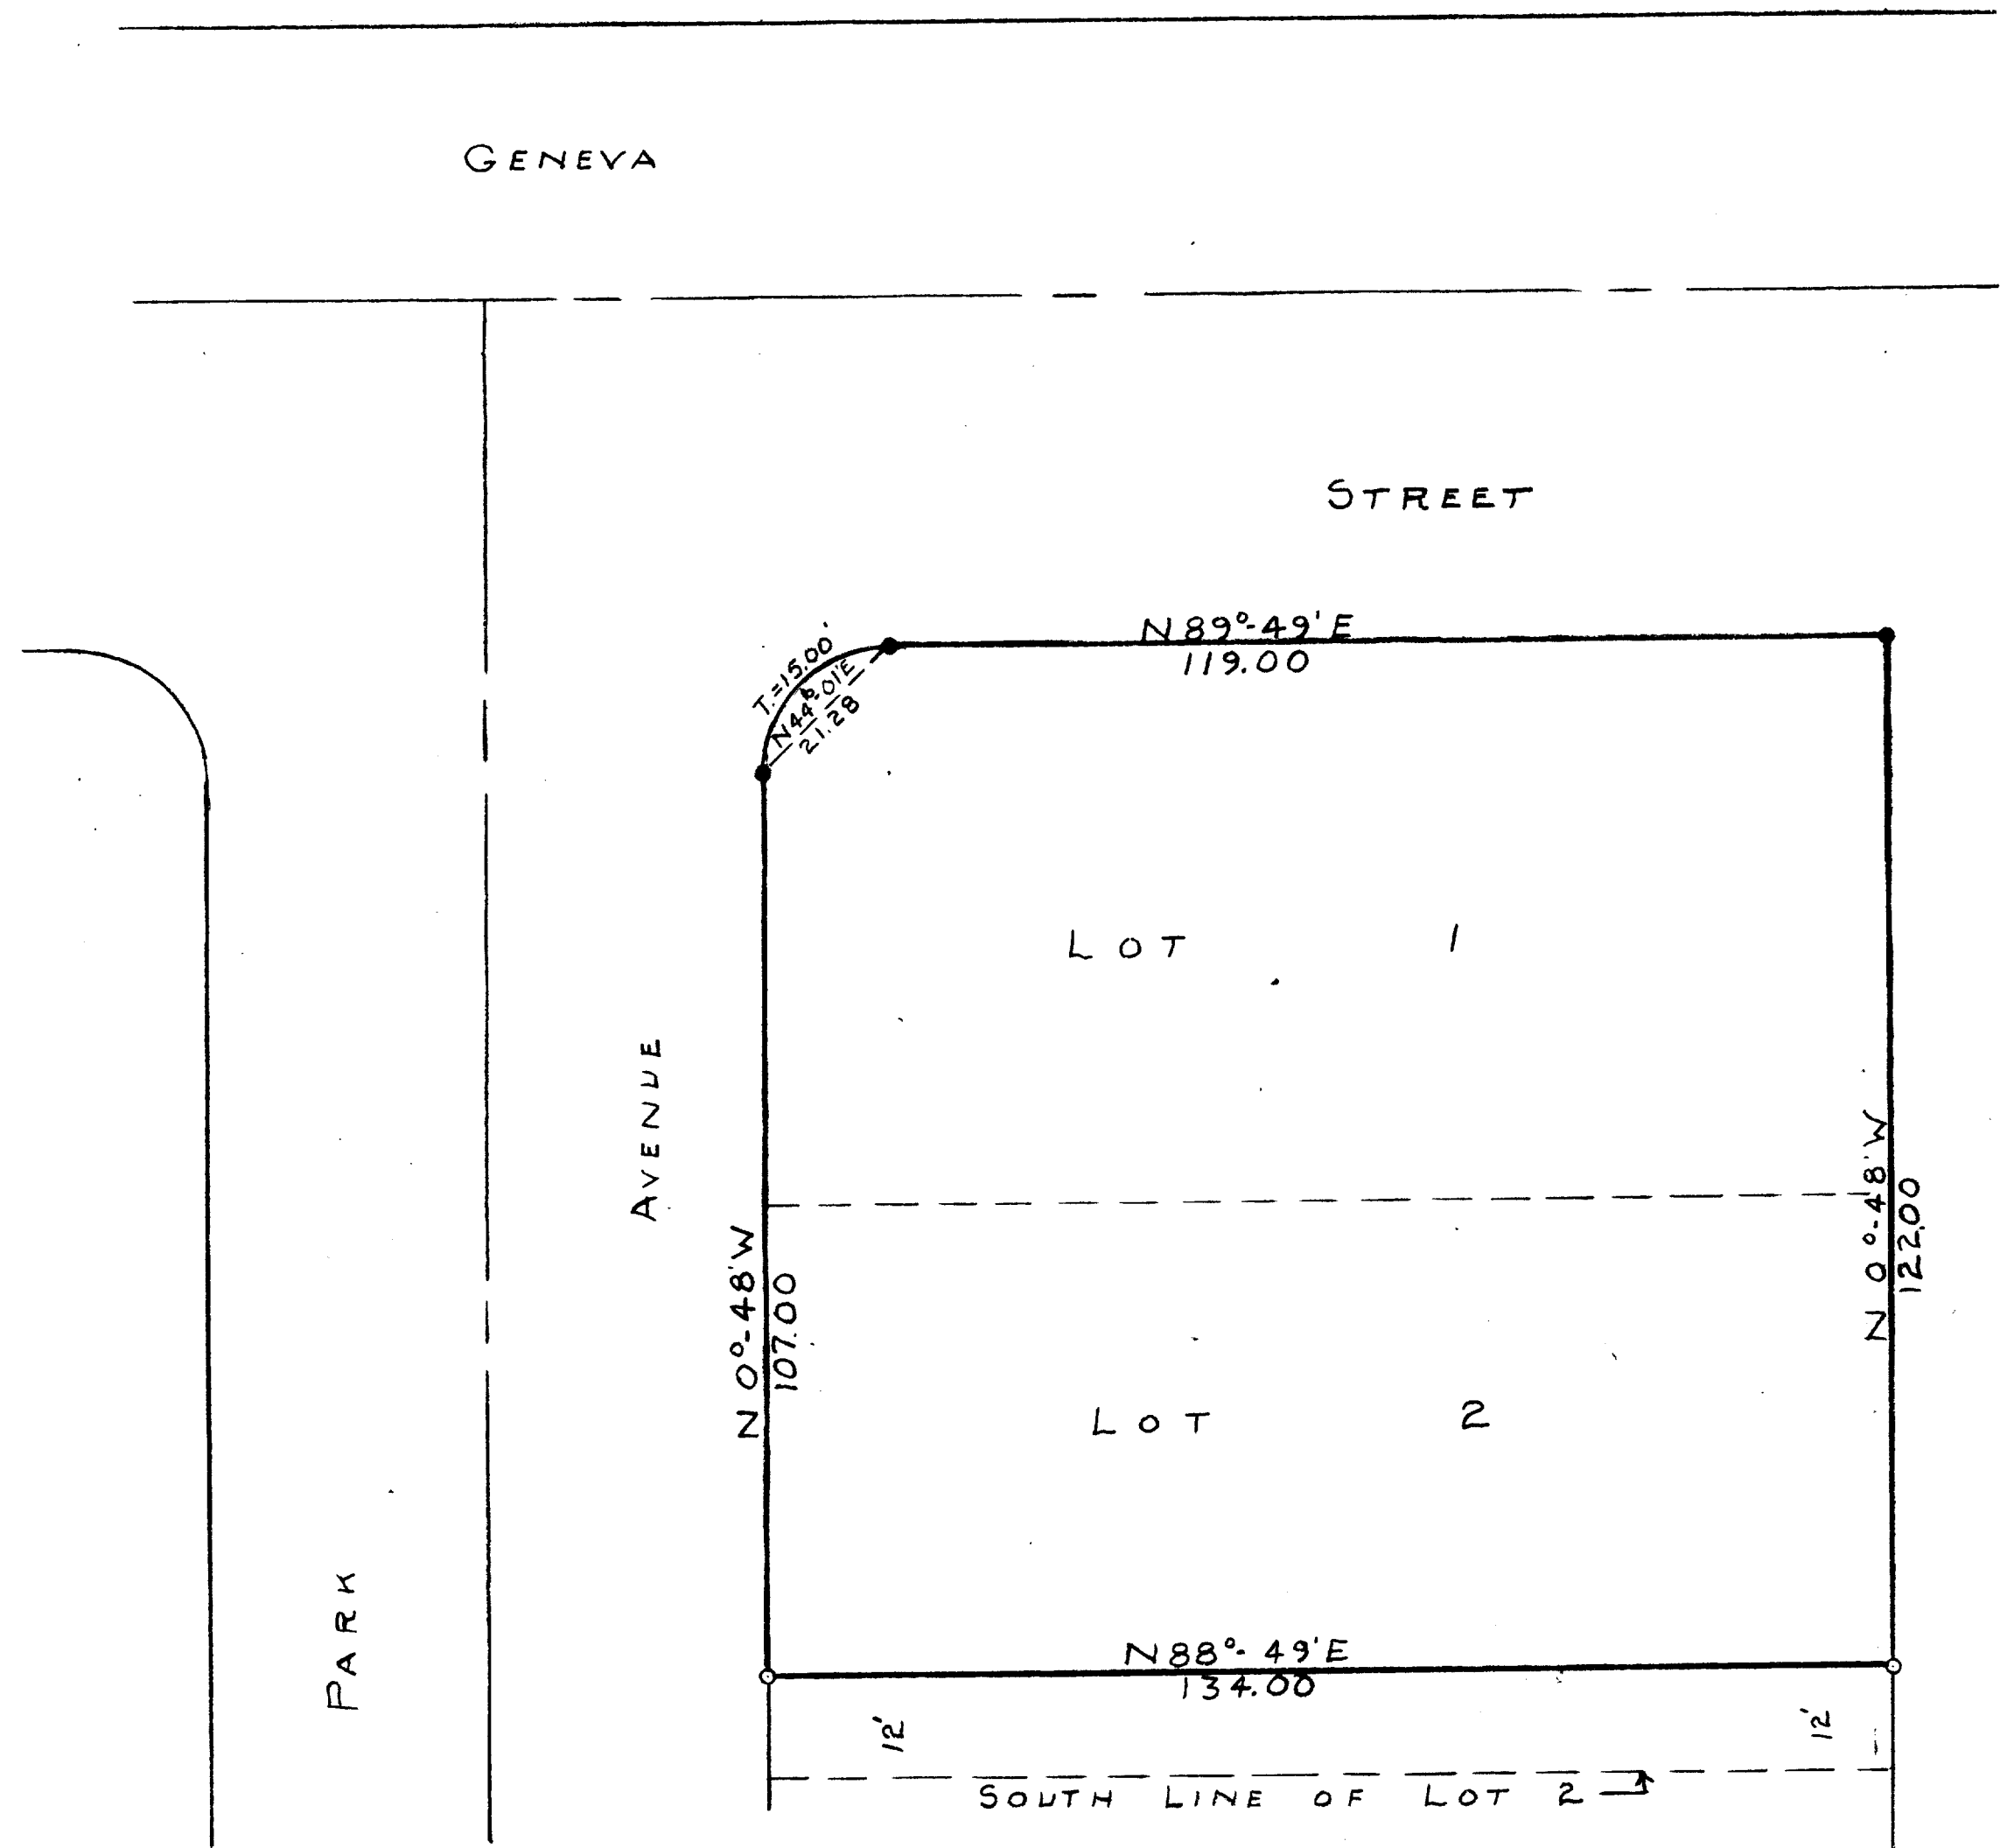

PLAT OF SURVEY OF LOTS 1 AND 2, BLOCK 2 OF SOUTH PARK SUBDIVISION
 LOCATED IN THE CITY OF DELAVAN, WALWORTH COUNTY, WISCONSIN EXCEPTING
 THEREFROM THE SOUTH 12.00 FEET OF SAID LOT 2.
 APRIL 6, 1956

George T. Dunham
 GEORGE T. DUNHAM, SURVEYOR
 DELAVAN, WISCONSIN 2-58