


DUNHAM SURVEYING, S.C.
SURVEYING & SUBDIVIDING
DELAVAN, WISCONSIN 53115

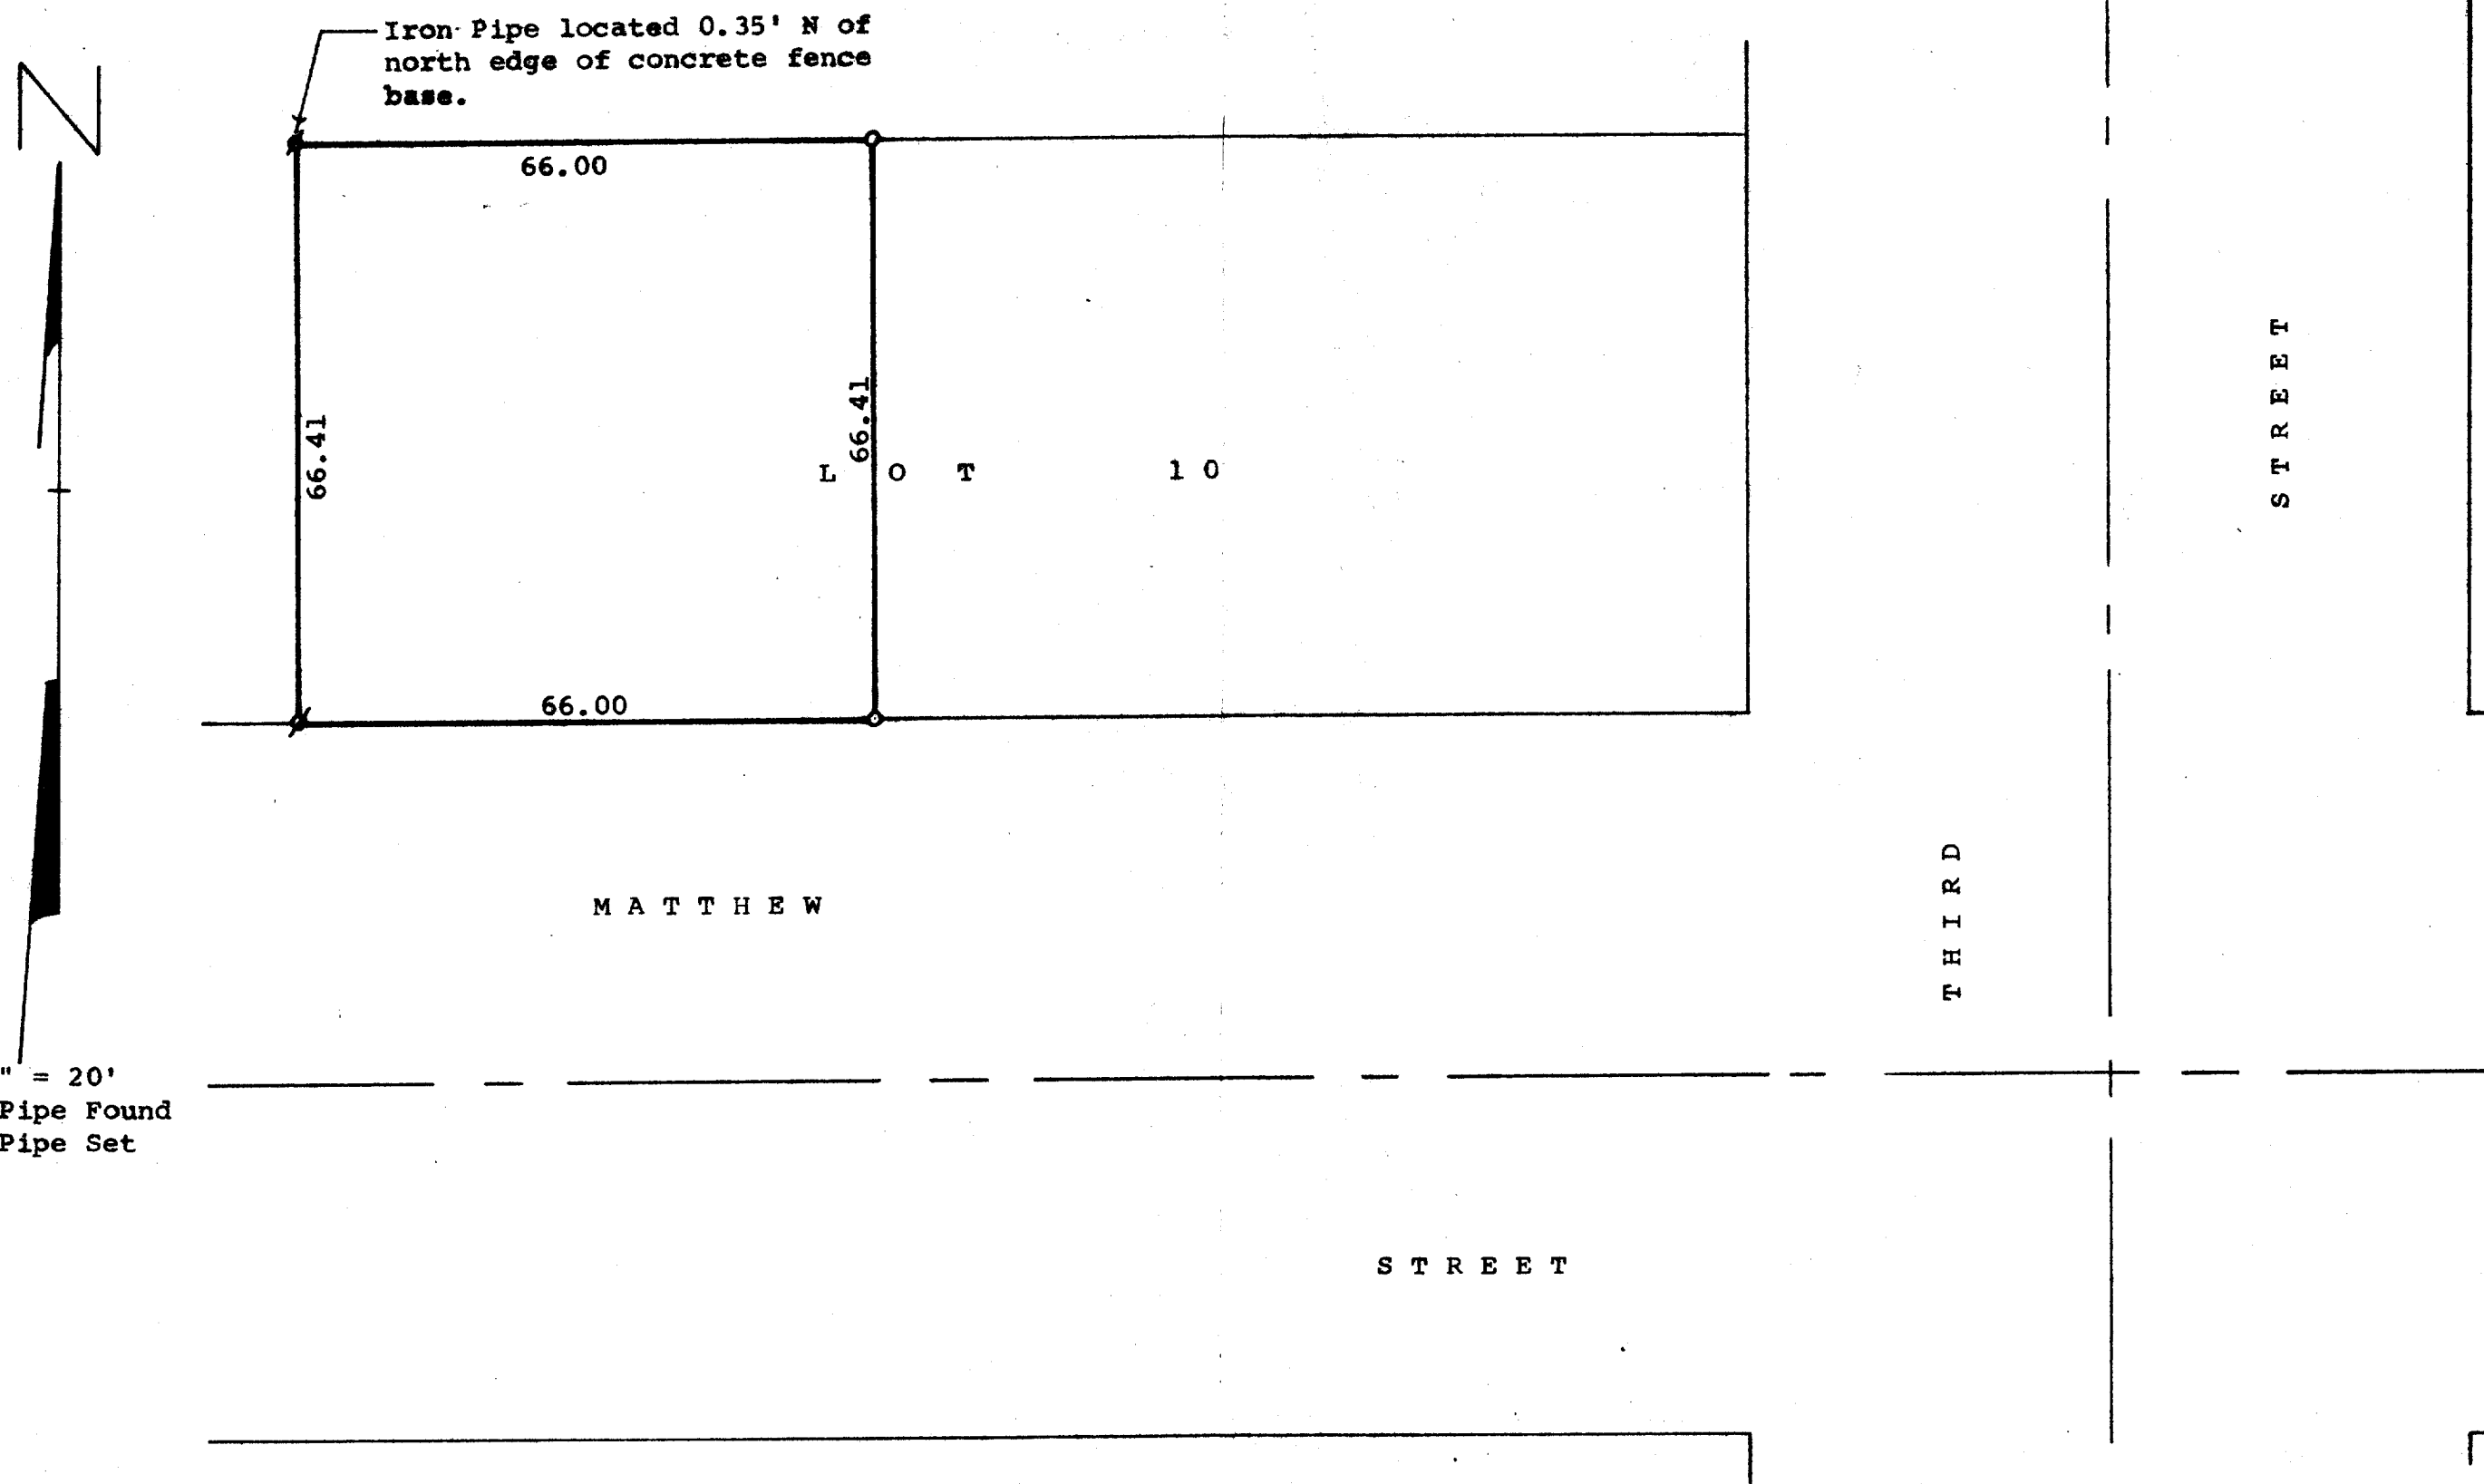

Scale - 1" = 20'
⊘ = Iron Pipe Found
o = Iron Pipe Set

Plat of survey of:
The West 4 rods of Lot 10 in Block 21 of the
Original Plat of the Village (now City) of
Delavan, Walworth County, Wisconsin.
June 23, 1978

James M. Dunham
James M. Dunham, Surveyor

