


CL OF GENEVA STREET

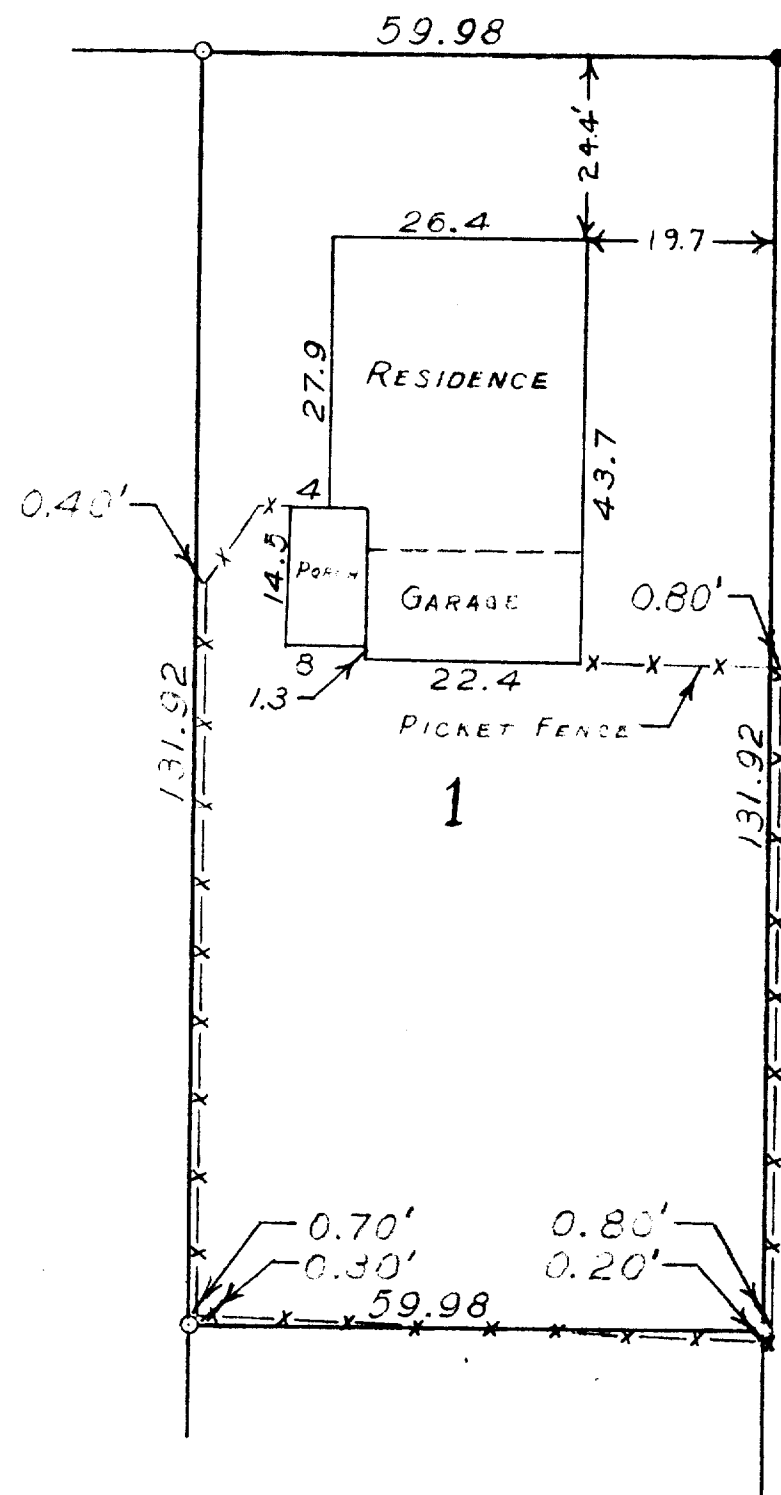

STREET

SIXTH

N

SCALE ~ 1" = 20'
 ● = CONC. MON.
 ○ = IRON PIPE

STATE OF WISCONSIN)
 COUNTY OF WALWORTH) SS

I, GEORGE T. DUNHAM, DO HEREBY CERTIFY THAT I HAVE SURVEYED THE
 PROPERTY DESCRIBED AS FOLLOWS:

LOT 1, BLOCK 4 OF FAIRVIEW HEIGHTS ADDITION LOCATED IN THE CITY
 OF DELAVAN, WALWORTH COUNTY, WISCONSIN
 AND THAT THE PLAT SHOWN ABOVE IS A CORRECT REPRESENTATION OF THE
 PROPERTY LINES AND OF THE PRINCIPLE LINES OF THE BUILDINGS THEREON.
 JULY 19, 1956

George T. Dunham
 GEORGE T. DUNHAM, SURVEYOR
 DELAVAN, WISCONSIN

2-59