



SURVEYING & SUBDIVIDING
DELAN, WISCONSIN 53115

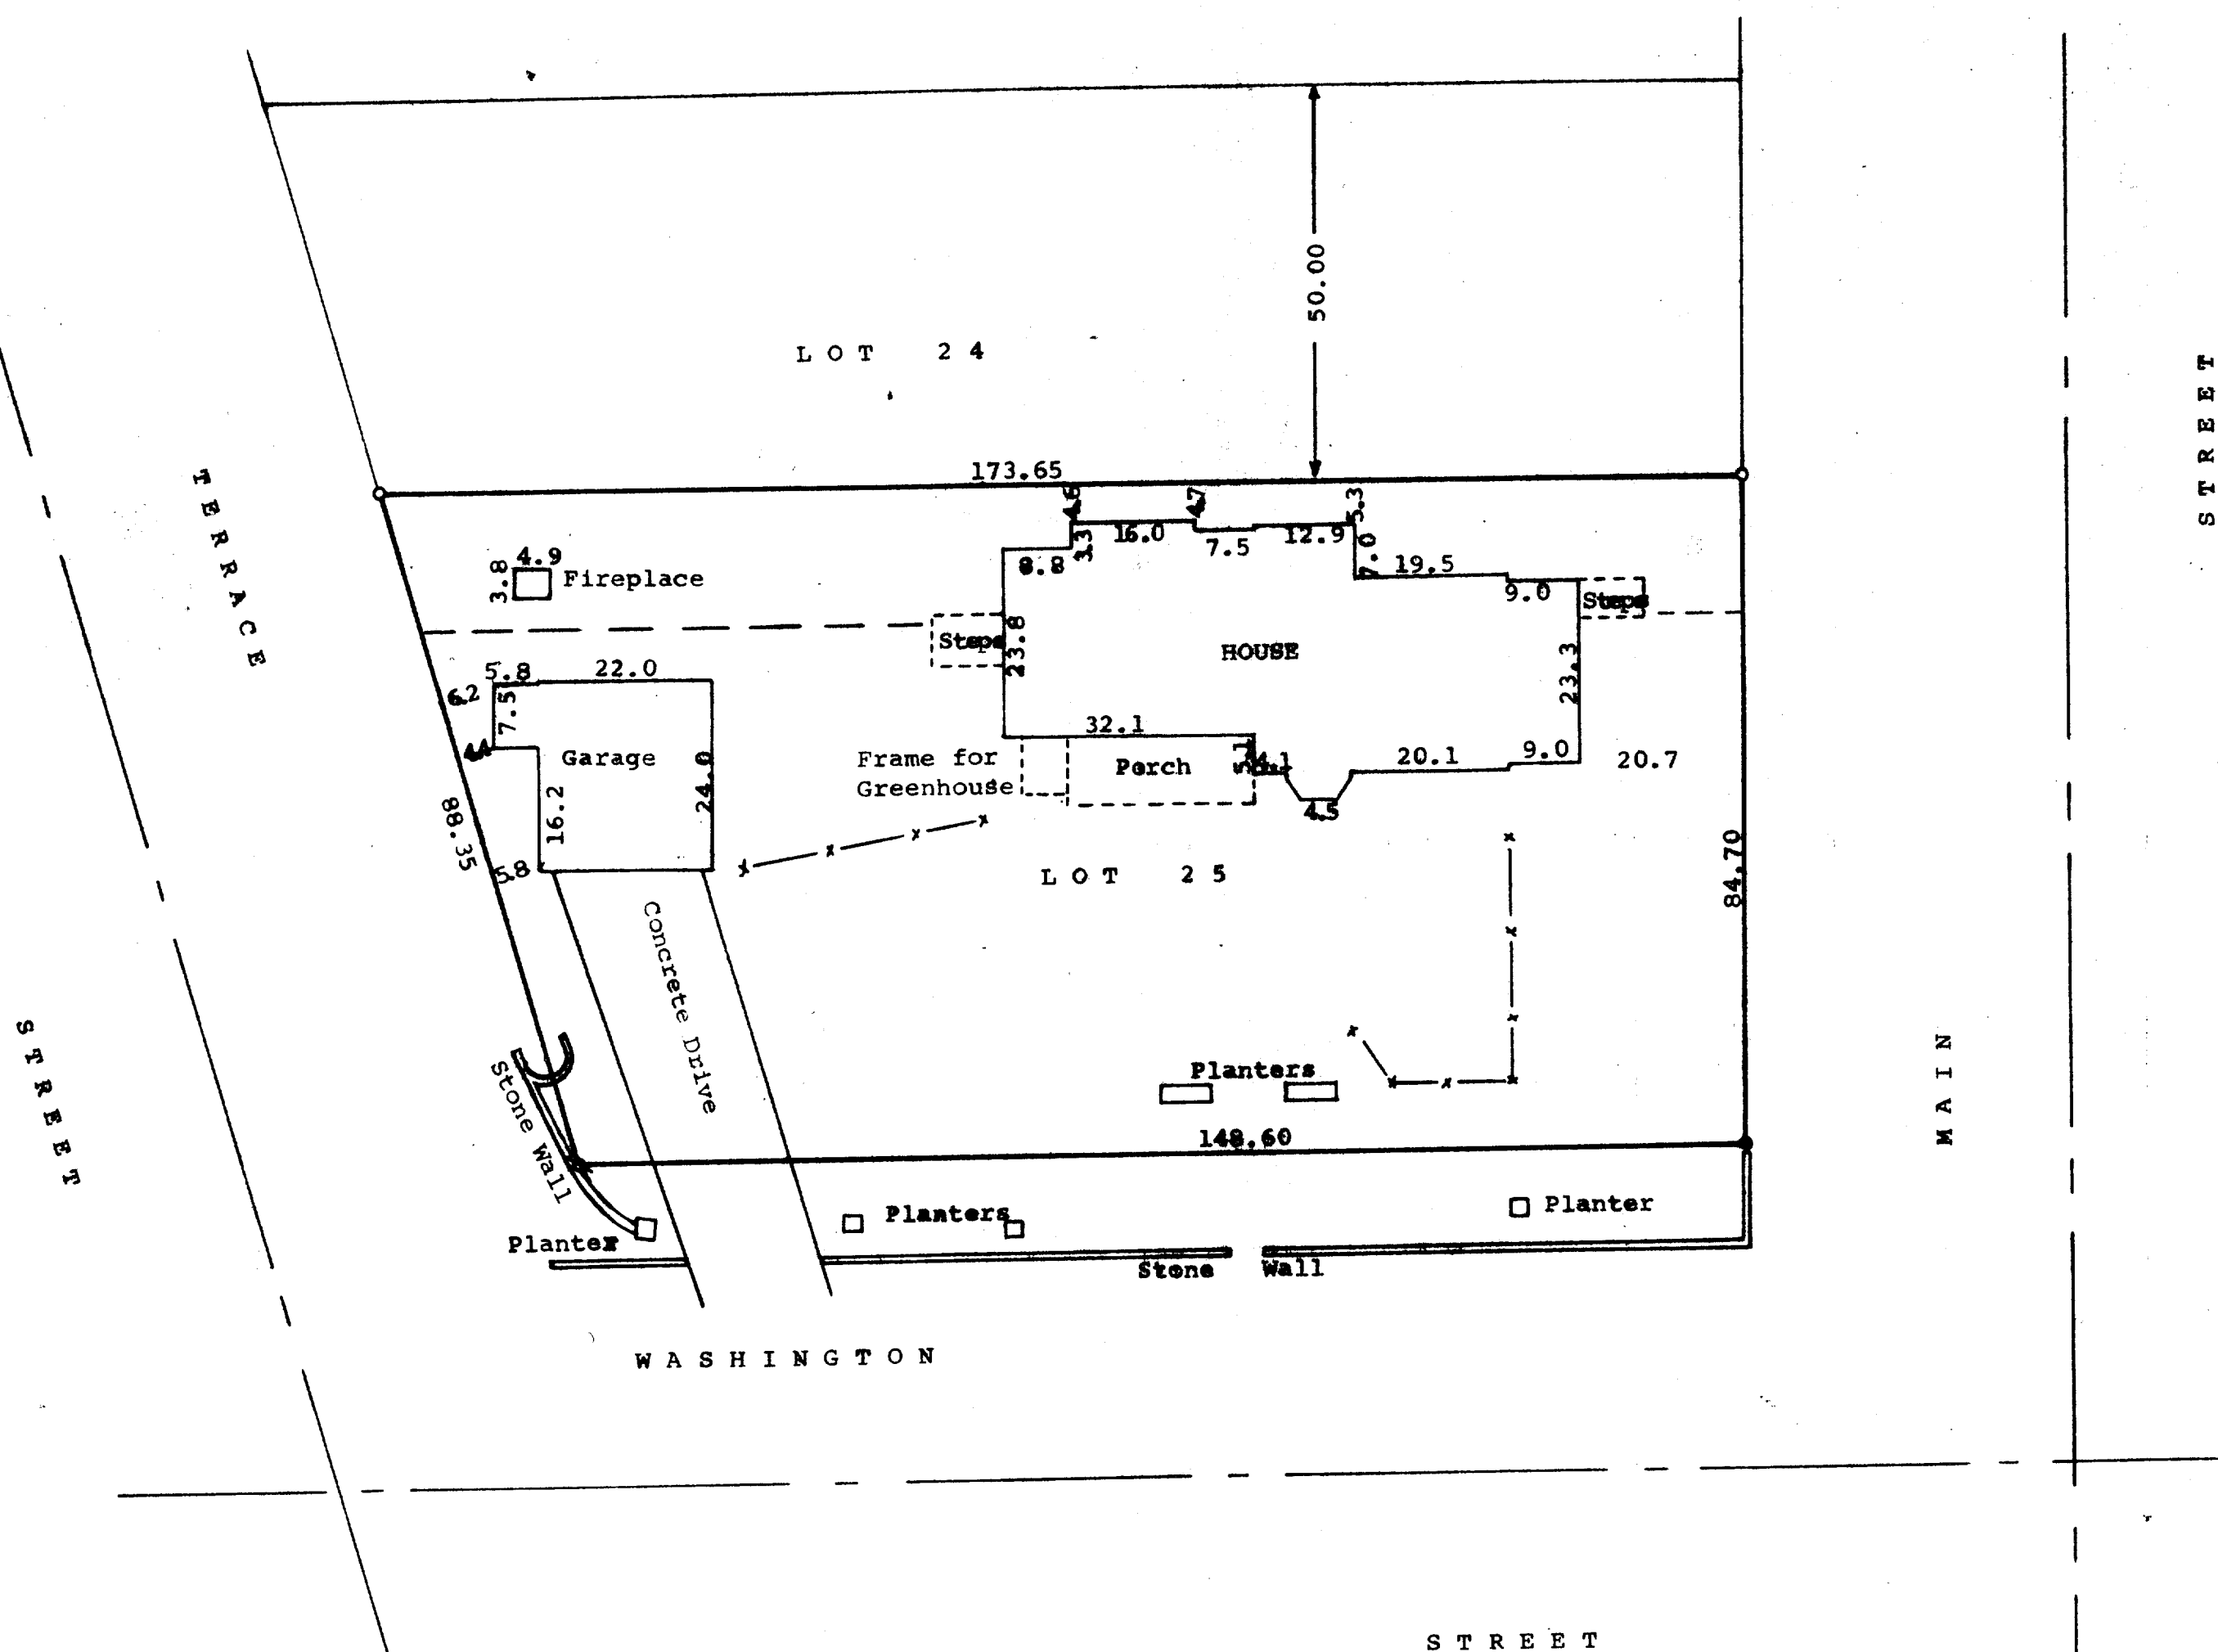

James M. Dunham
James M. Dunham, Surveyor

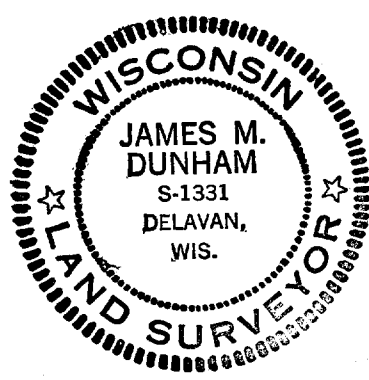

$-x \longrightarrow x - =$ Fence line