


DUNHAM SURVEYING, S.C.
SURVEYING & SUBDIVIDING
DELAVER, WISCONSIN 53115

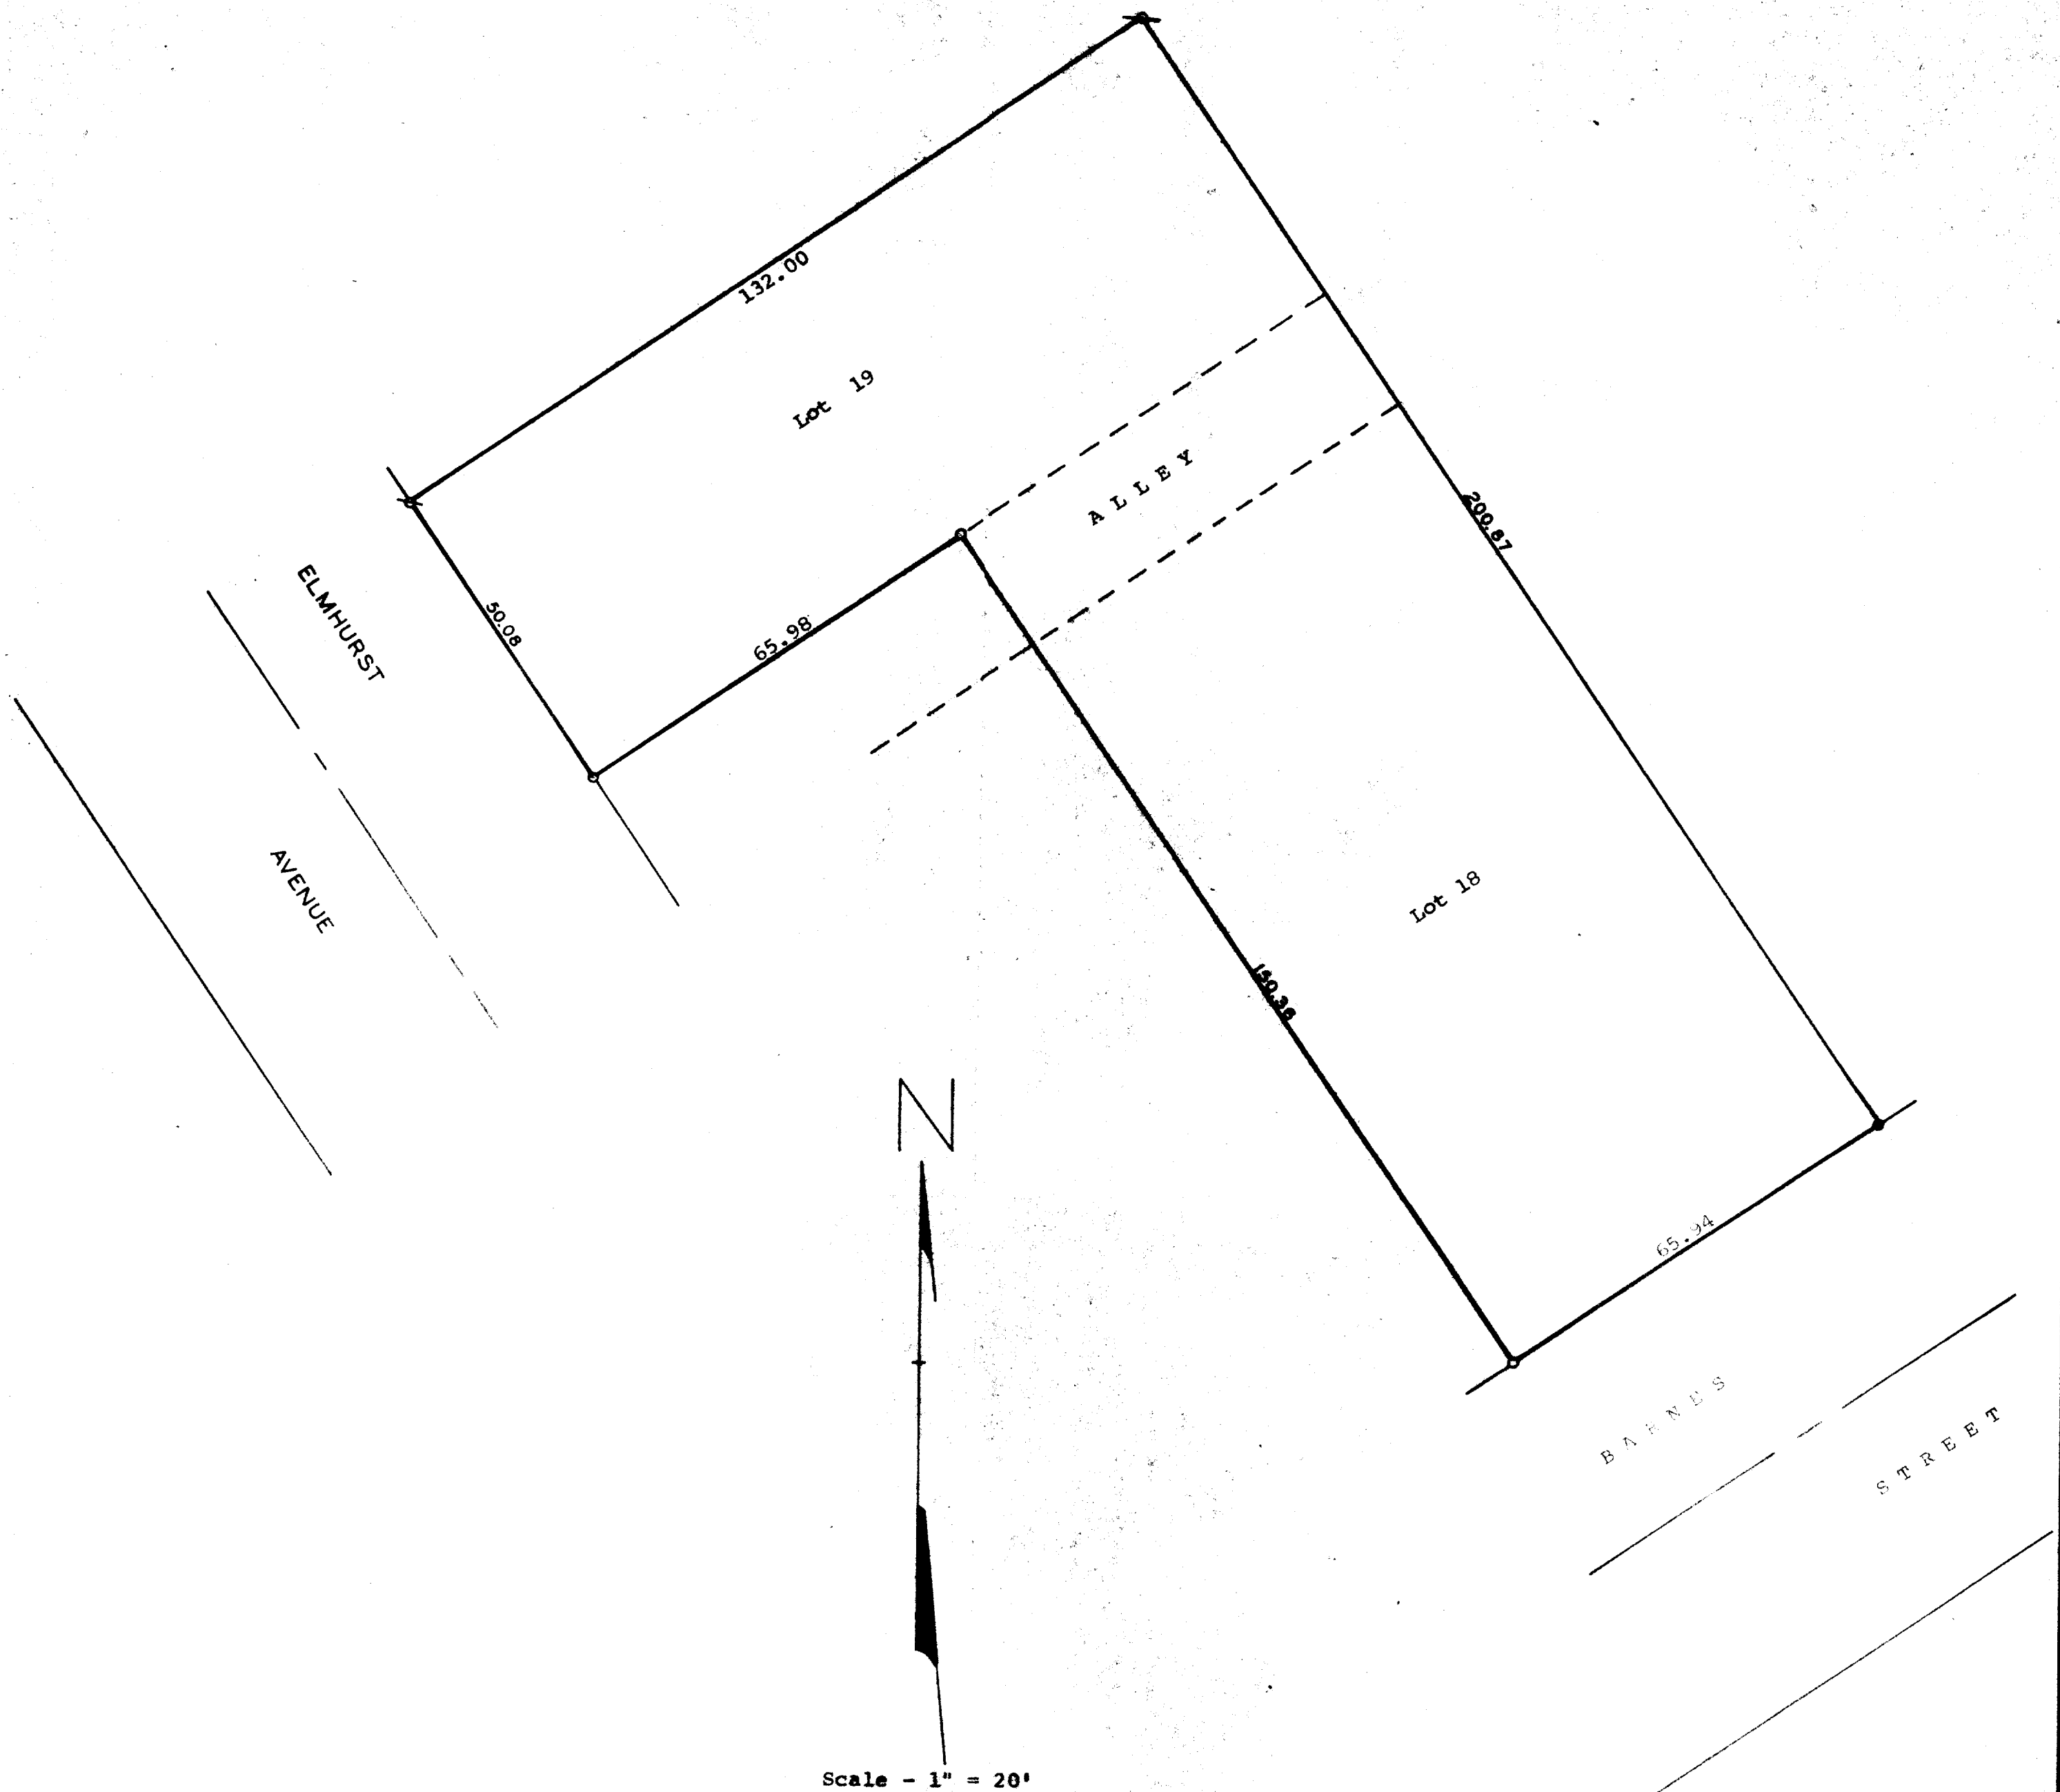

Scale - 1" = 20'
● = Concrete Monument
✕ = Iron Pipe Found
○ = Iron Pipe Set

Plat of survey of:
Lots 18 and 19 and the Easterly 66 feet of a 20 foot wide
Alley located north of said Lot 18, all in Banning's
Subdivision, in the City of Delavan, Walworth County,
Wisconsin.
April 27, 1978

James M. Dunham
James M. Dunham, Surveyor

